
184

Exc.

Recap.	City
202.6	0
217.8	
176.3	
168.6	
53.8	
78.8	
89.5	
919.4	
+10%	
1011.3	cu. yds.

Re Xsection BK-K8

BM 1626 "M" in Mueller F. Hyd. NW Cor. Lightner & Morris

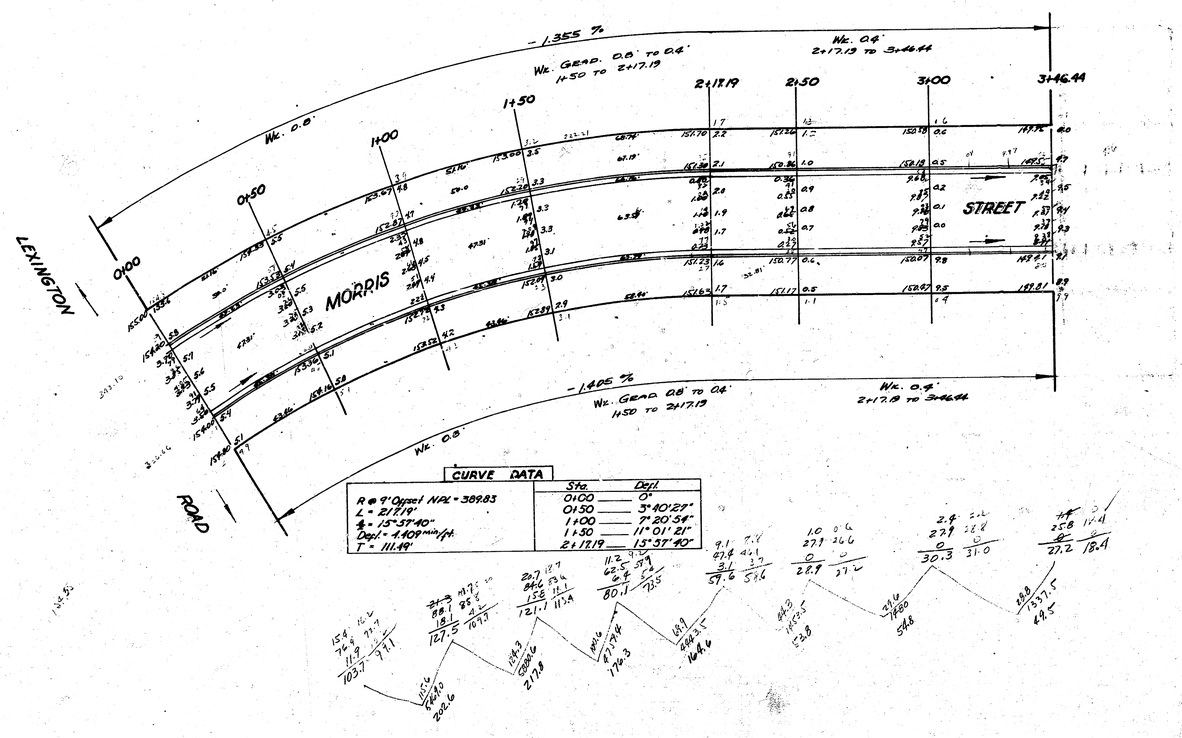

CURVE DATA	
R = 9' Oppos. NPL = 389.83	Sta. — Defl.
L = 217.19'	0+00 — 0°
Δ = 15°37'40"	0+50 — 3°40'29"
Defl. = 1.409 min/ft.	1+00 — 7°20'54"
T = 111.49'	1+50 — 11°01'21"
	2+17.19 — 15°37'40"


EL PRAIRIE PARK ADD'N

MORRIS STREET
EL LEXINGTON ~ EL PRAIRIE PARK A
26-2-30 AC
City of Wichita Kansas
L.K. White — City Engineer
April, 1951 — Proj. No. C11-43

L. K. WHITE LICENSED 55 KANSAS PROFESSIONAL ENGINEER

4 8 1 (52)

BM 1626.66 "M" in Mueller F. Hyd. NW Cor. Lightner & Morris

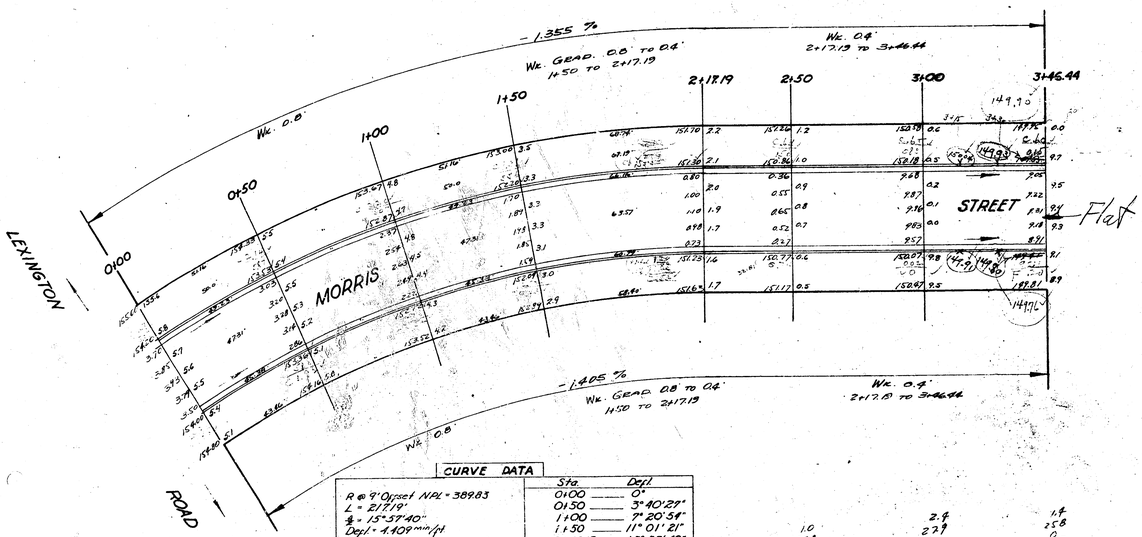

CURVE DATA	Sta.	Defl.
R = 9°0 Offset N&L = 389.83	0+00	0°
L = 217.19'	0+50	3°40'29"
Δ = 15°37'40"	1+00	7°20'59"
Defl. = 4.409 min/ft	1+50	11°01'21"
T = 111.49'	2+17.19	15°37'40"

Prop.	City
200.6	0
51.8	
178.3	
164.6	
53.8	
58.0	
49.1	
704.4	
+18.5%	
1011.3	cu. yds.

EL PRAIRIE PARK ADD'N

MORRIS STREET
EL LEXINGTON ~ EL PRAIRIE PARK A
26-2-30 AC
City of Wichita Kansas
L.K. White City Engineer
April, 1951 Proj. No. C11-43