

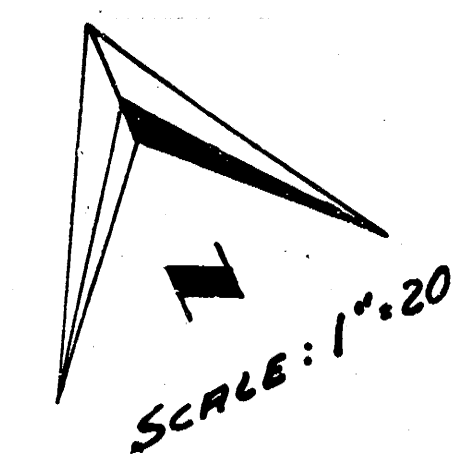


CHM-80

B.M. "R" IN RITCHIE N. CO. MORRIS, E.L. MISSION RD. - 160.36

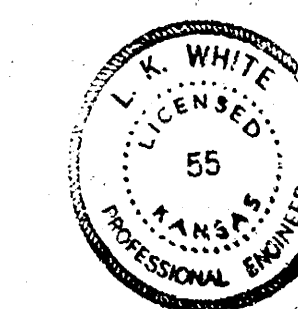

EXCAVATION -
CITY PROP
0.0 424.3
+10% 42.6
466.9 105.3 Exc.

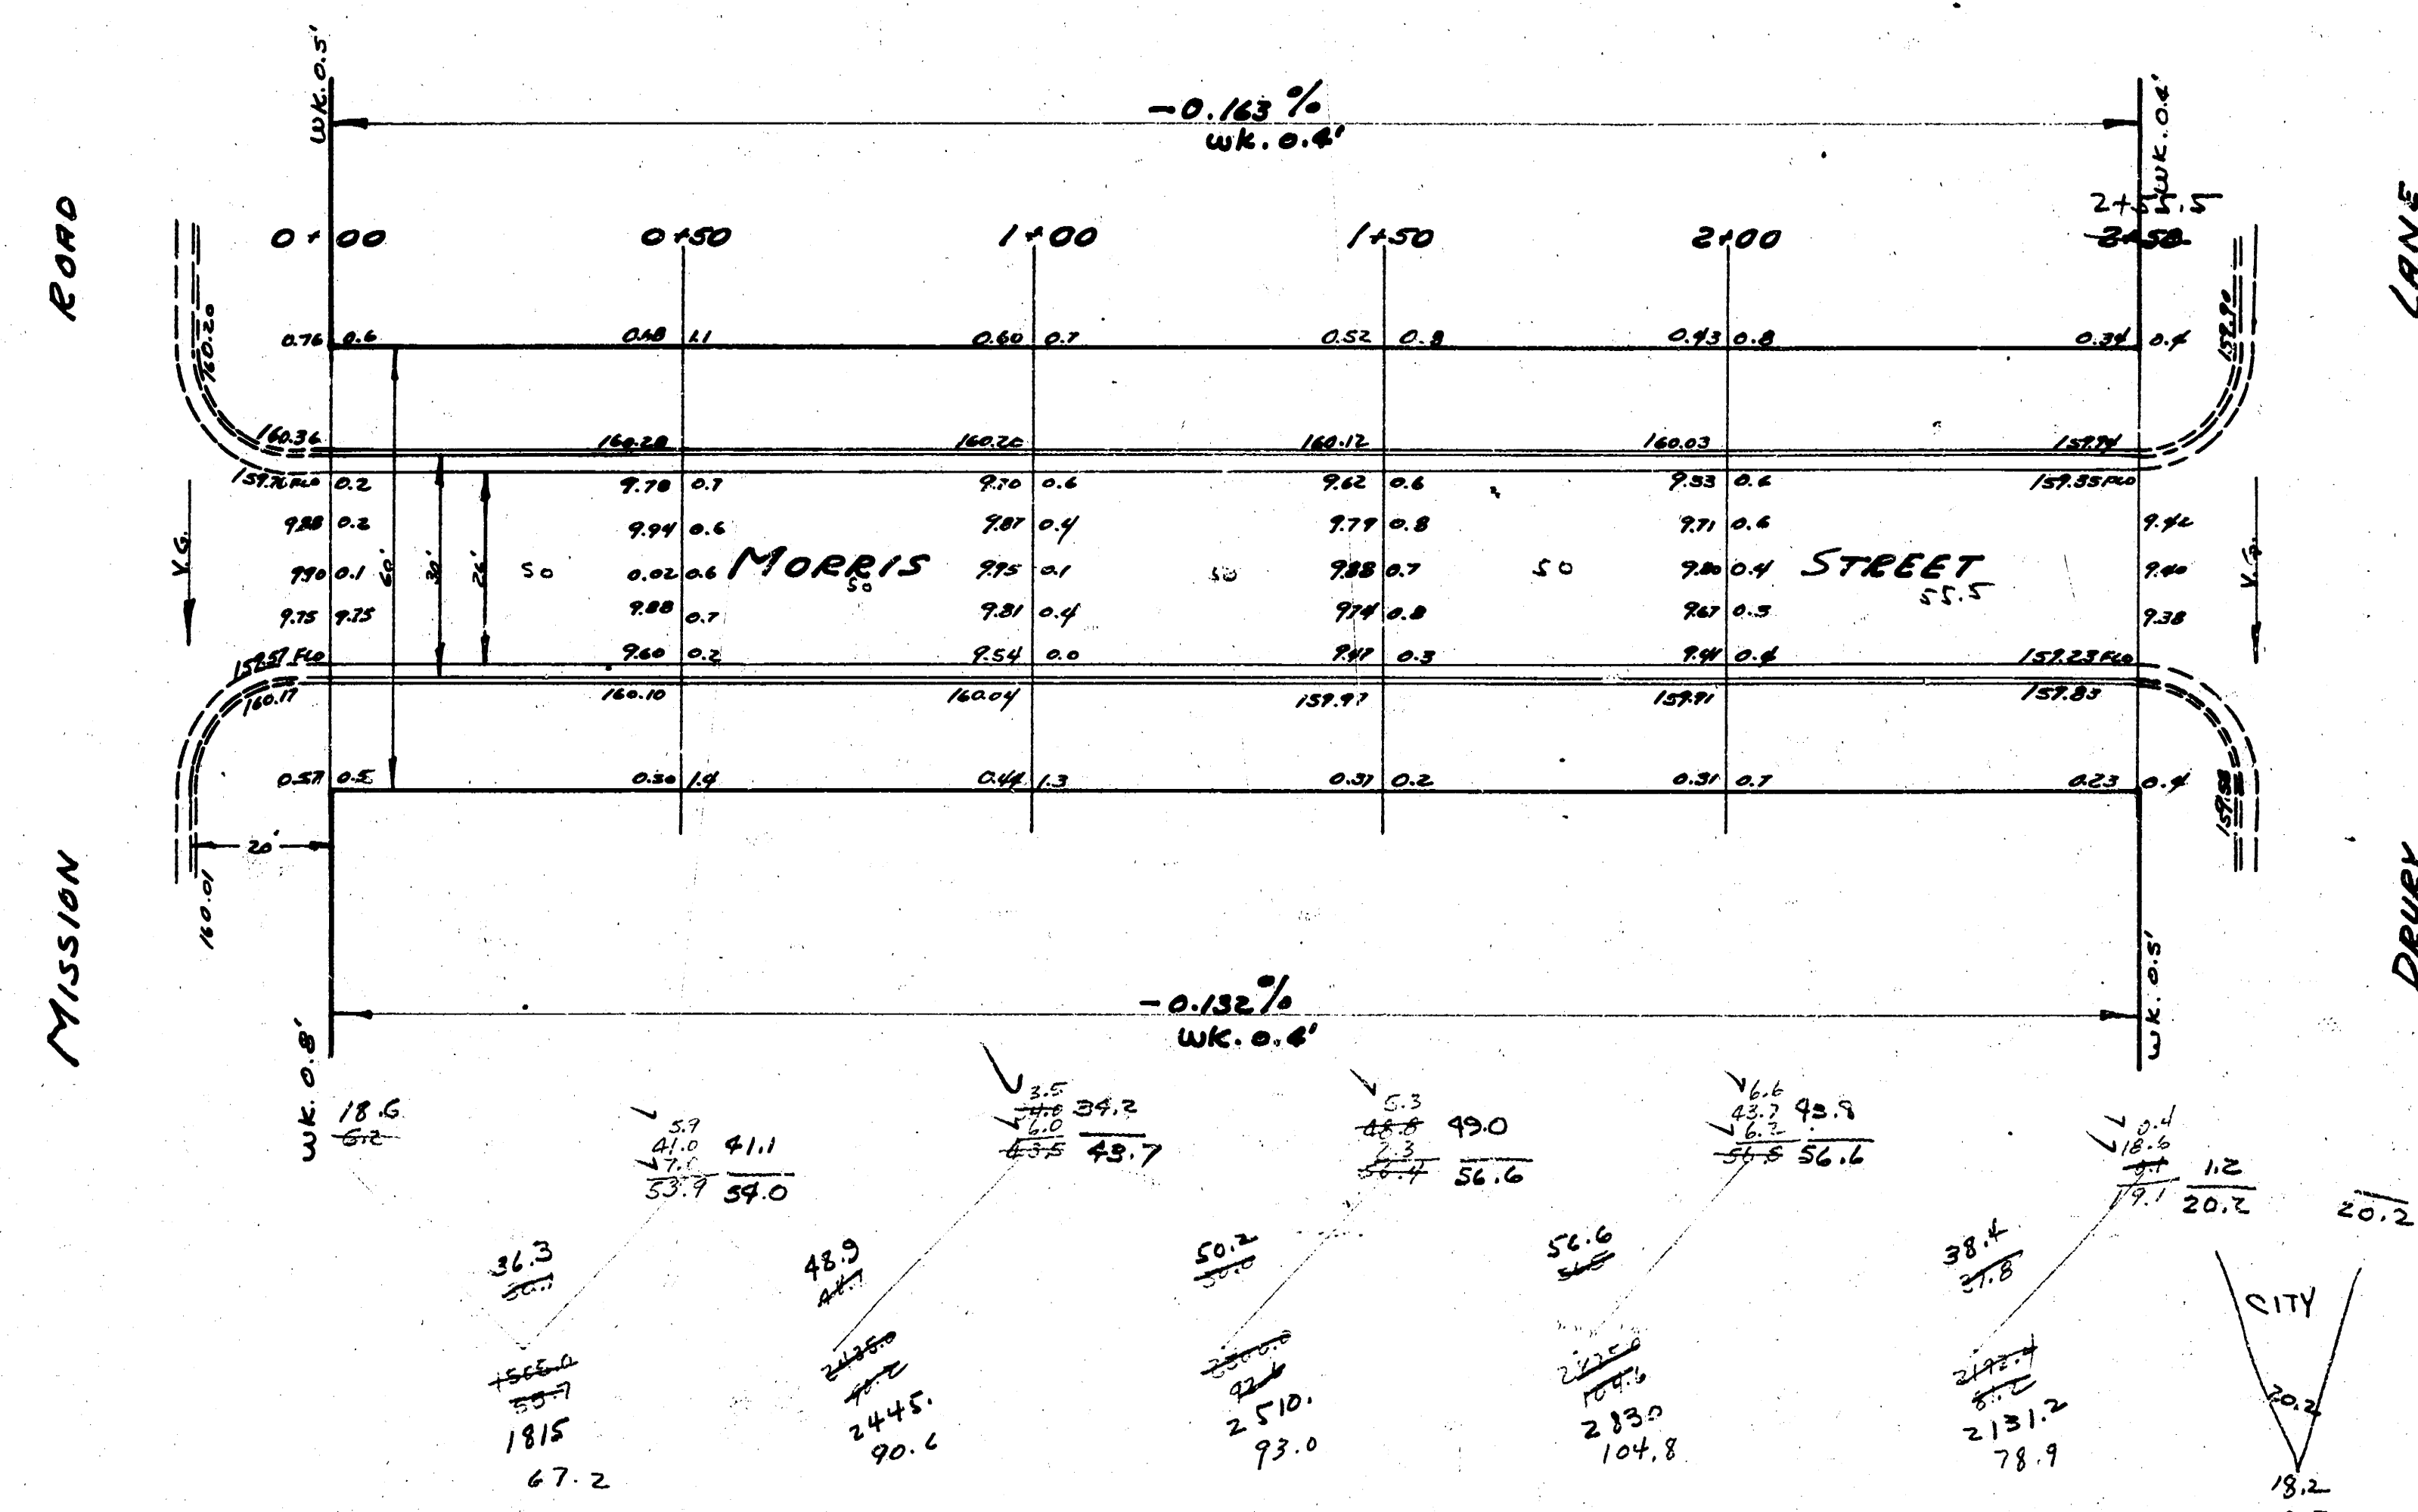

MORRIS
E.L. MISSION TO W.L. DRURY
26-2-30 P.C.
CITY OF WICHITA, KANSAS
L.R. WHITE CITY ENGINEER
JULY 1952 PROJ. No. C12-70

1 5 1