




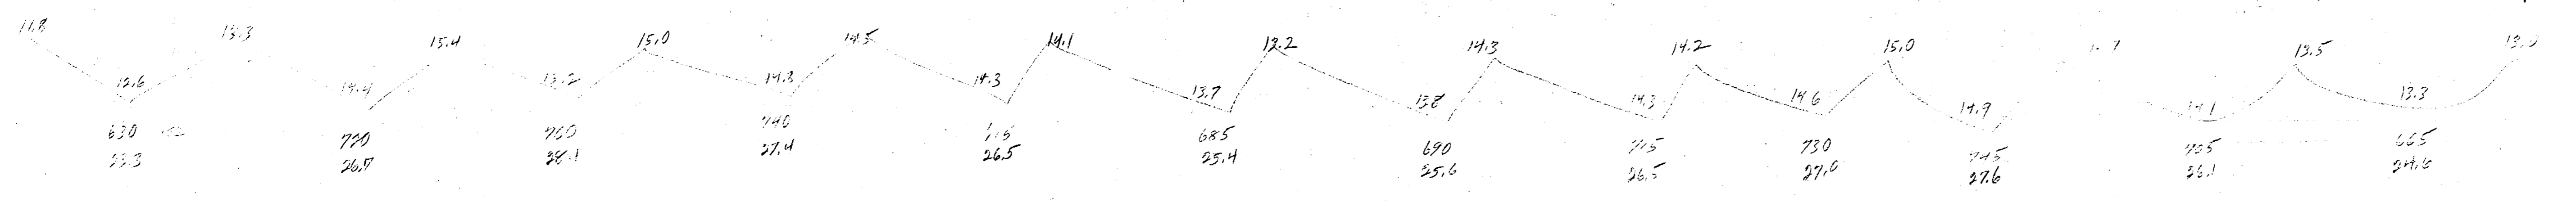

Property


23.3  
26.7  
28.1  
29.4  
26.5  
25.4  
25.3  
26.5  
27.0  
27.6  
28.1  
28.2  
27.4

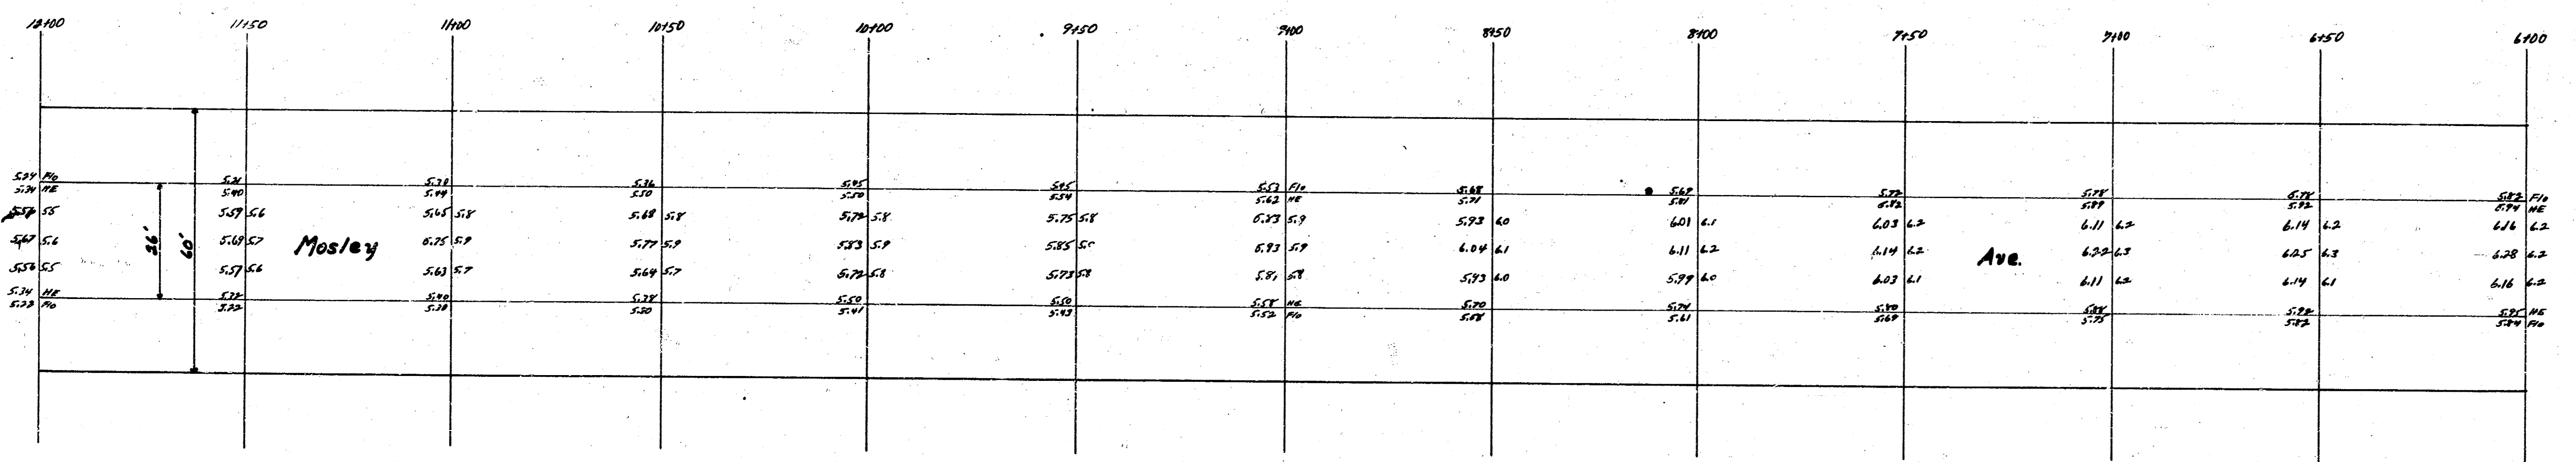

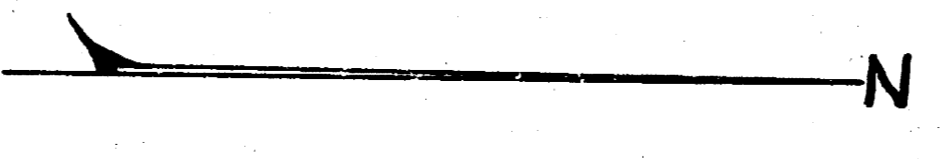






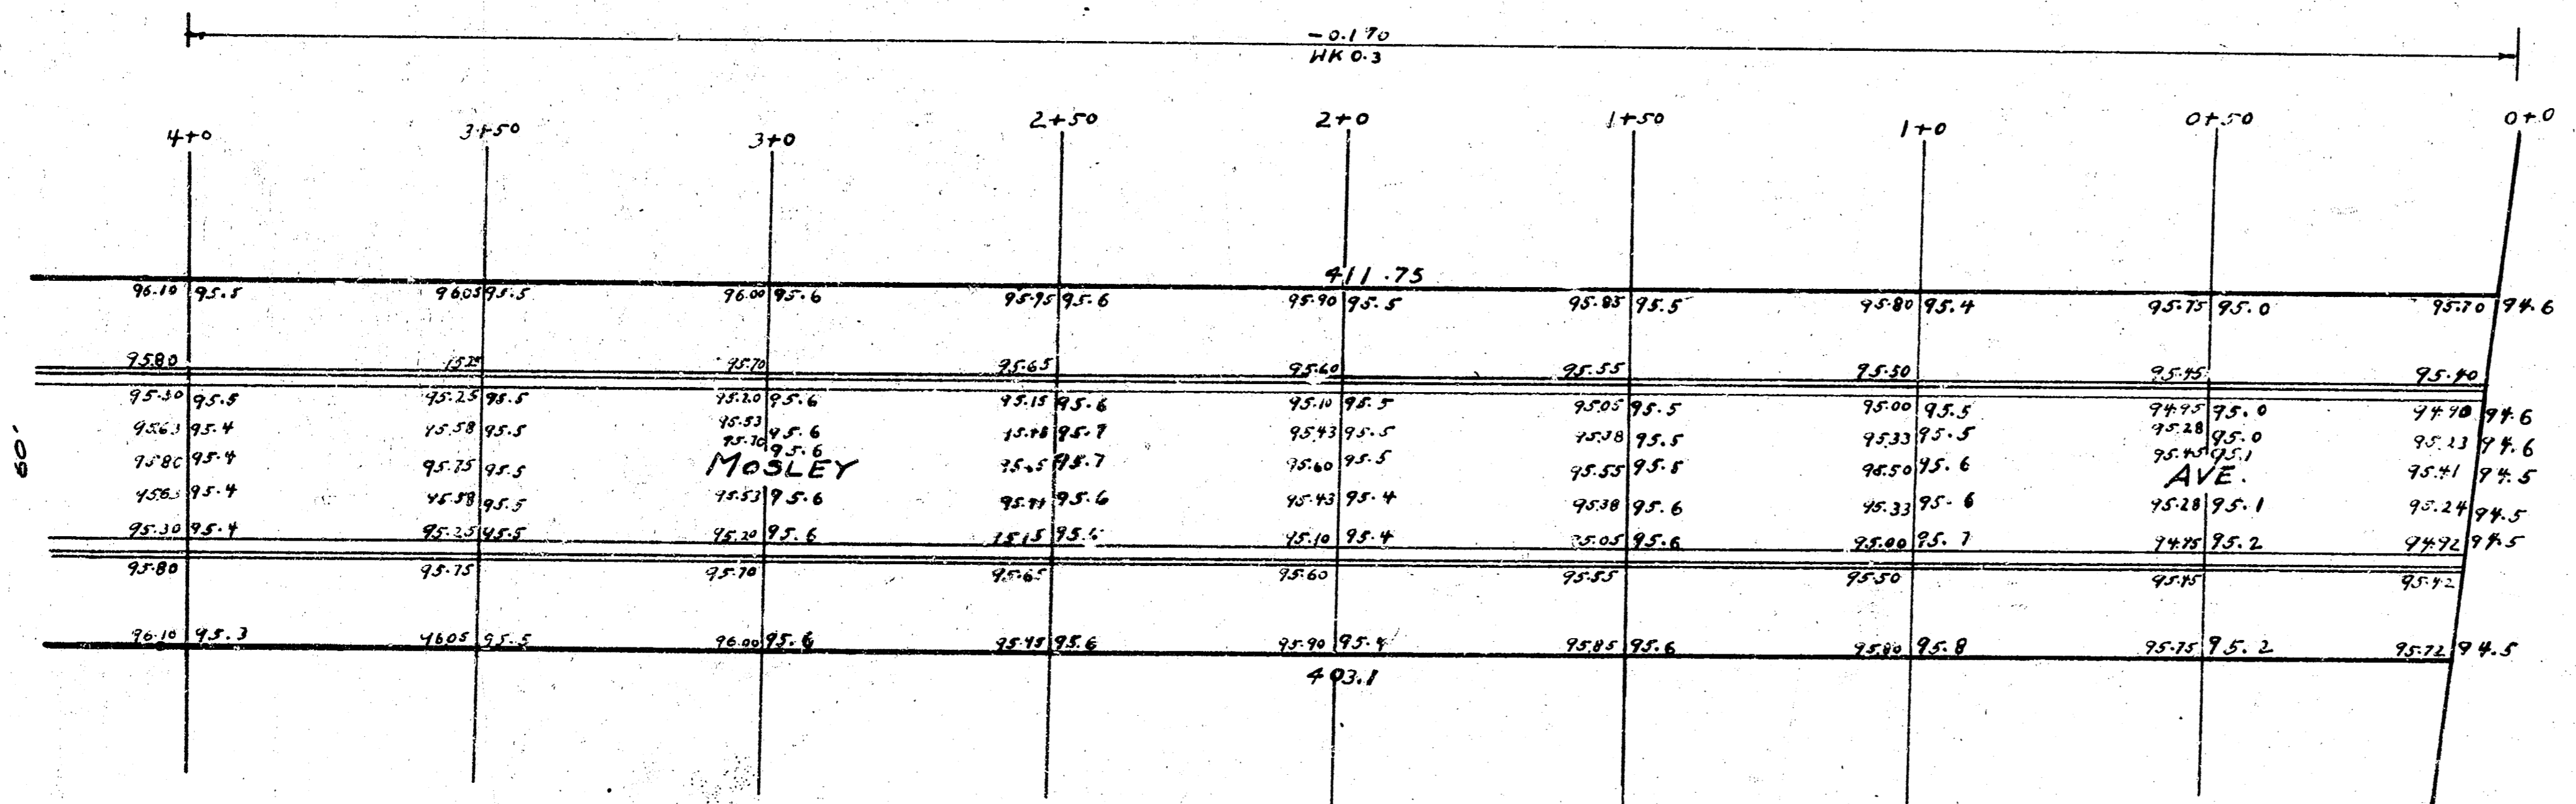

ROAD

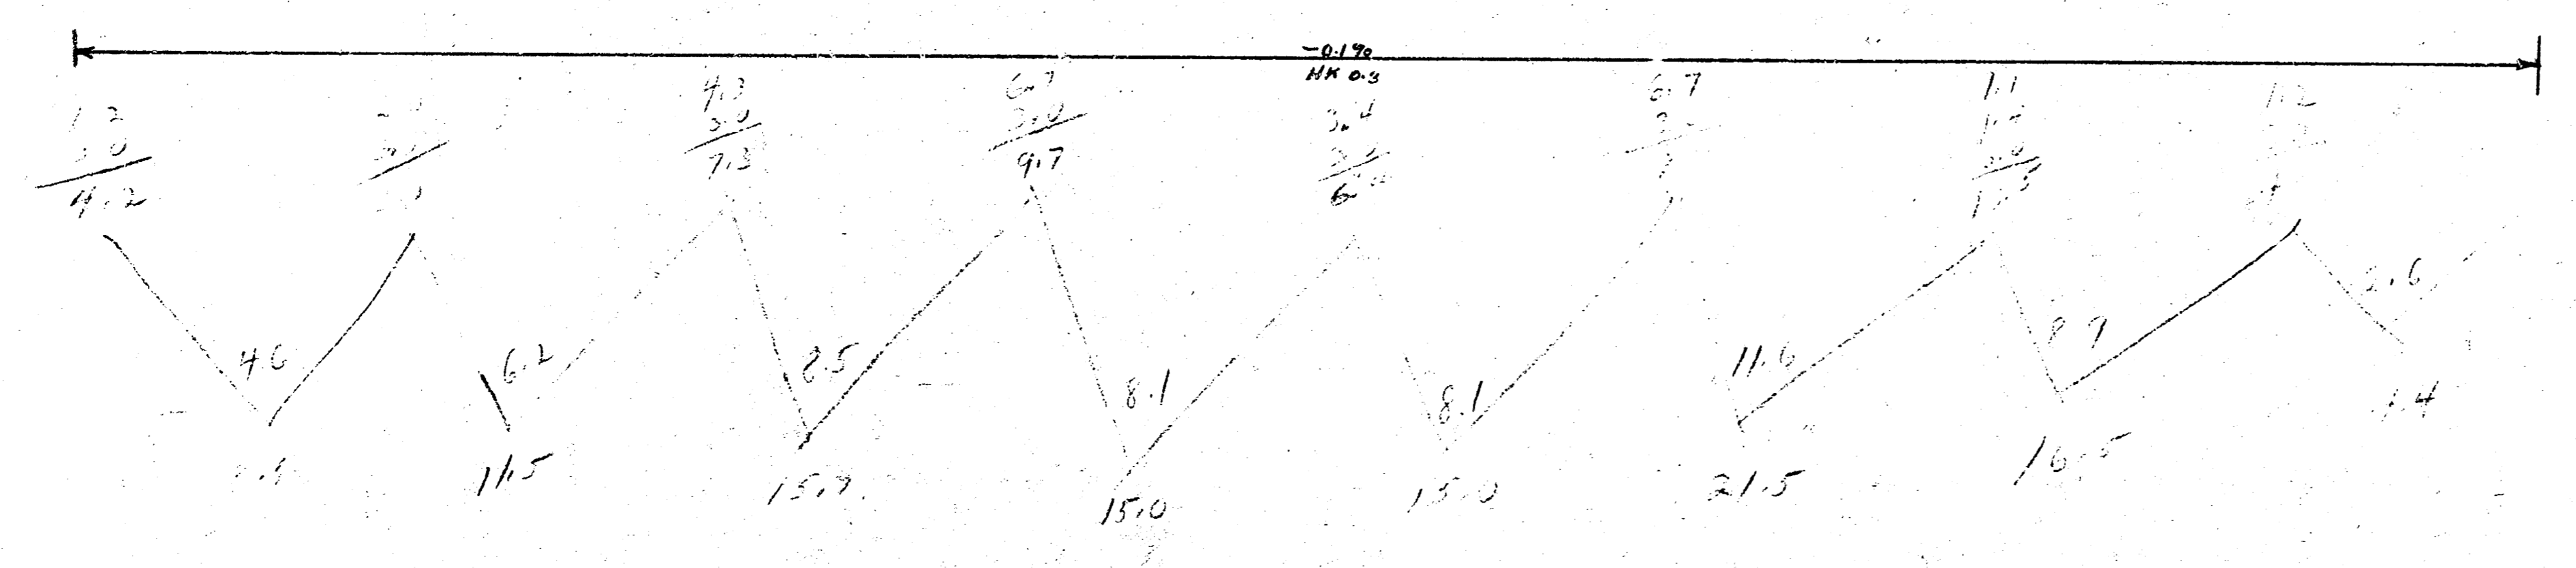

MARION  
 2.5  
 11.5  
 15.7  
 15.0  
 15.0  
 21.5  
 16.5  
 4.2  
 12.1  
 15.8  
 118.7