



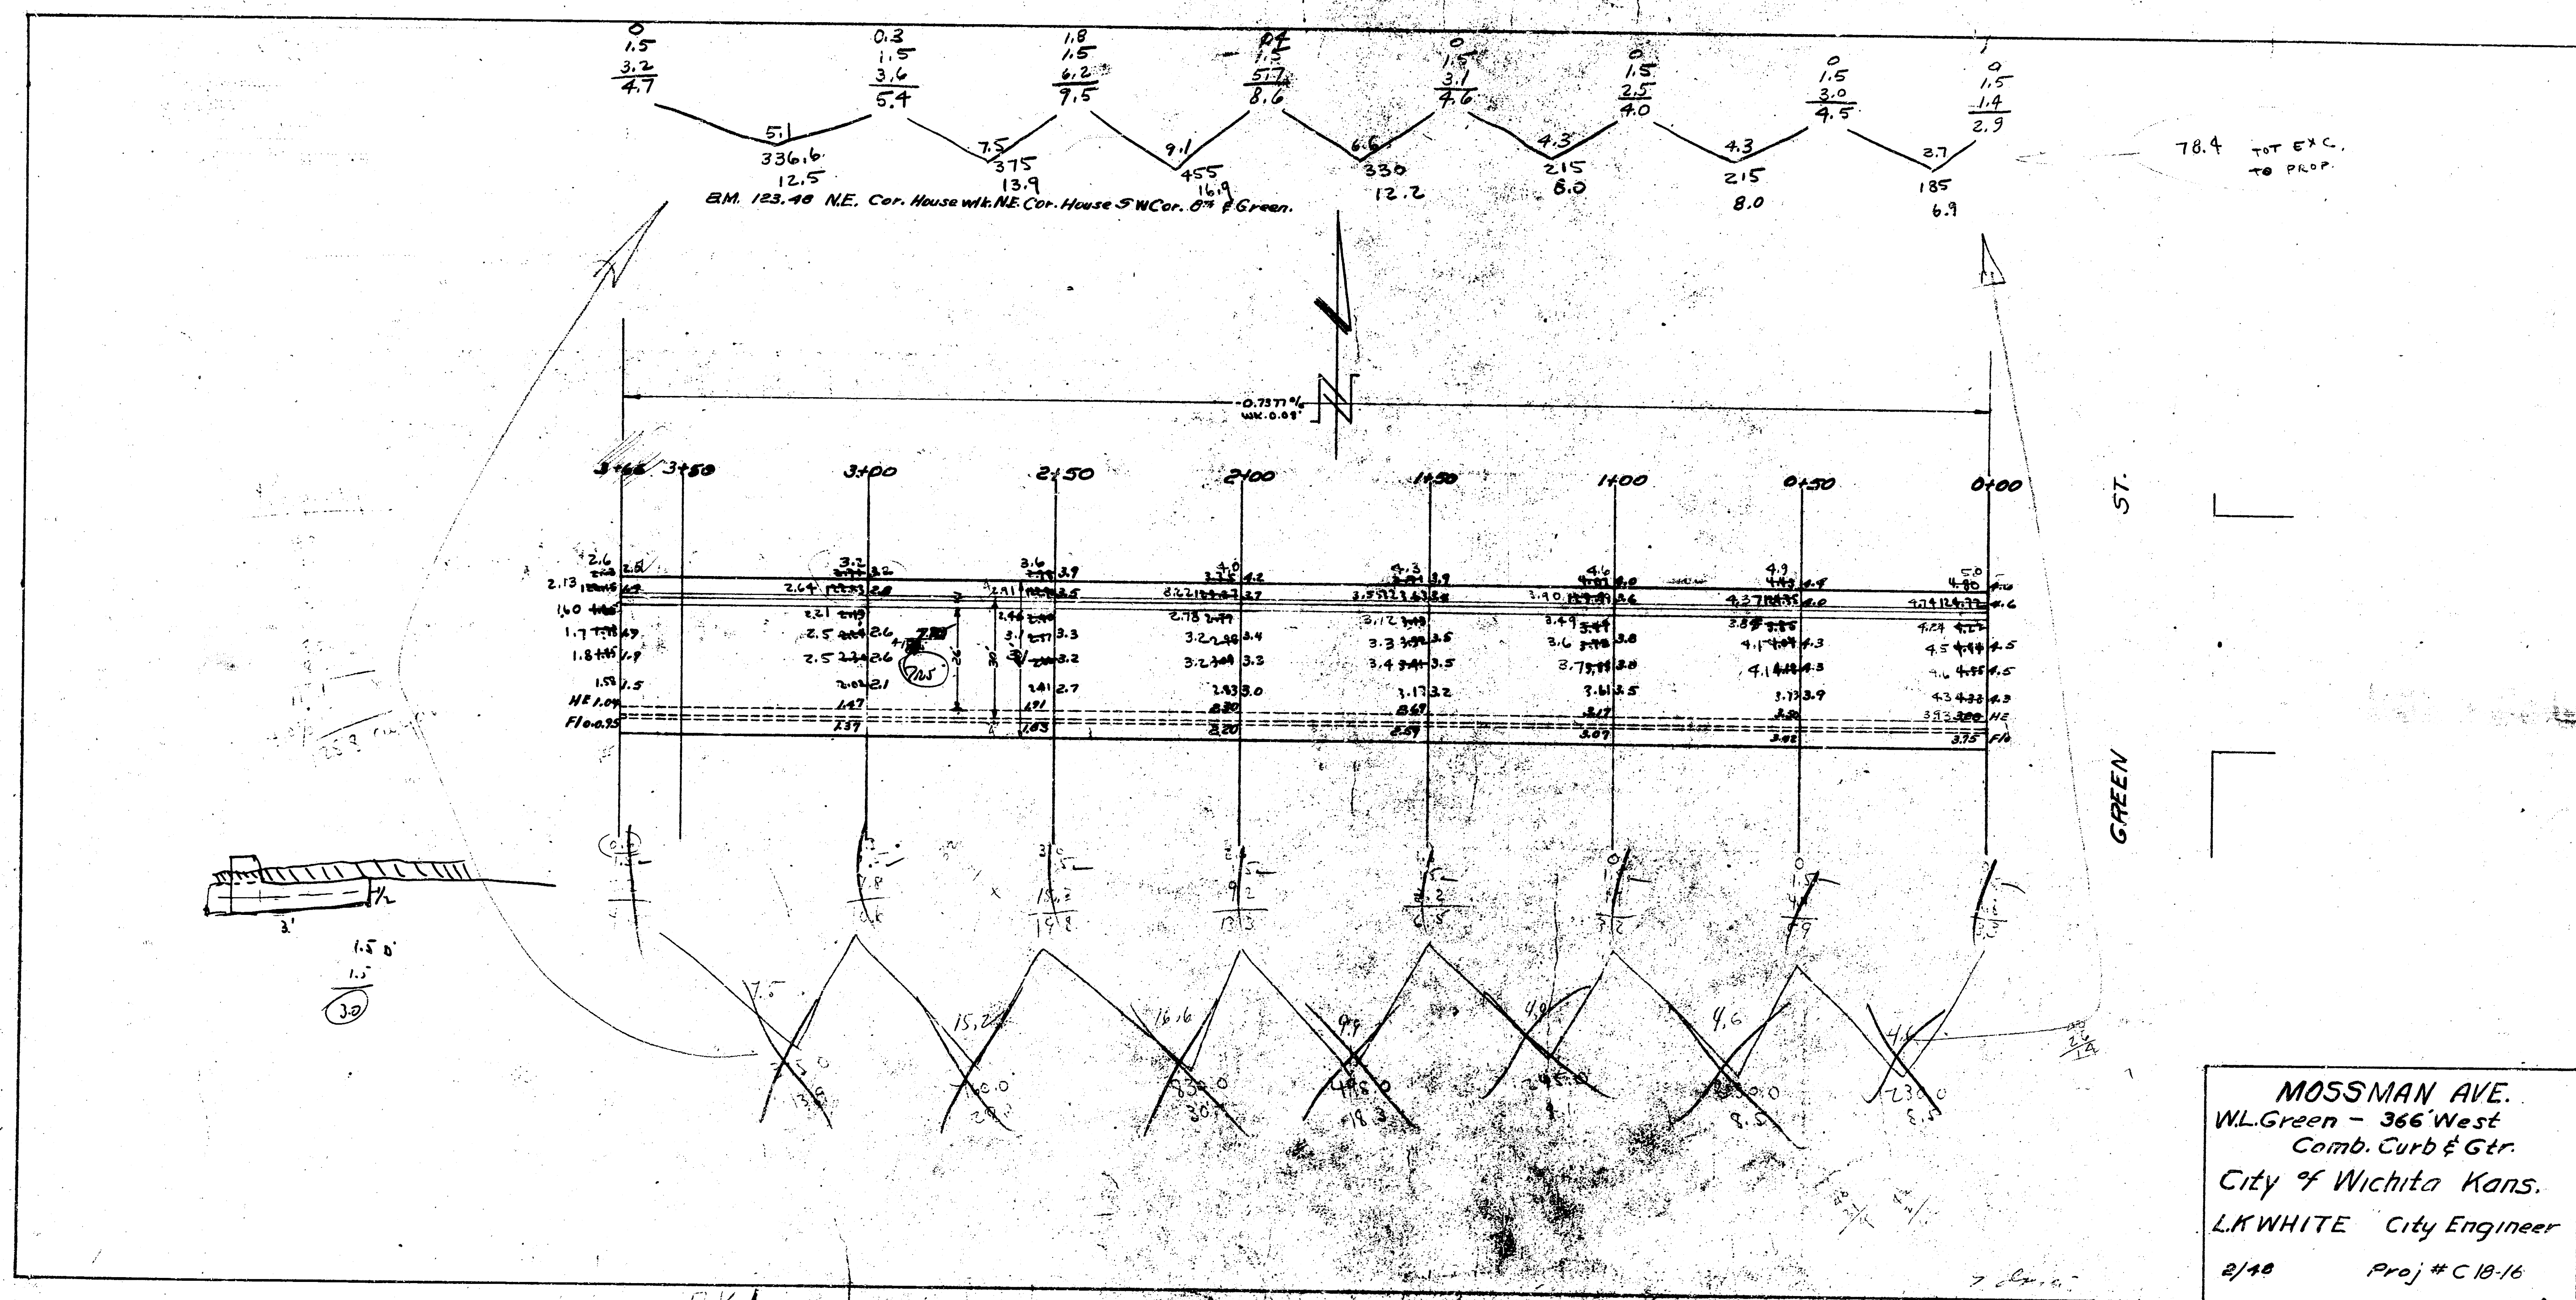

B.M. 123.48 NE. Cor. House with NE Cor. House SW Cor. 6" # Green.

Property
 189
 281
 307
 188
 9.1
 8.5
 177.1
 +10% 117
 128.8 cu yds

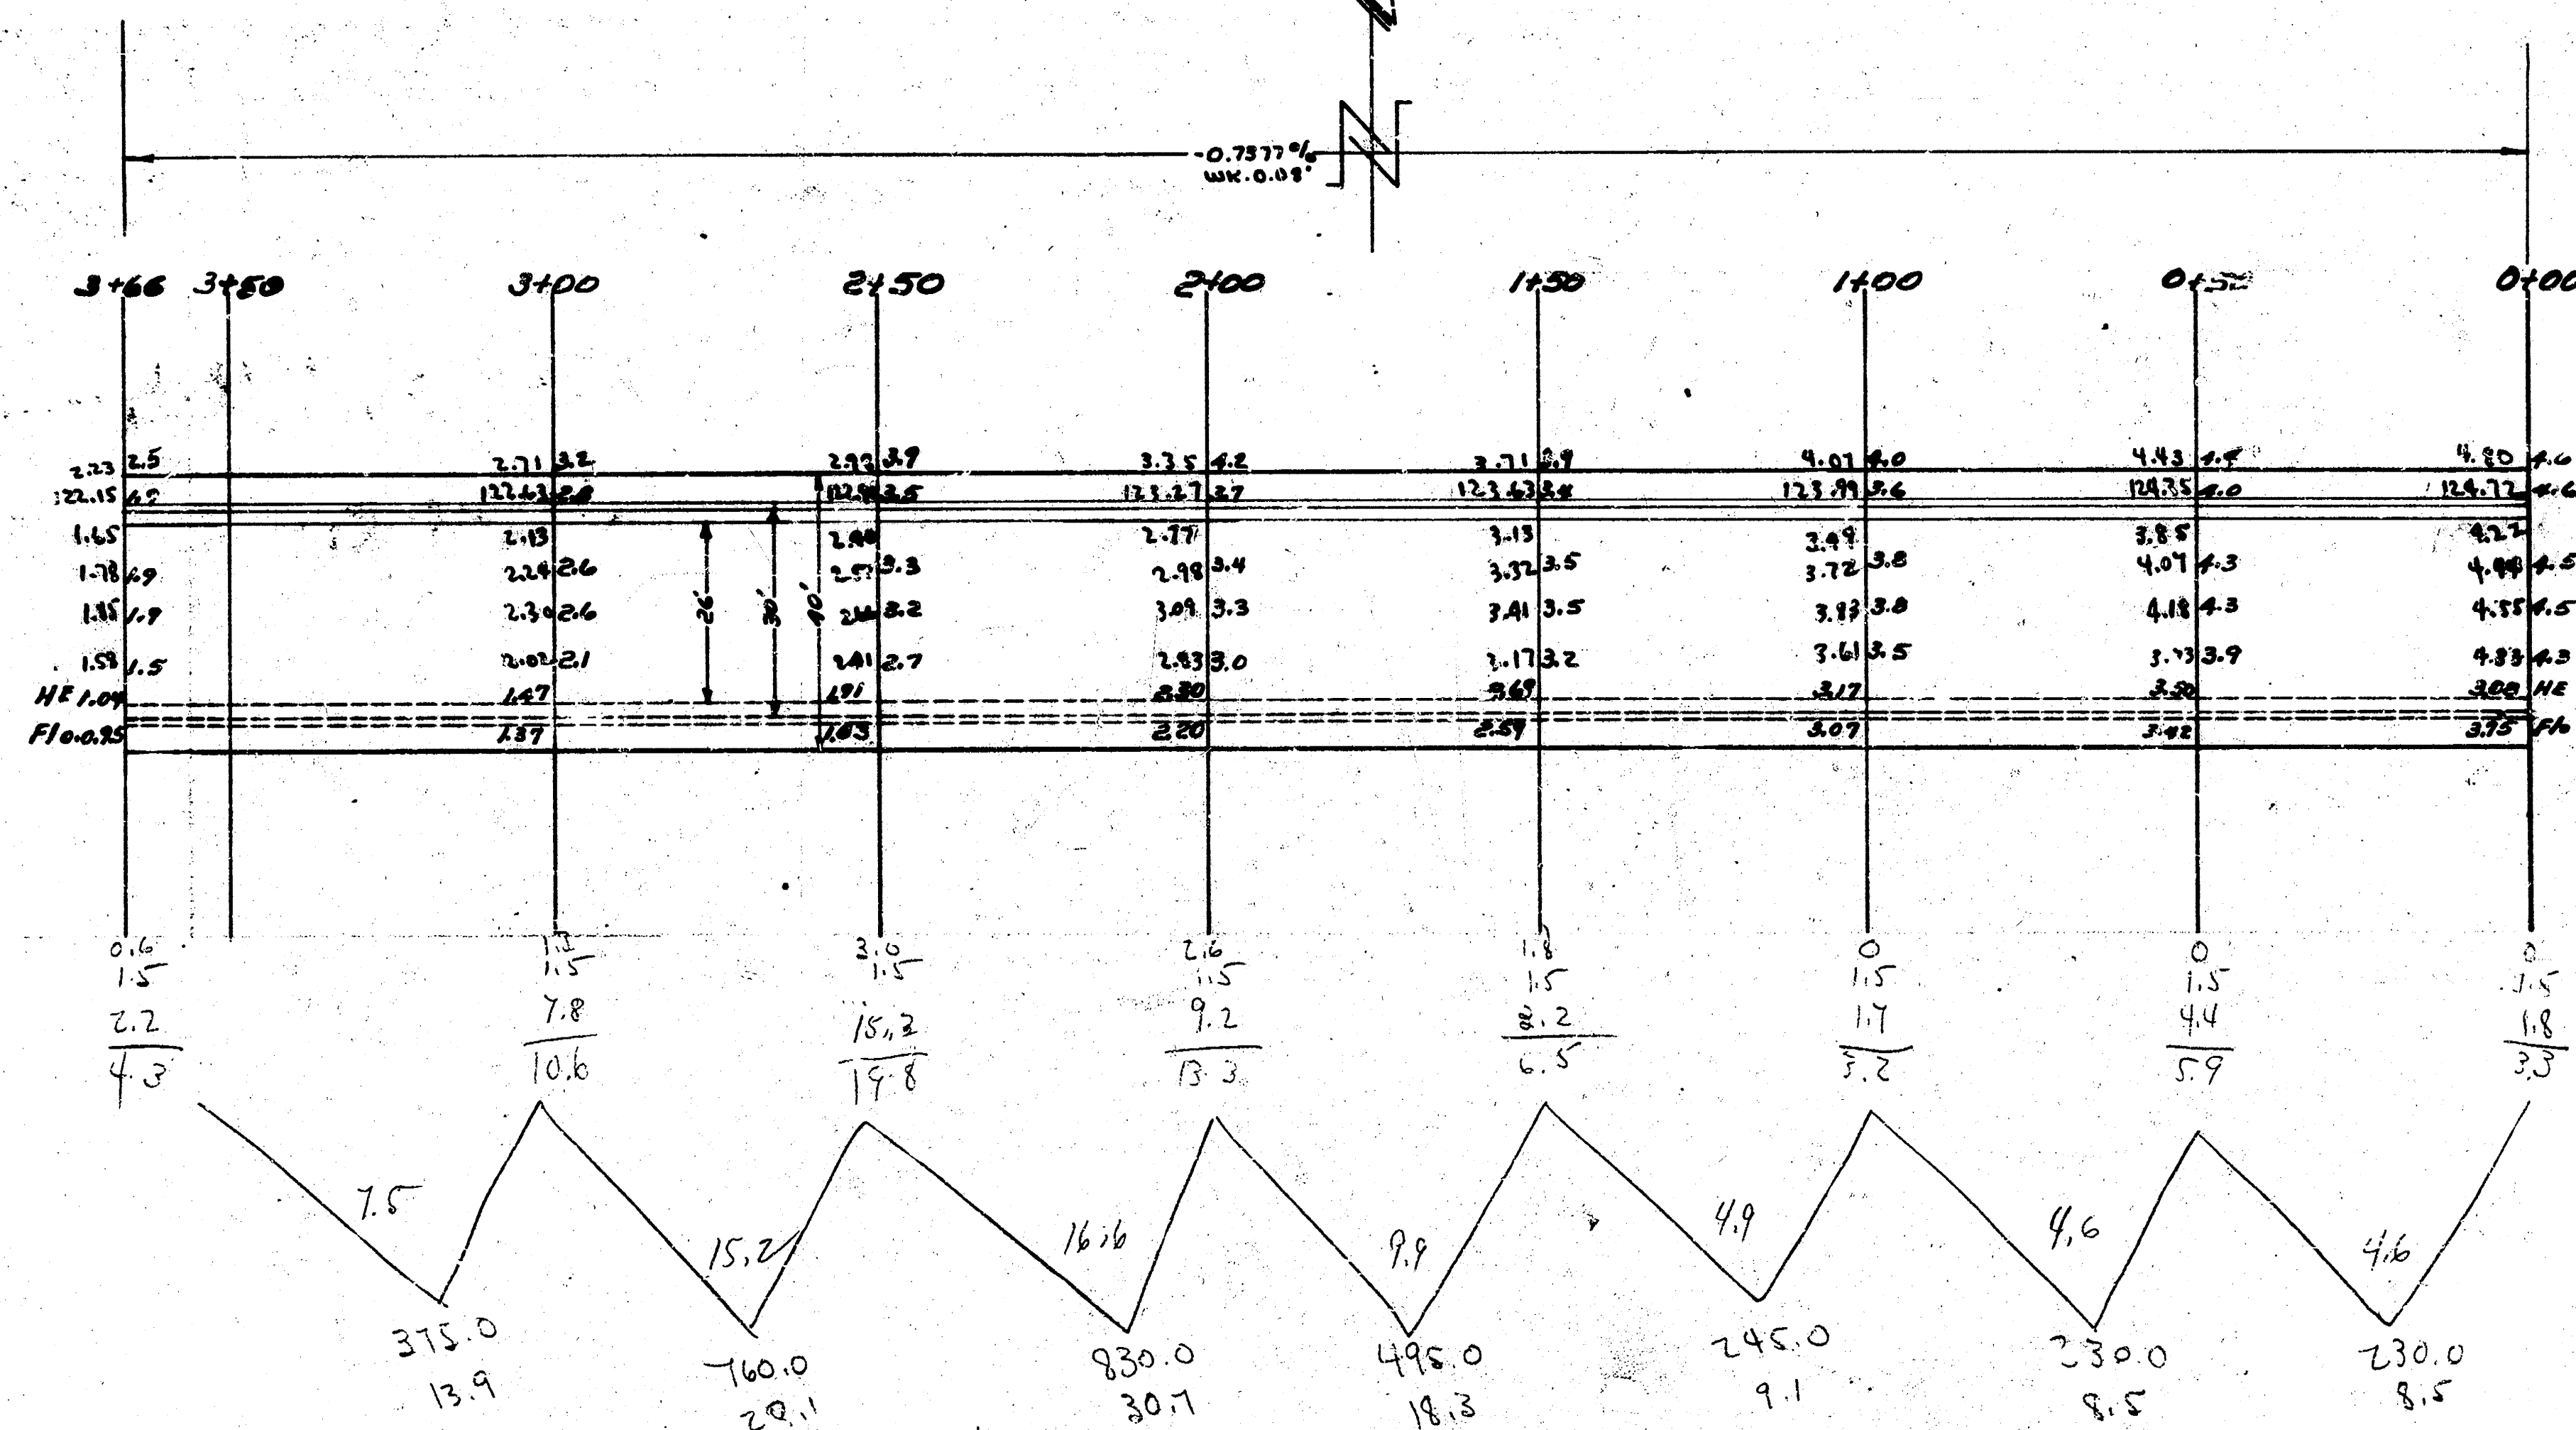

ST.

GREEN

MOSSMAN AVE.
 WL Green - 366' West
 Comb. Curb & Gtr.
 City of Wichita Kans.
 LK WHITE City Engineer
 2/40 Proj # C 10-16

BK1

4 15 3 e