


B.M. 130.00 E. of Volutsia S.L. Mossman

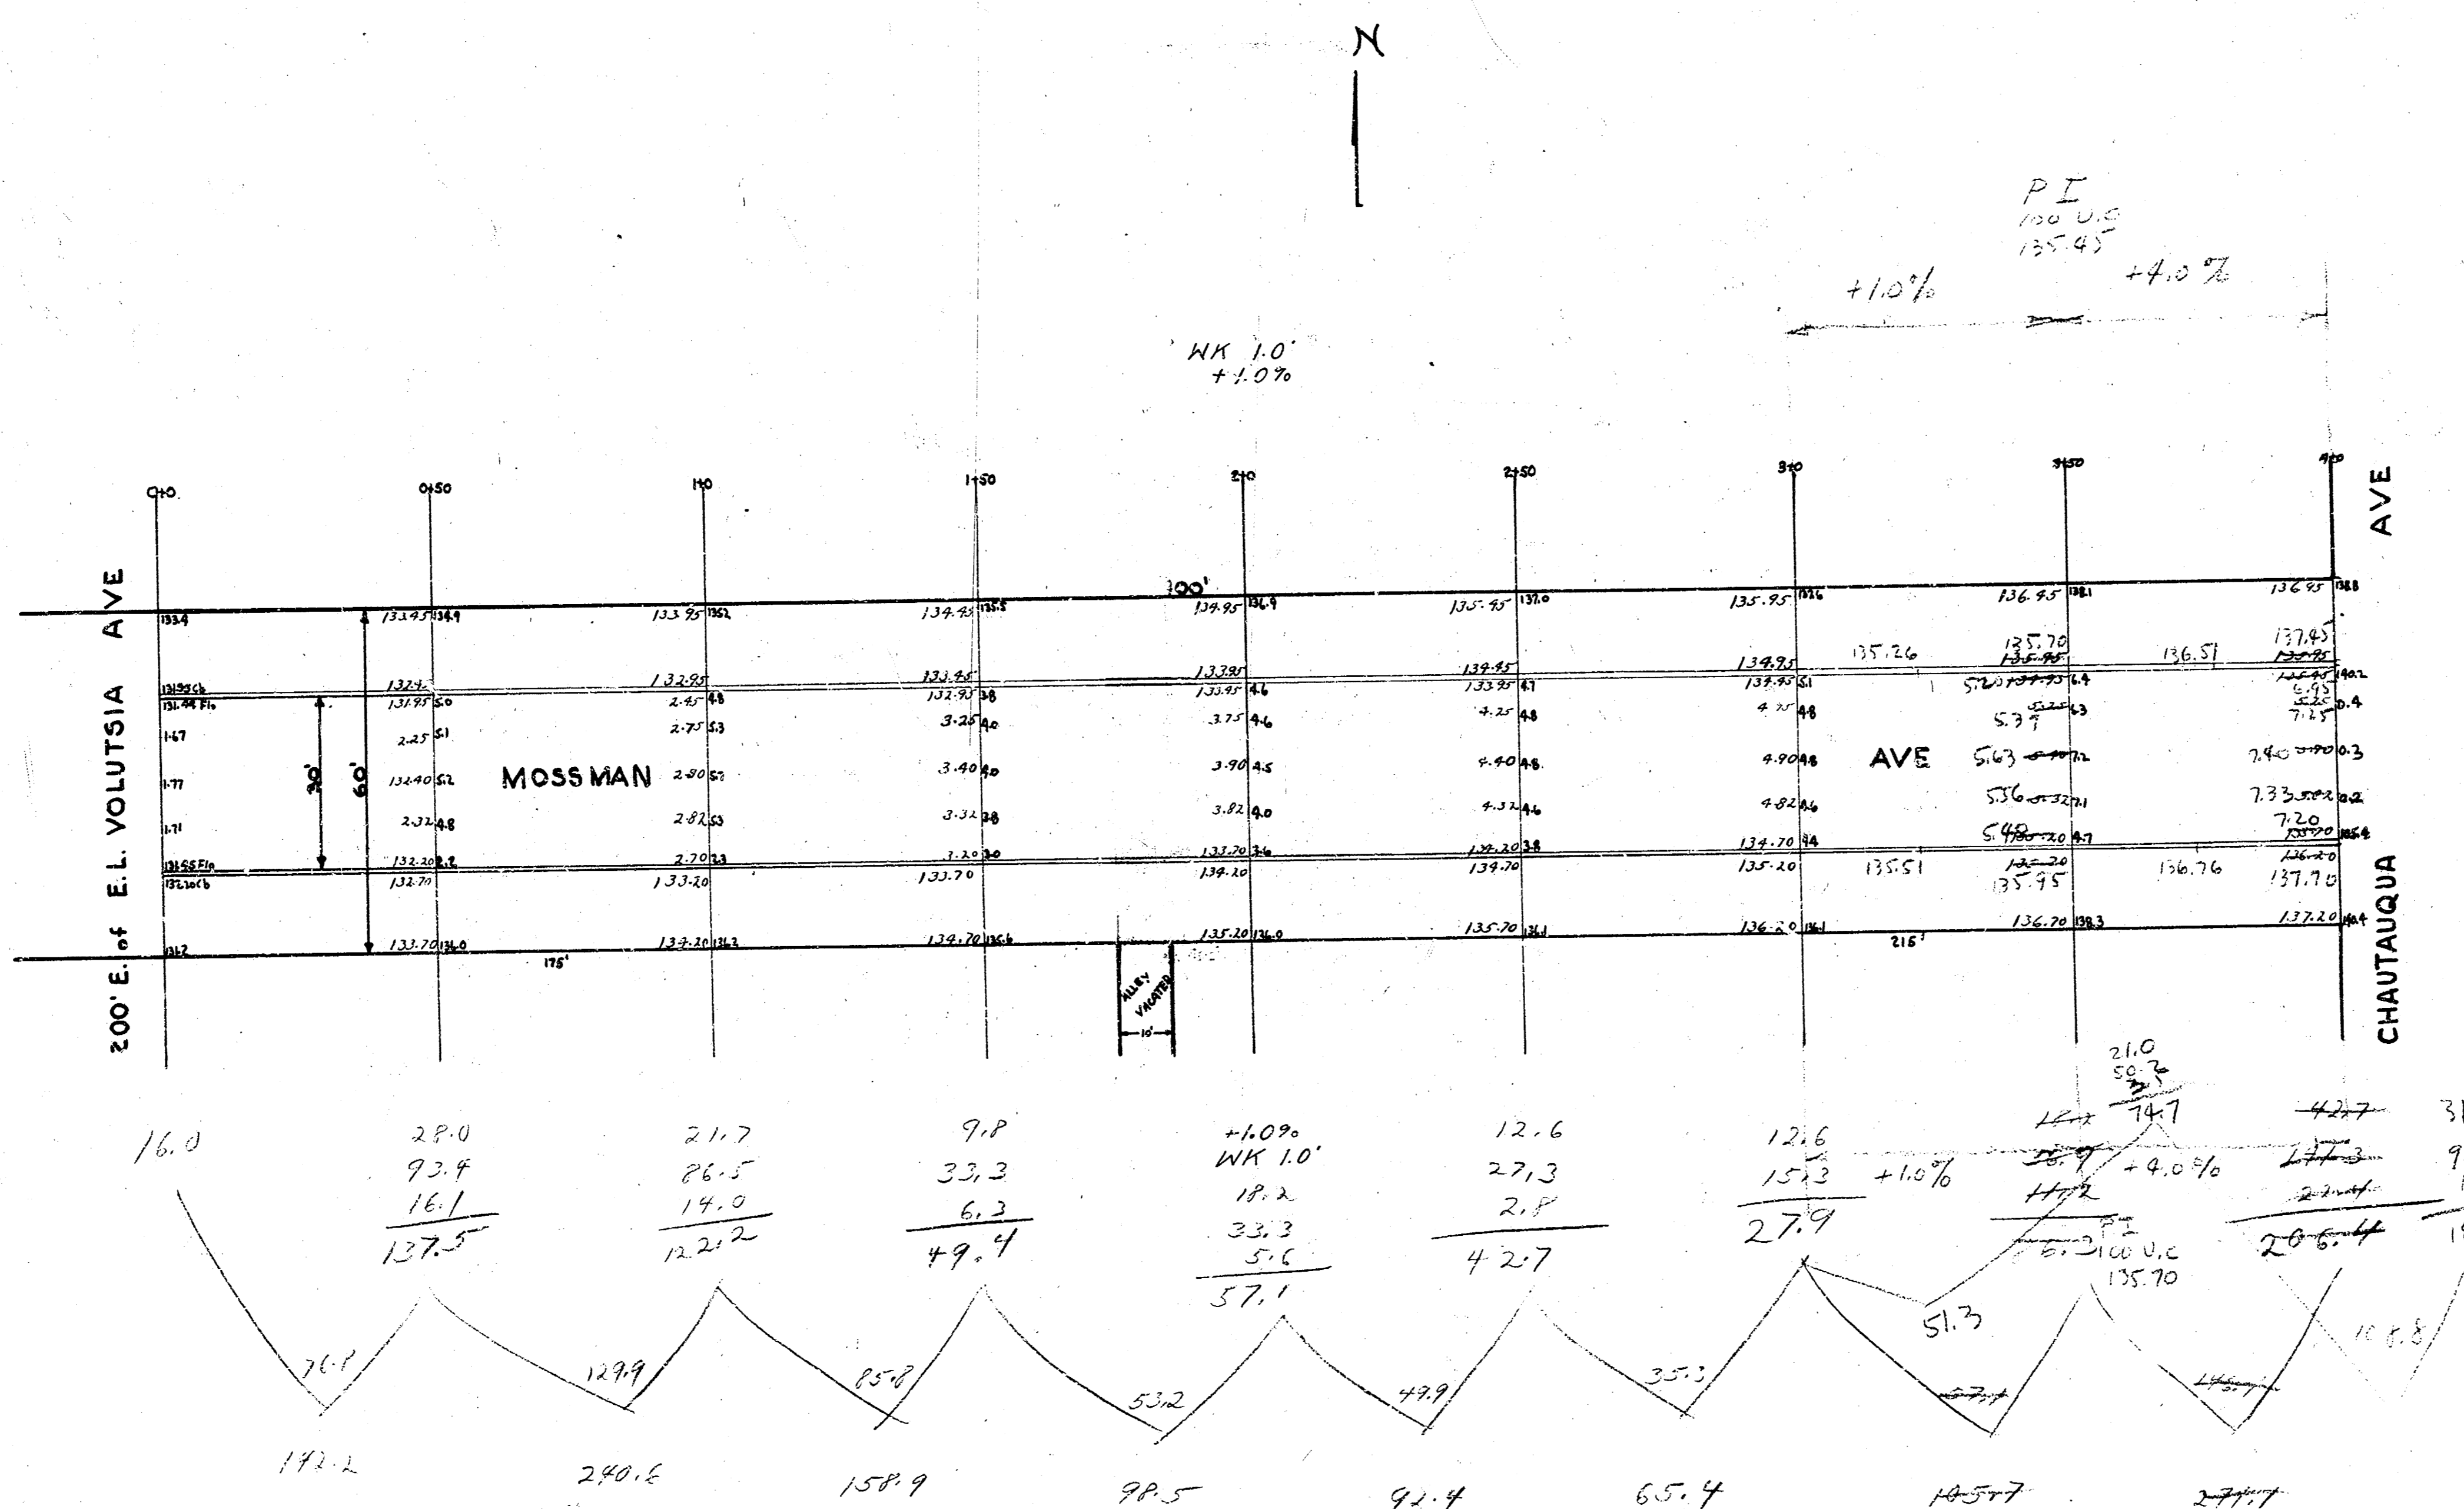

1174.8  
 4133 117.5  
 1292.3

**MOSSMAN AVE**  
 200' E. of E.L. VOLUTSIA TO W.L. CHAUTAUQUA  
 30' CONCRETE & C.B.  
 CITY OF WICHITA, KANSAS  
 L.K. WHITE CITY ENGINEER  
 AUG. 1946