


By Edo 11531 - "D" in Ball back of wall north N.W. corner Post & 9th

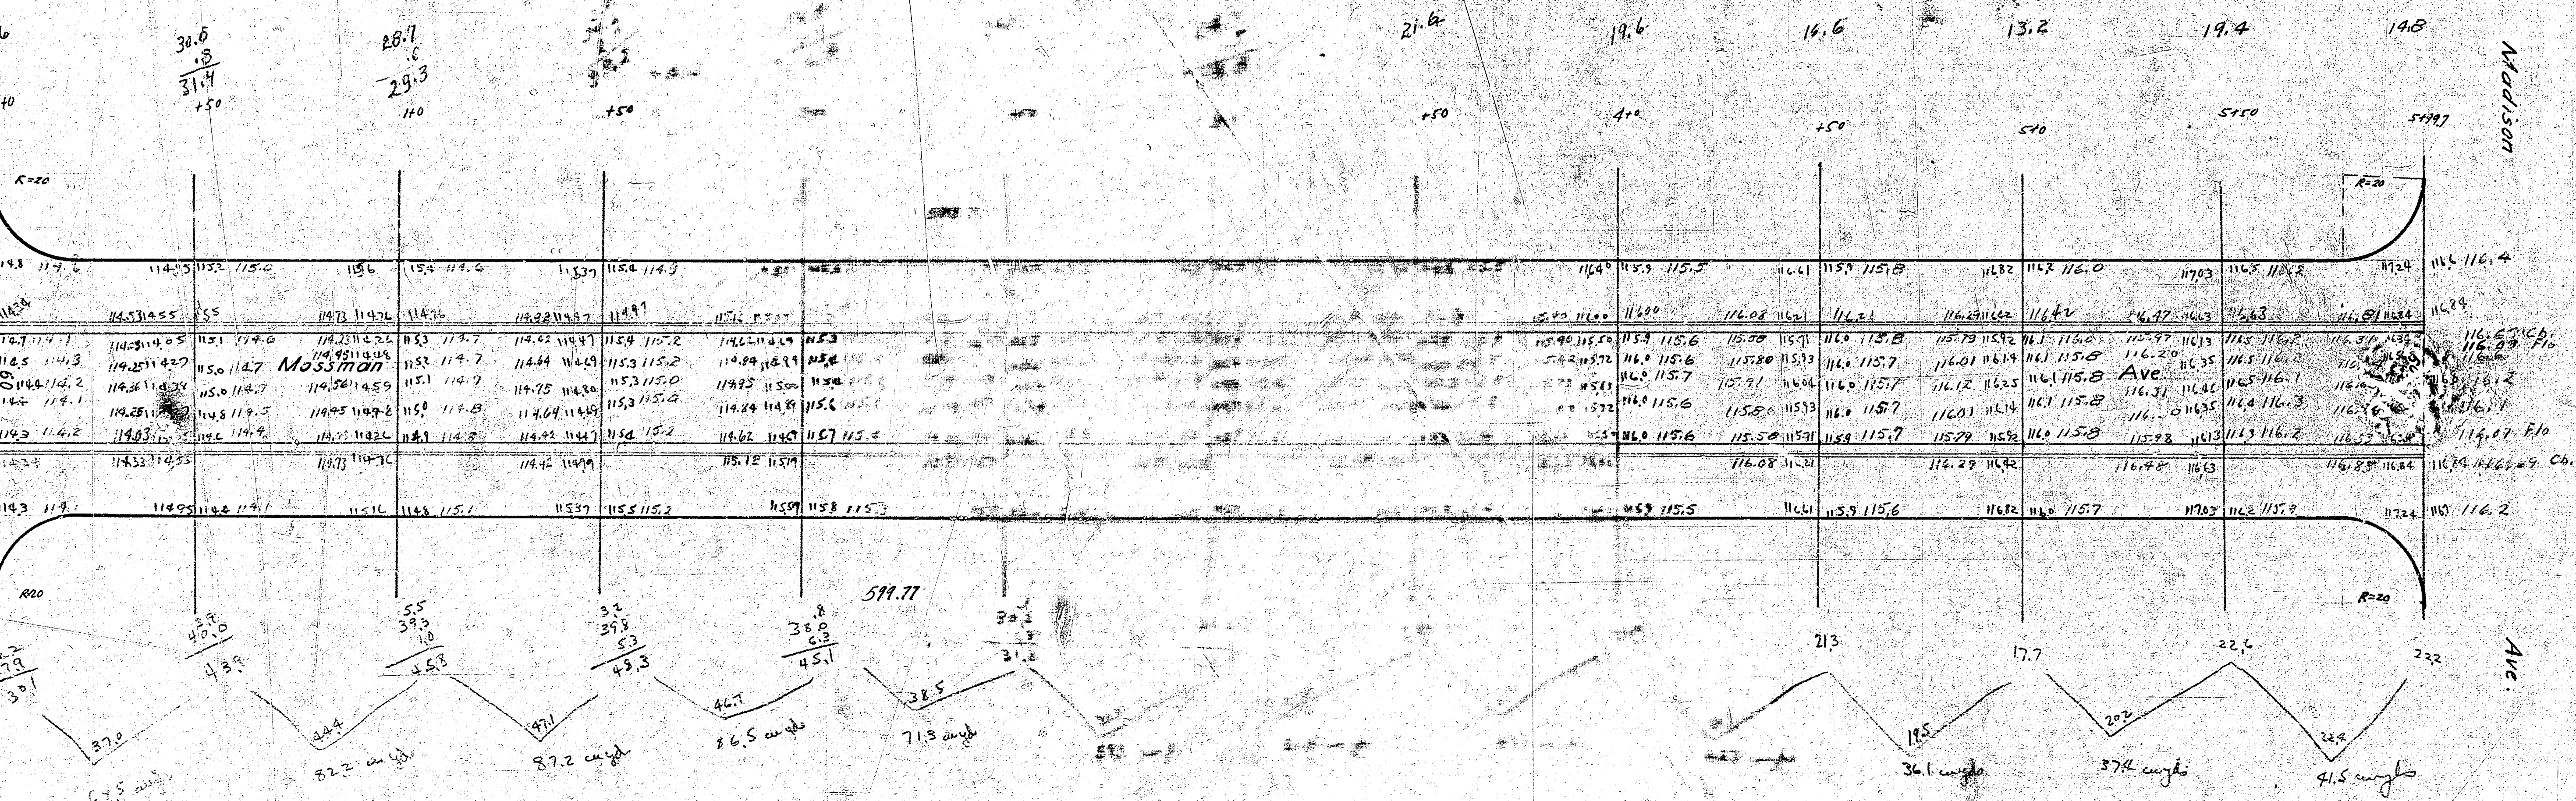

Property - 714.8
+10% - 71.5
786.3 per yr