
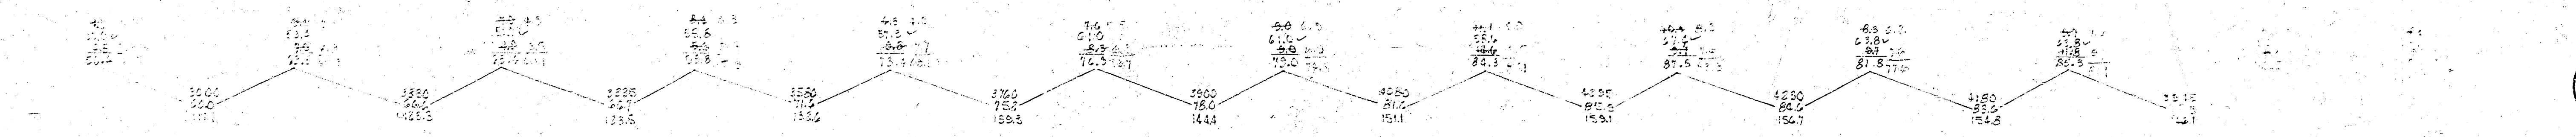
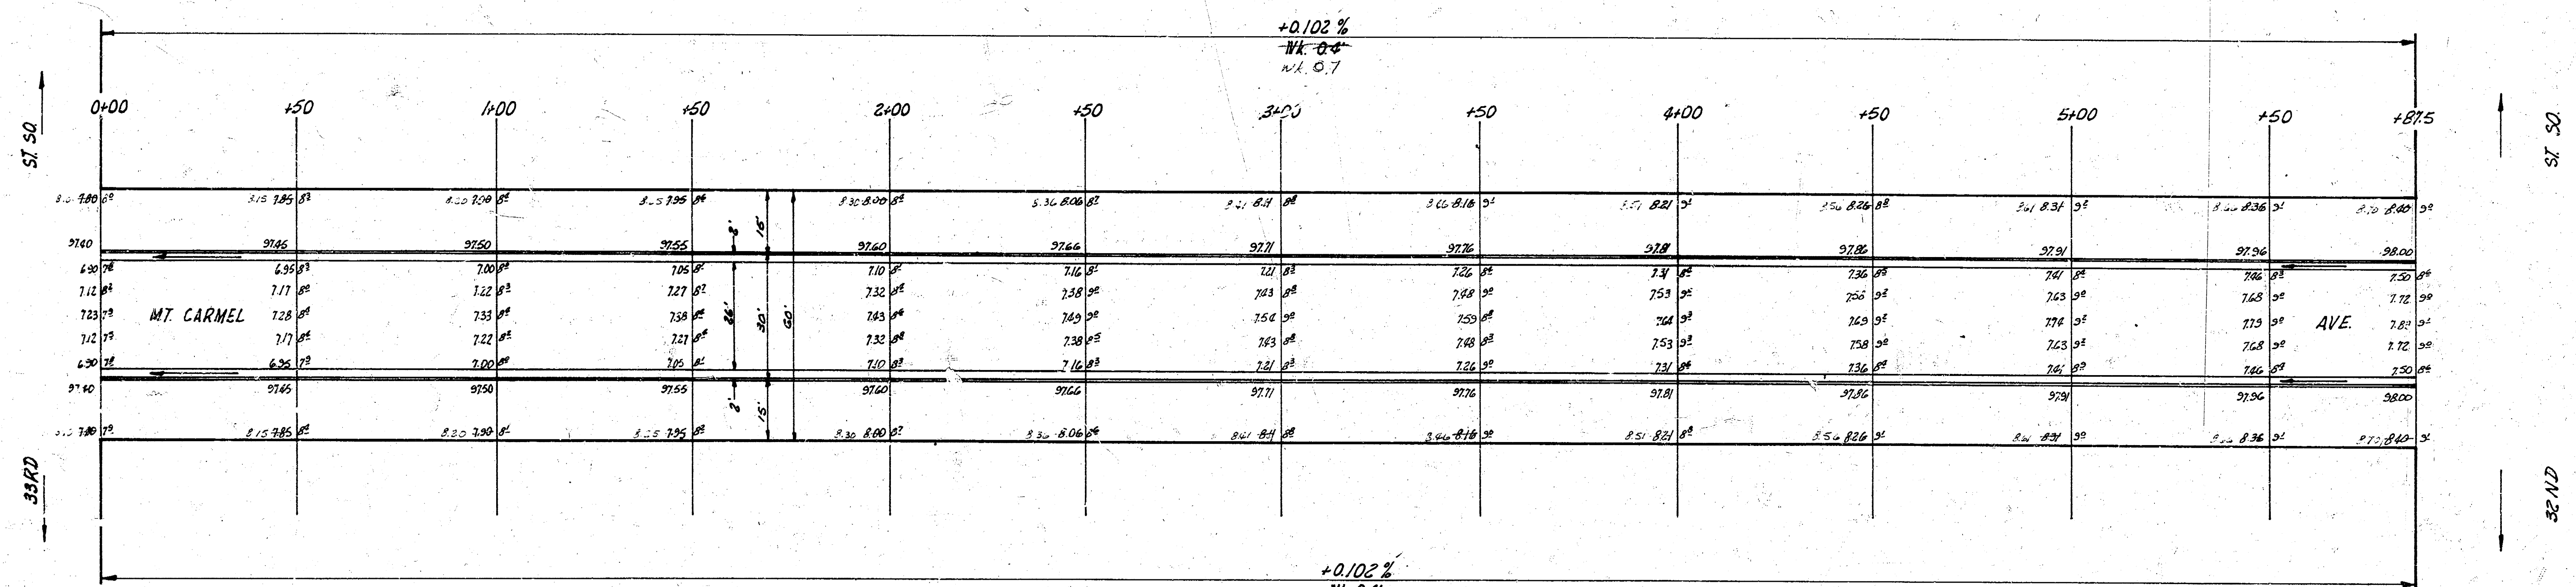


B.M. 99.93 Standard S.E. Sheridan of 31st St So

Sta on E.L.

TOTAL EXCAV
100.42 cu Yds

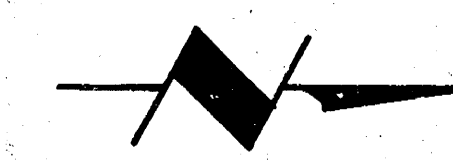

1/2



MT CARMEL AVE.
NL 33RD ST SO - SL 31ST ST SO.
26.2-30 A.C.
CITY OF WICHITA, KANS
B.E. SMITH CITY ENGINEER
JULY, 1955 PROJ. NO C15-93

TOTAL EXCAV
100.42 cu Yds
100.42 cu Yds

