


S-8


B. M. 116.18 Top of Iron E 2nd St. SHERIDAN
B. M. 117.97 SW Cor. Conc. Pav. No. 304 Mt. Carmel
B. M. 119.46 SE Cor. Conc. Pav. No. 352 N. Mt. Carmel

26 Drives

STATIONING ON E

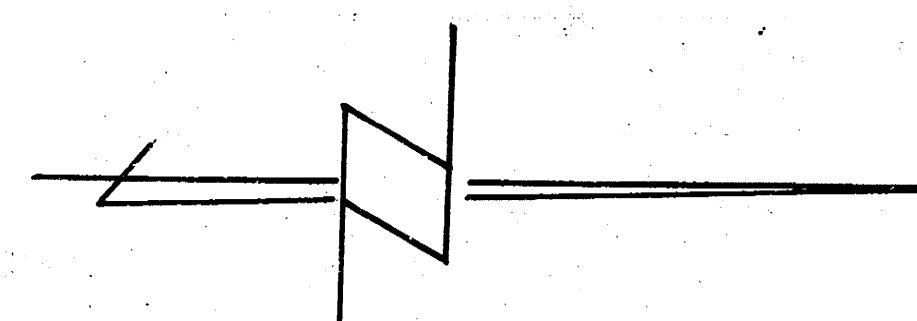

Change at grade to 0.6 m/s side only

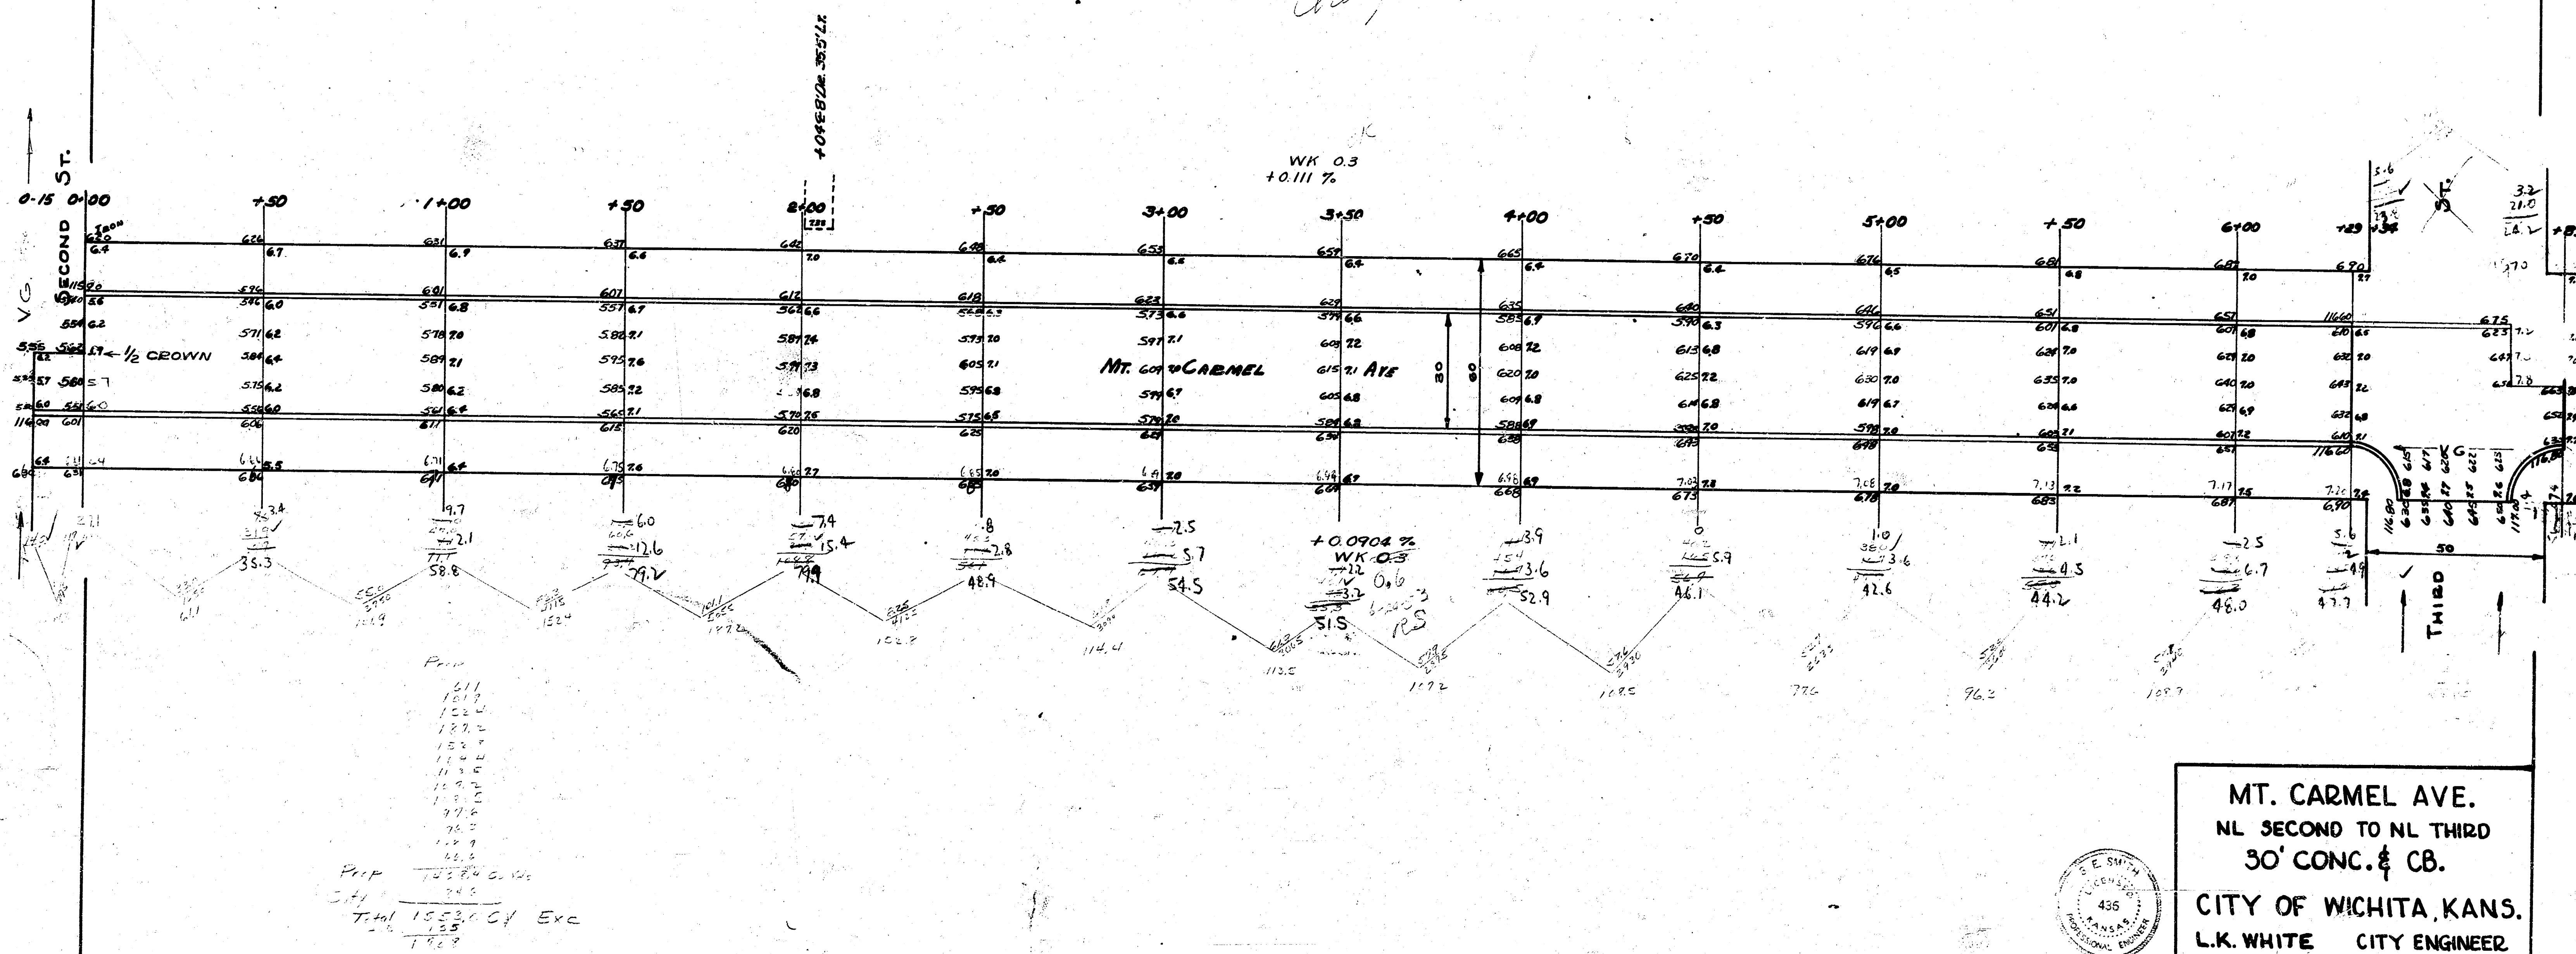

MT. CARMEL AVE.
NL SECOND TO NL THIRD
30' CONC. & CB.
CITY OF WICHITA, KANS.
L.K. WHITE CITY ENGINEER
JAN. 1952 PROJ. NO. C11-309

1 3 1 18