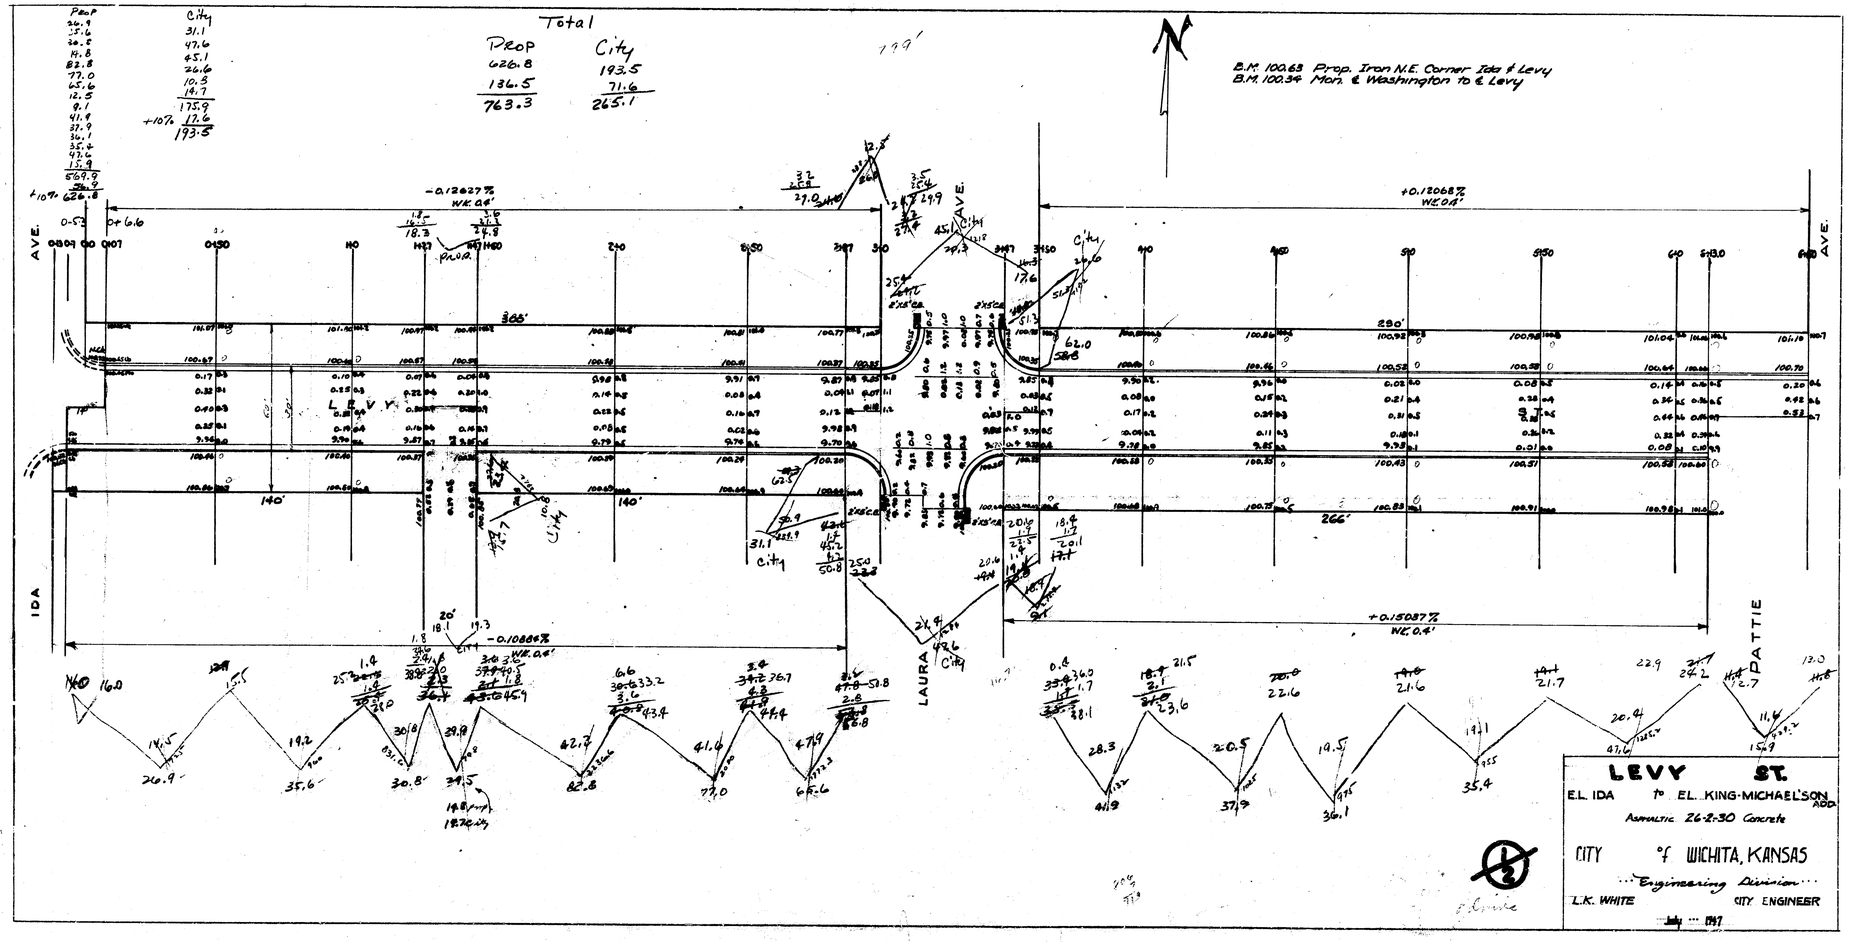
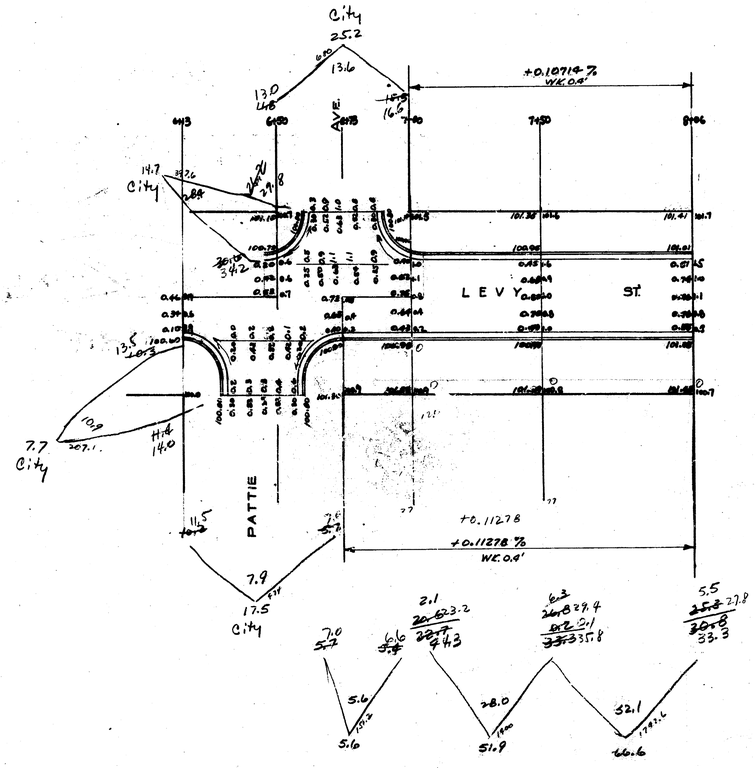

Total
Prop 626.8 136.5 763.3
City 193.5 71.6 265.1
B.M. 100.63 Prop. Iron N.E. Corner Ida & Levy
B.M. 100.34 Mon. & Washington to & Levy
-0.12627% WE 0.4'
+0.12068% WE 0.4'
-0.10886% WE 0.4'
+0.15087% WE 0.4'
IDA AVE.
LAURA AVE.
PATTIE AVE.
LEVY
LEVY ST.
E.L. IDA to E.L. KING-MICHAEL'SON ADD.
Asphaltic 26-2-30 Concrete
CITY of WICHITA, KANSAS
...Engineering Division...
L.K. WHITE CITY ENGINEER
July ... 1947



PROP	City
5.6	7.7
51.9	17.5
66.6	19.7
124.1	25.2
+10% 12.4	65.1
136.5	+10% 6.5
	71.6

2/2

V 15 3 1