



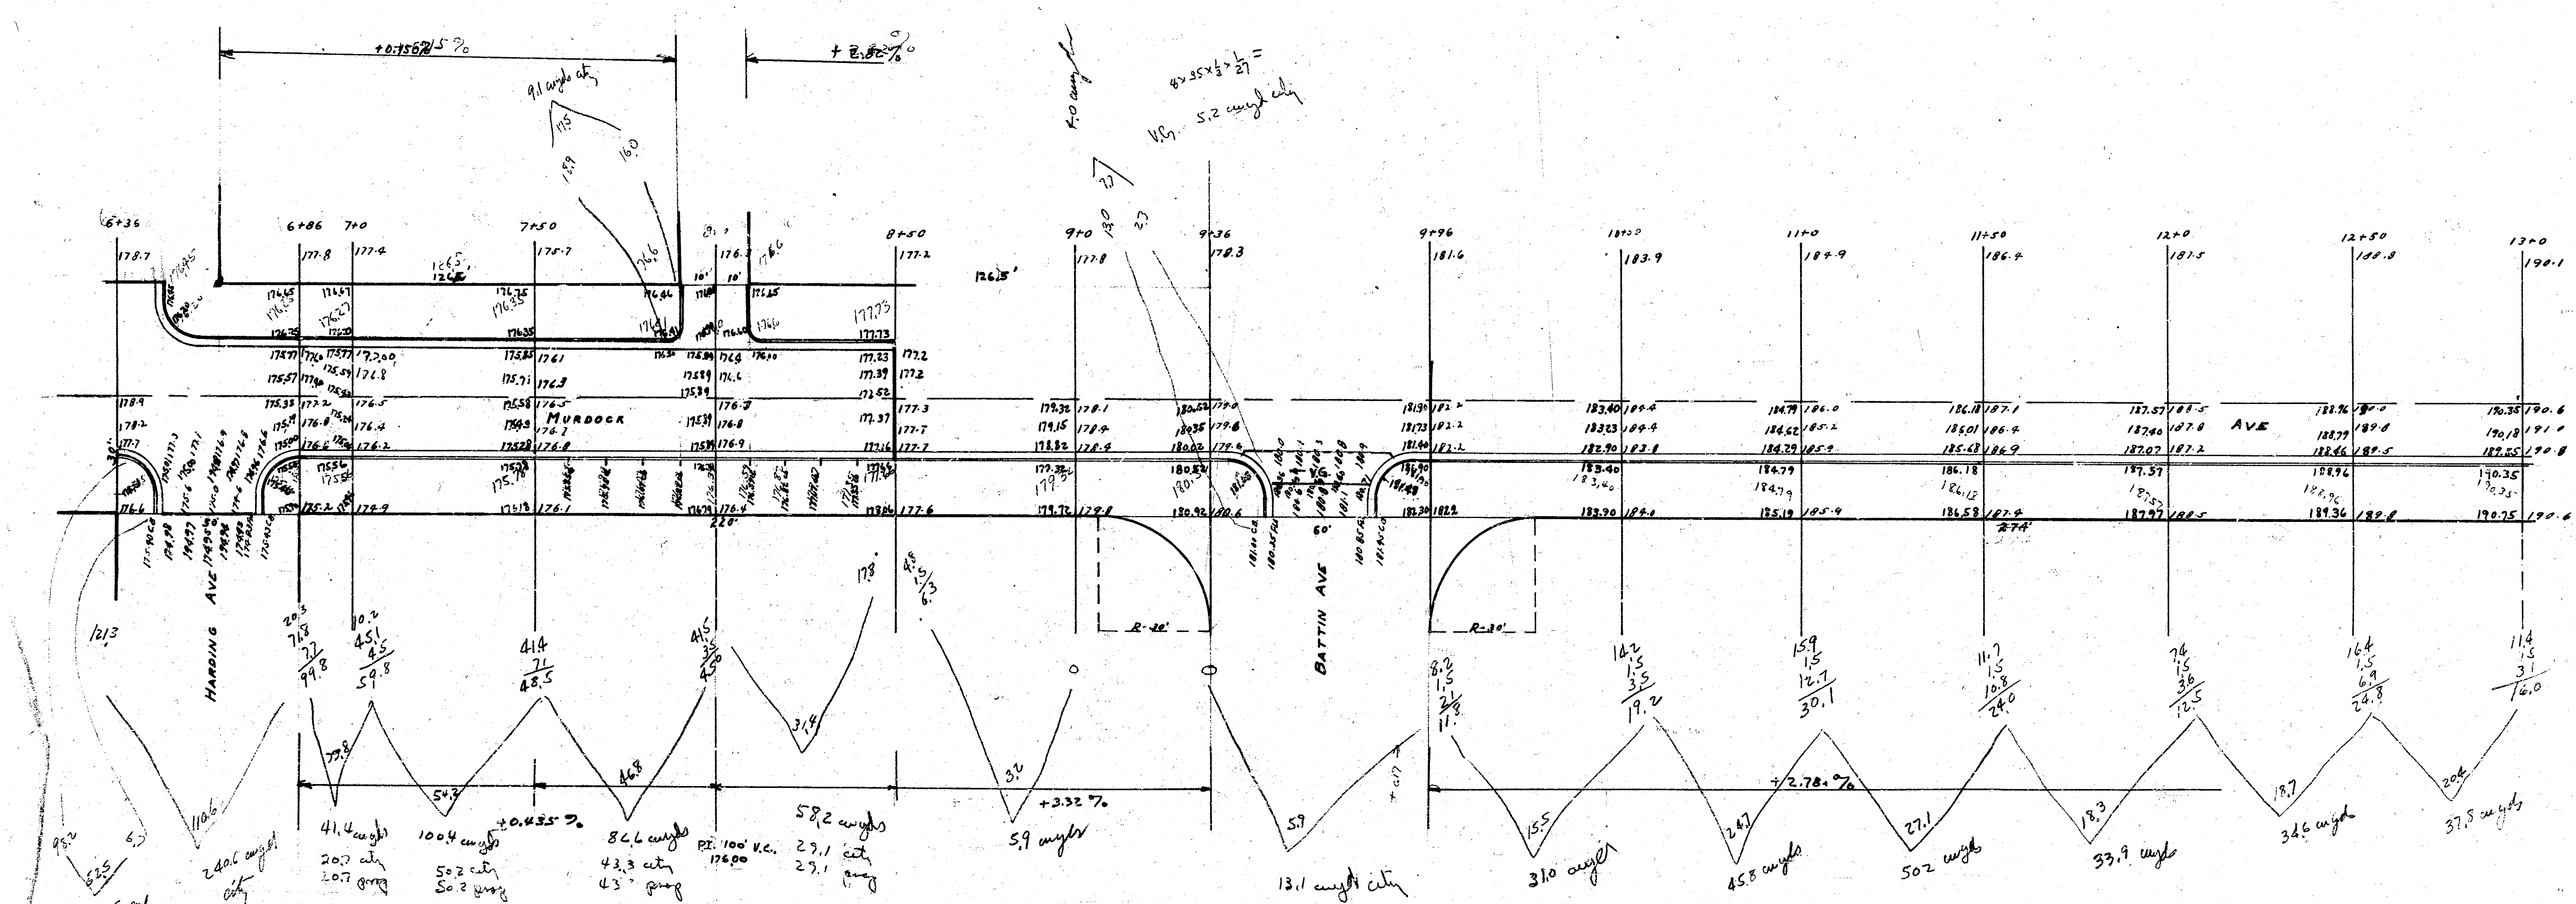


Build 6" concrete pavement and curb and gutter
on both sides of street from Sta 6+03 to Sta 8+50
Surface of pavement will be on warped flat
plane to take drainage across Murdock.
P215

1942
MURDOCK AVE - S.S. - E.L. OLIVER TO W.L. MILLER
CB + GTR

Final X Sec.
Book 36, P. 49
14-42

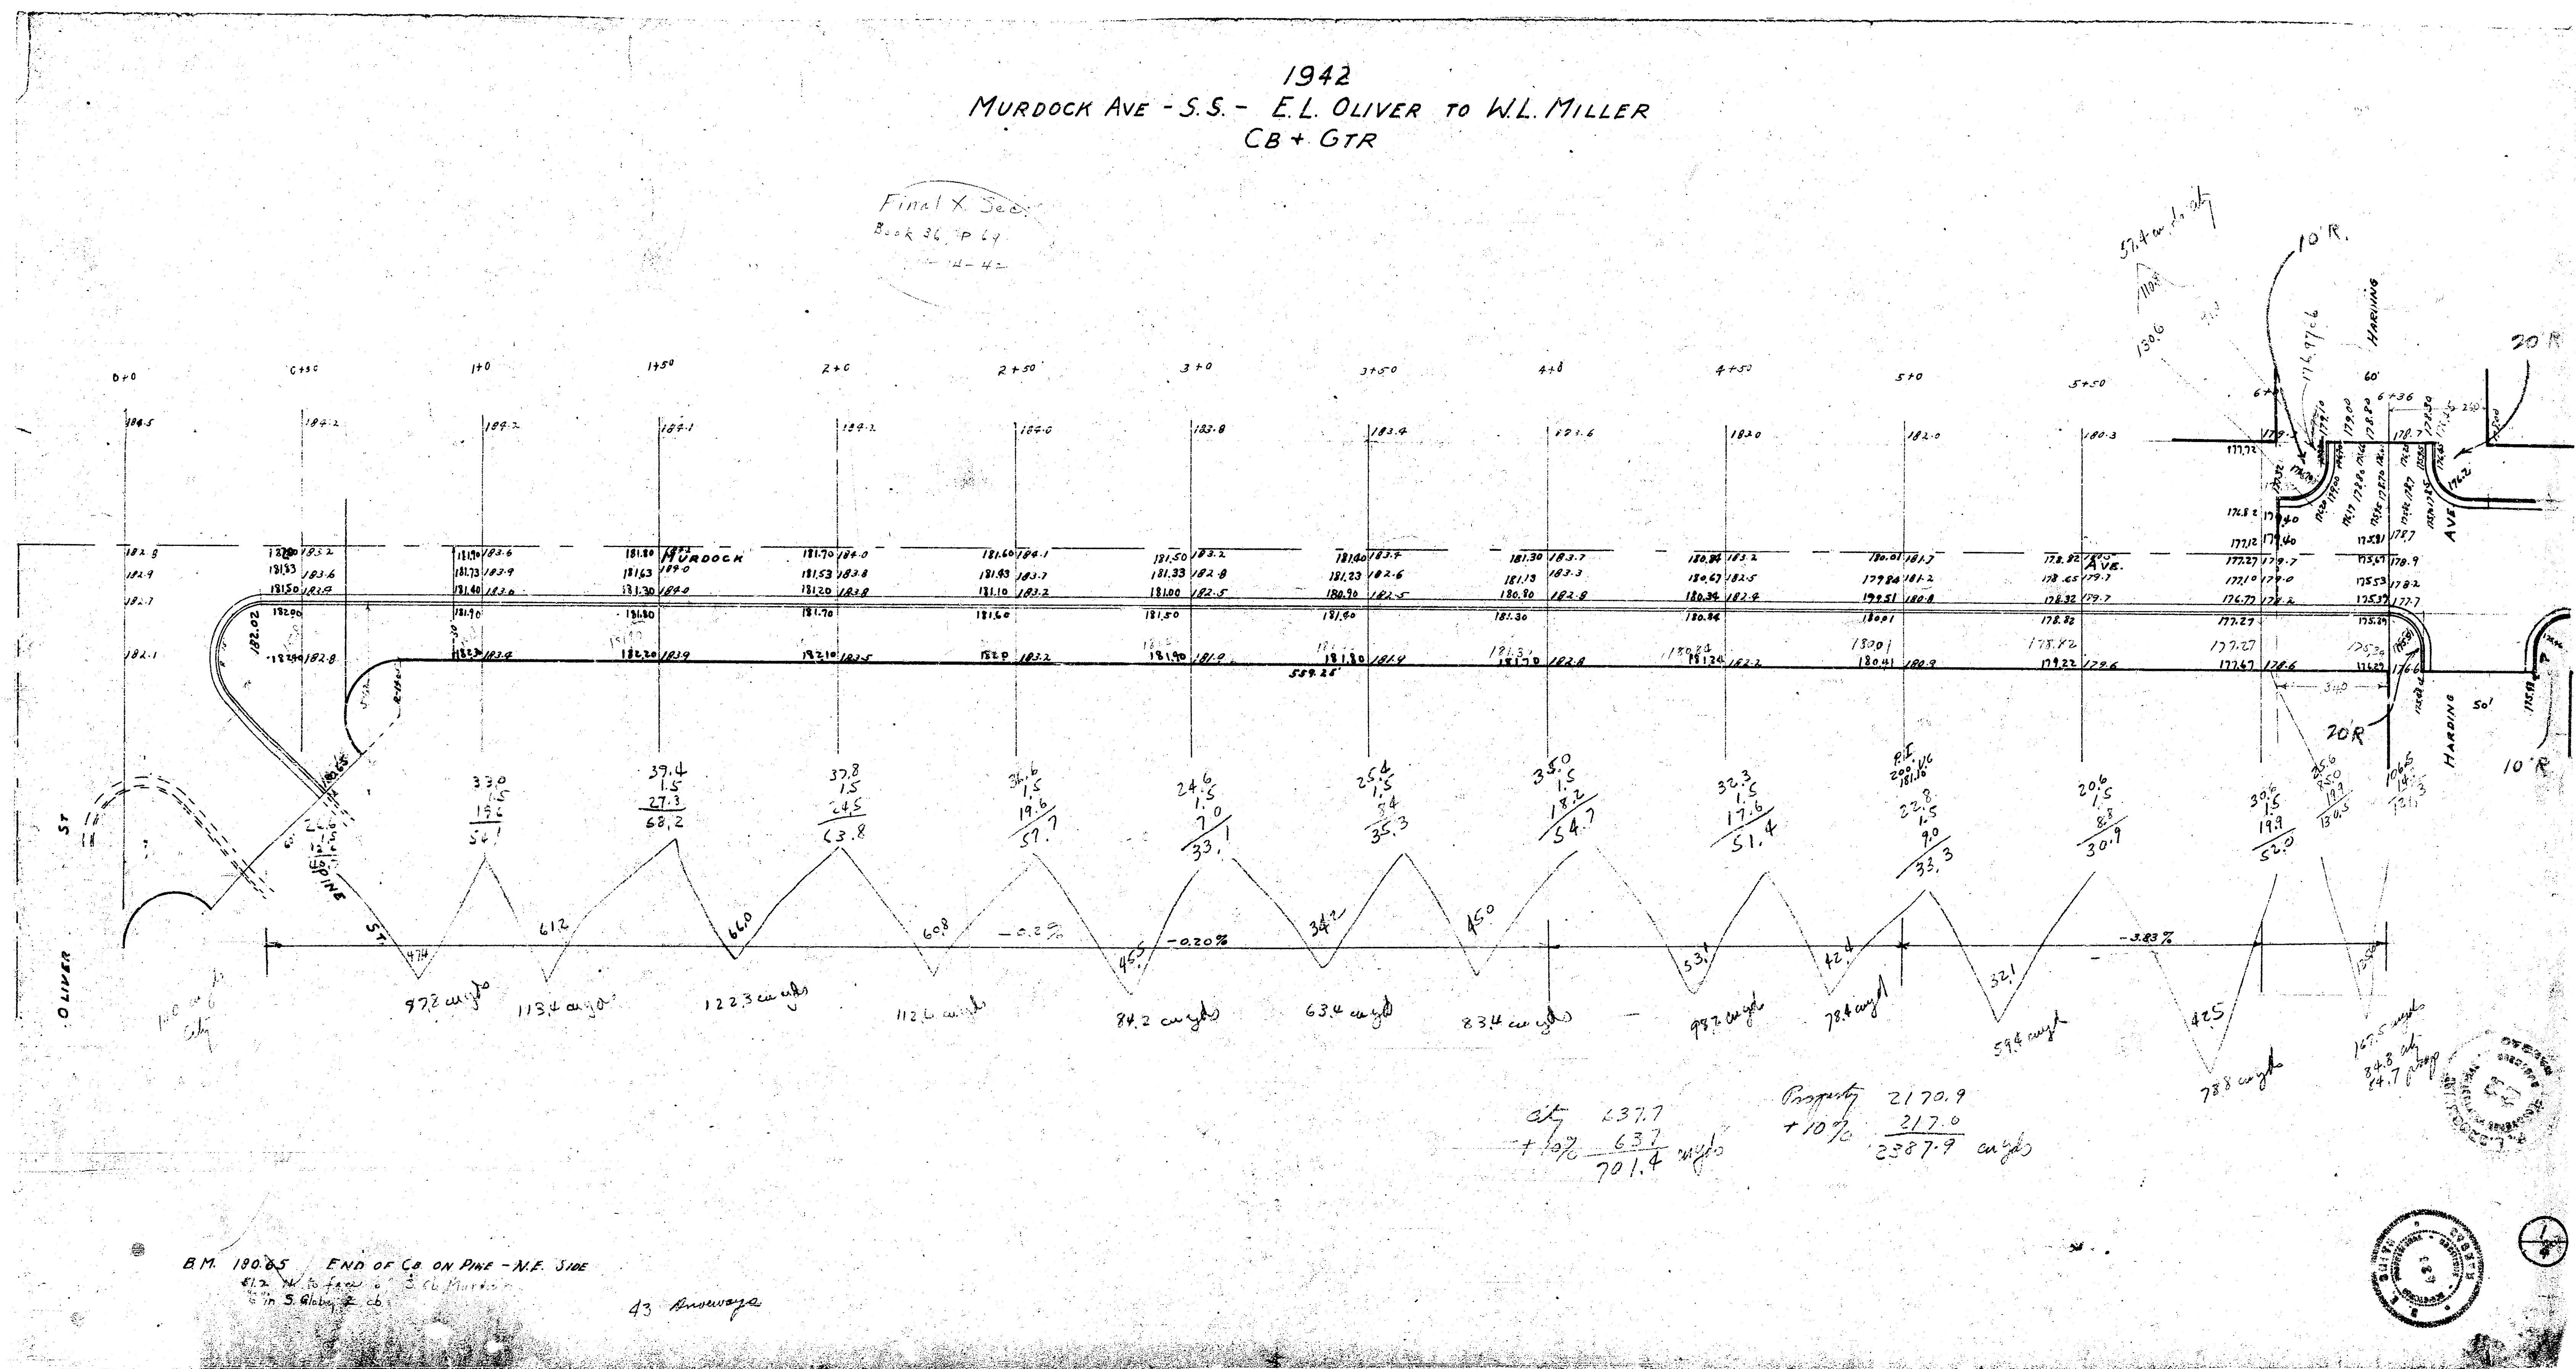

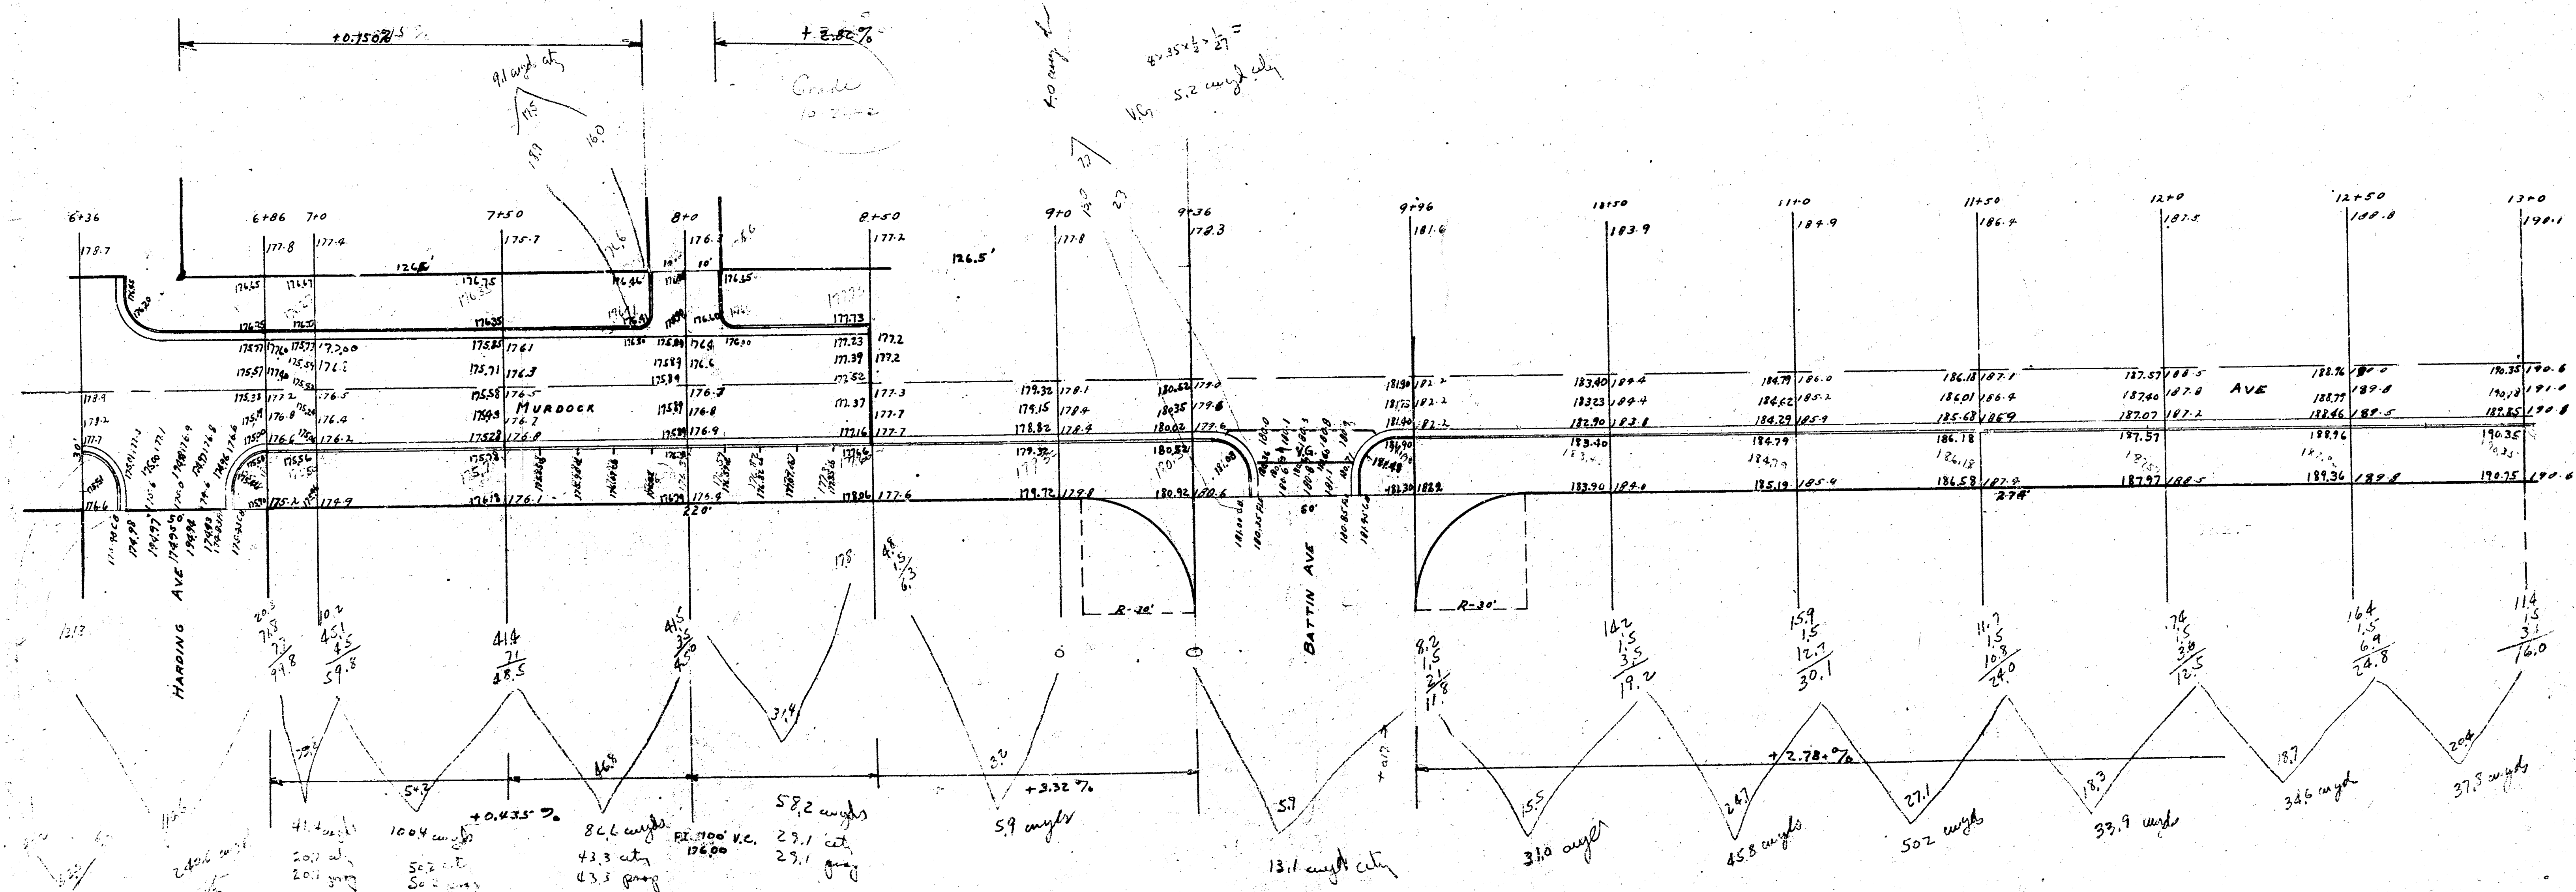

Build 6" concrete pavement and curb and gutter
in both directions from Sta 6+03 to Sta 8+50.
Surface of pavement will be in warped flat
plane to the drainage across Murdock.
P.D.

