


1942
MURDOCK AVE - S.S. - E.L. OLIVER TO W.L. MILLER
CB + GTR


Final X Sec.
Book 36, P. 49
14-42

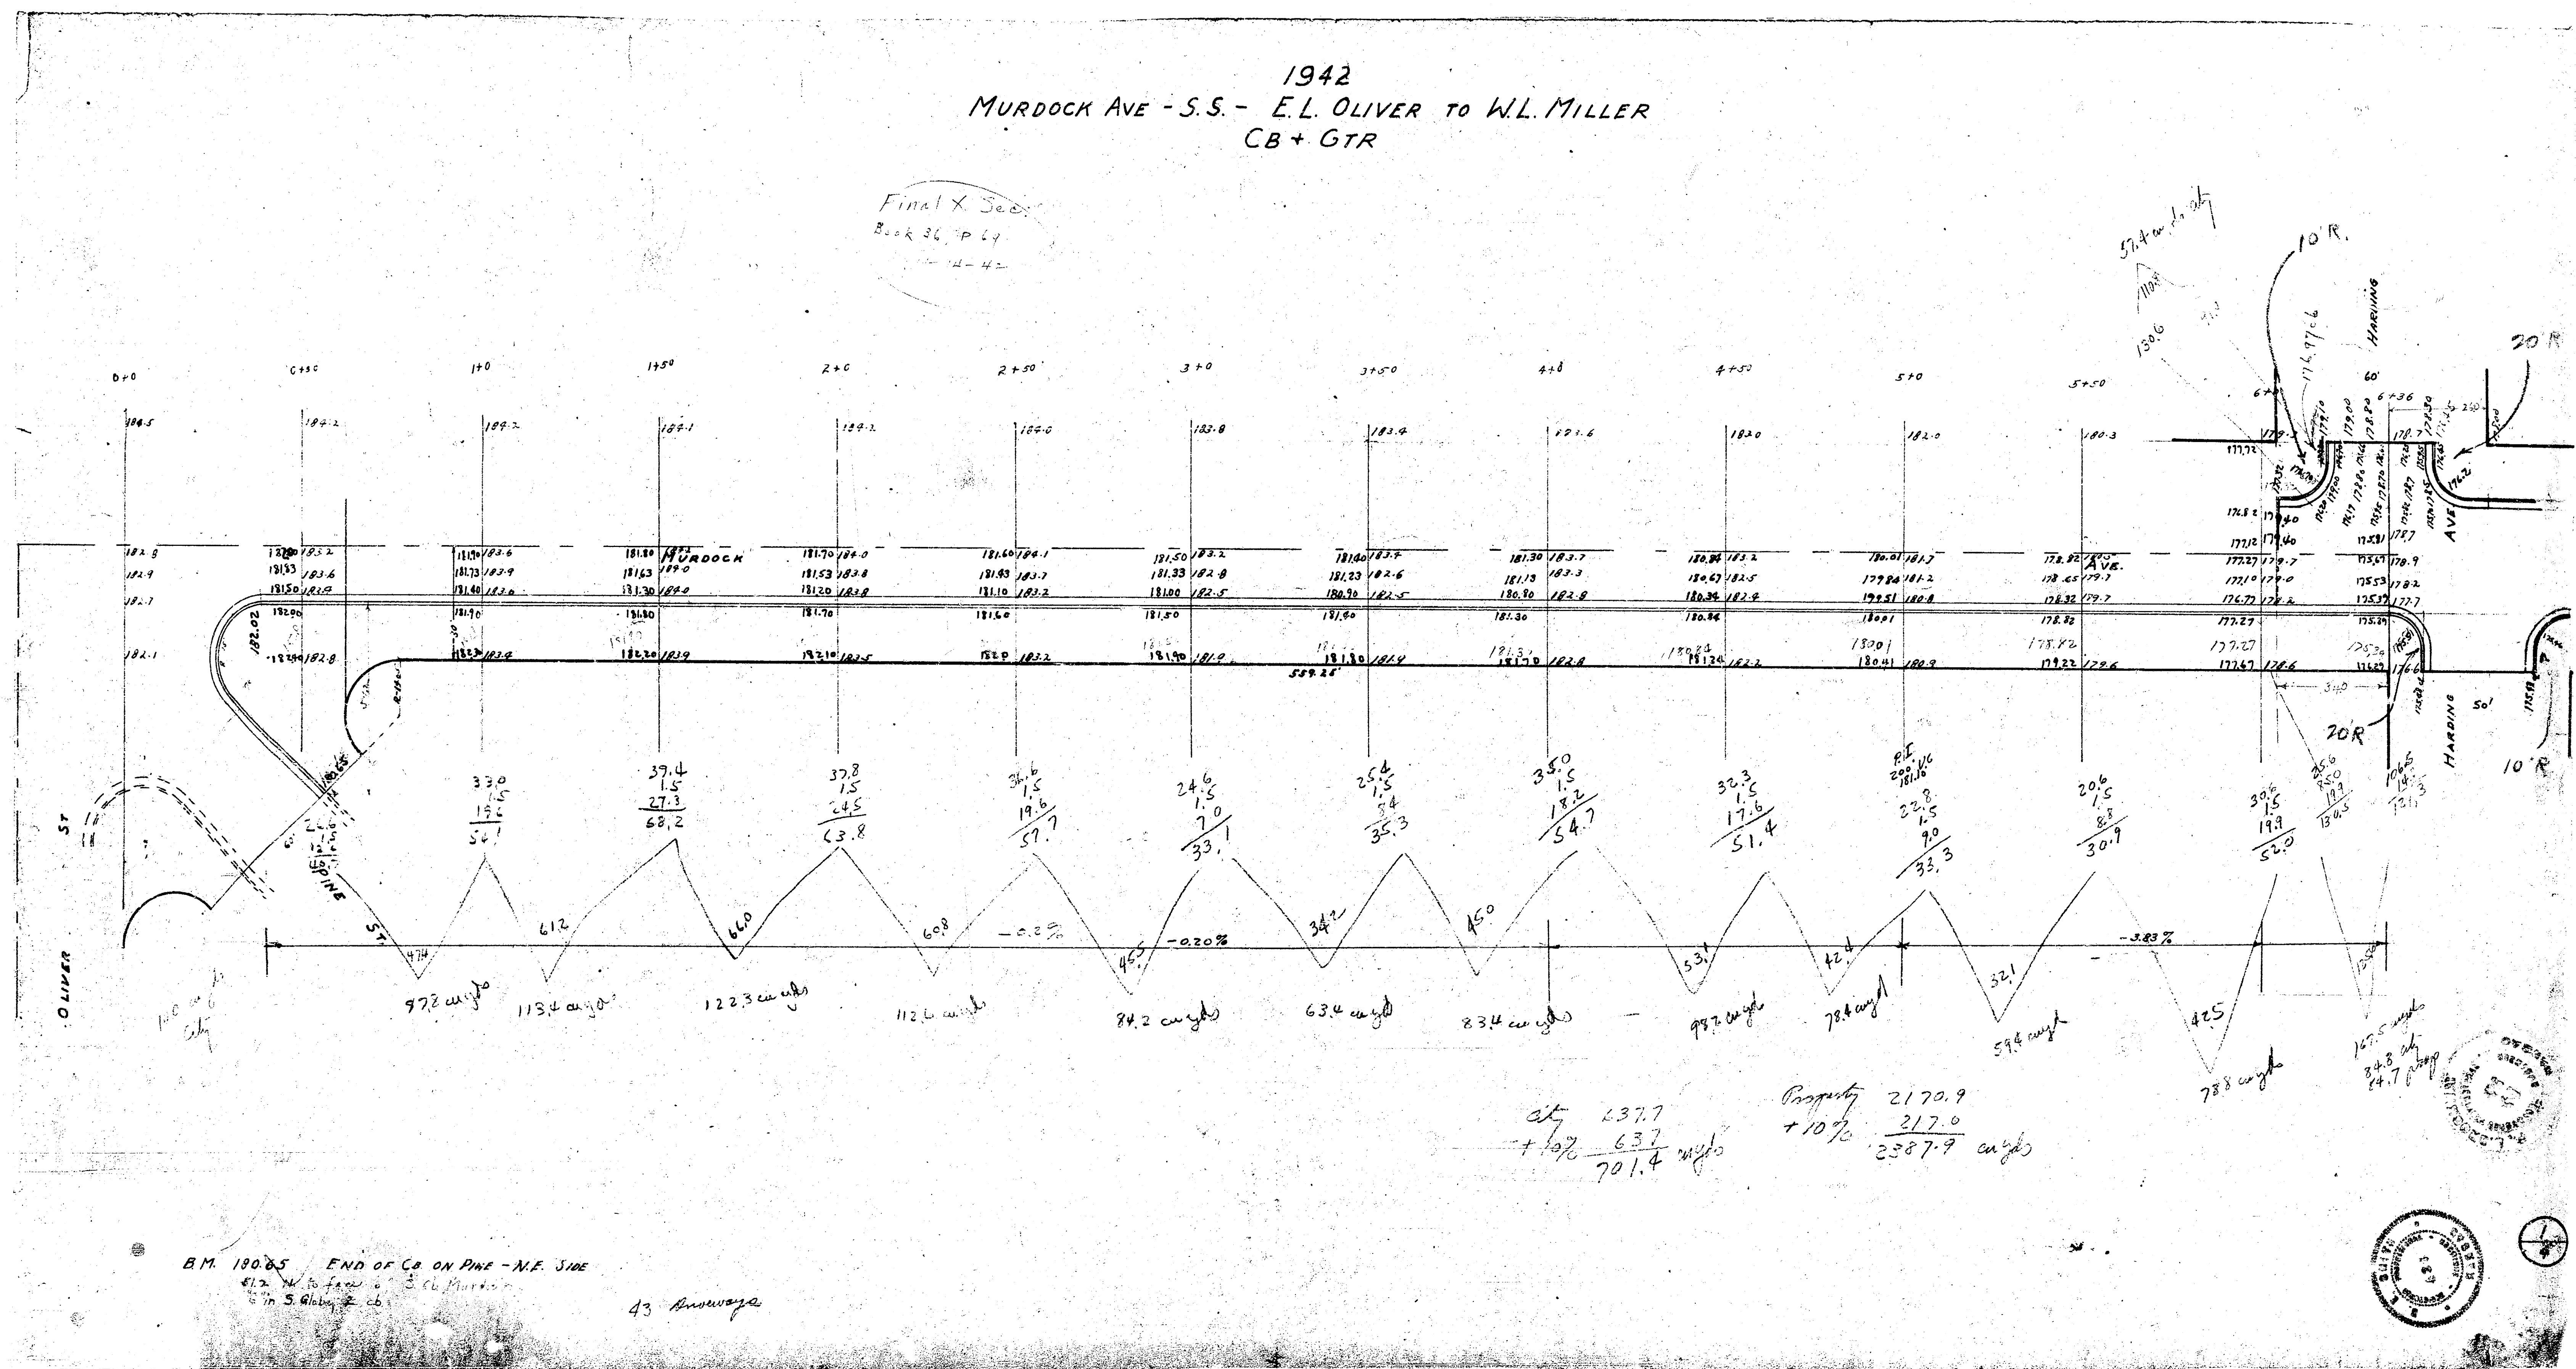

E.L. to form 3 1/2 ft. curb
in S. Right of Way

43 Runways



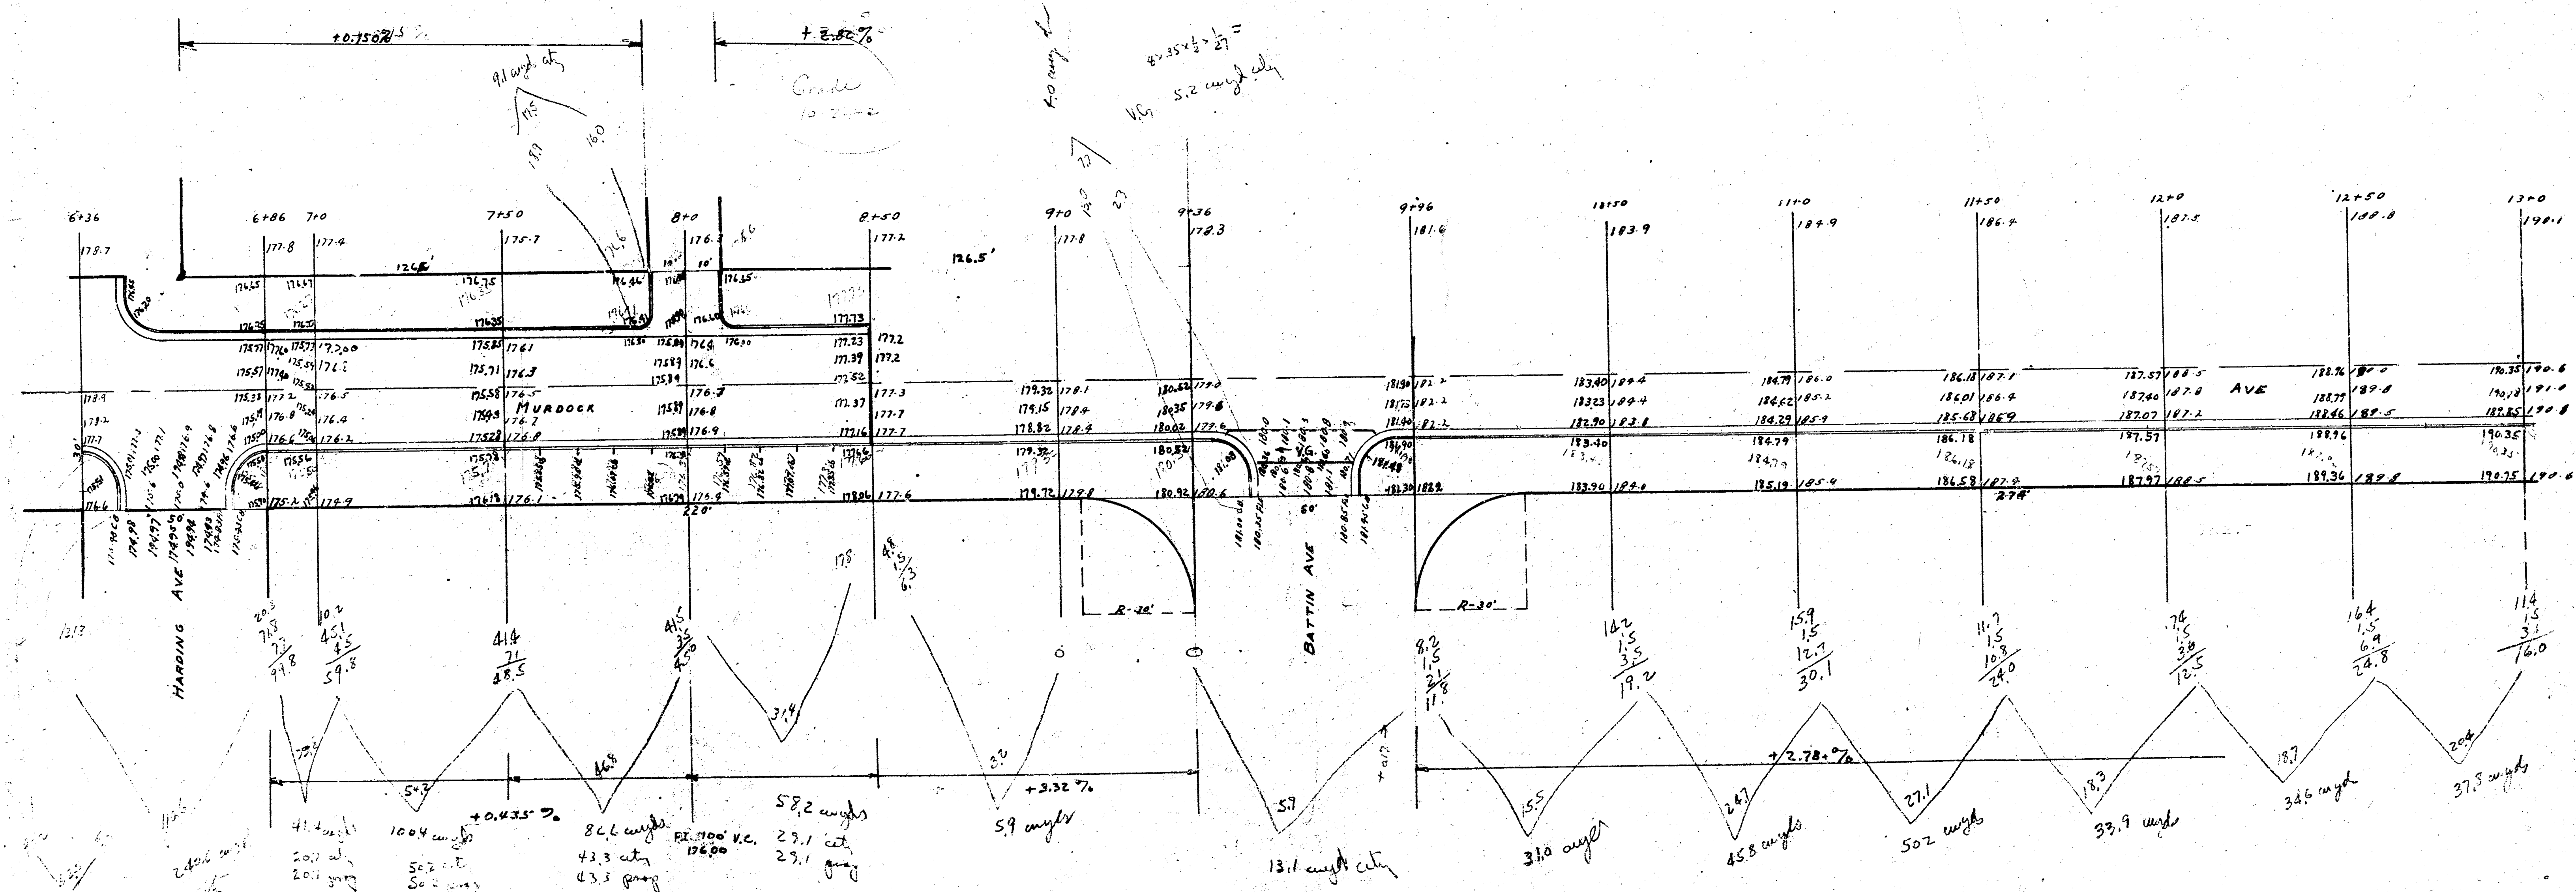

Build 6" concrete pavement and curb and gutter
in both directions from Sta 6+03 to Sta 8+50.
Surface of pavement will be on warped flat
plane to the drainage across Muddock.
P.D.

