



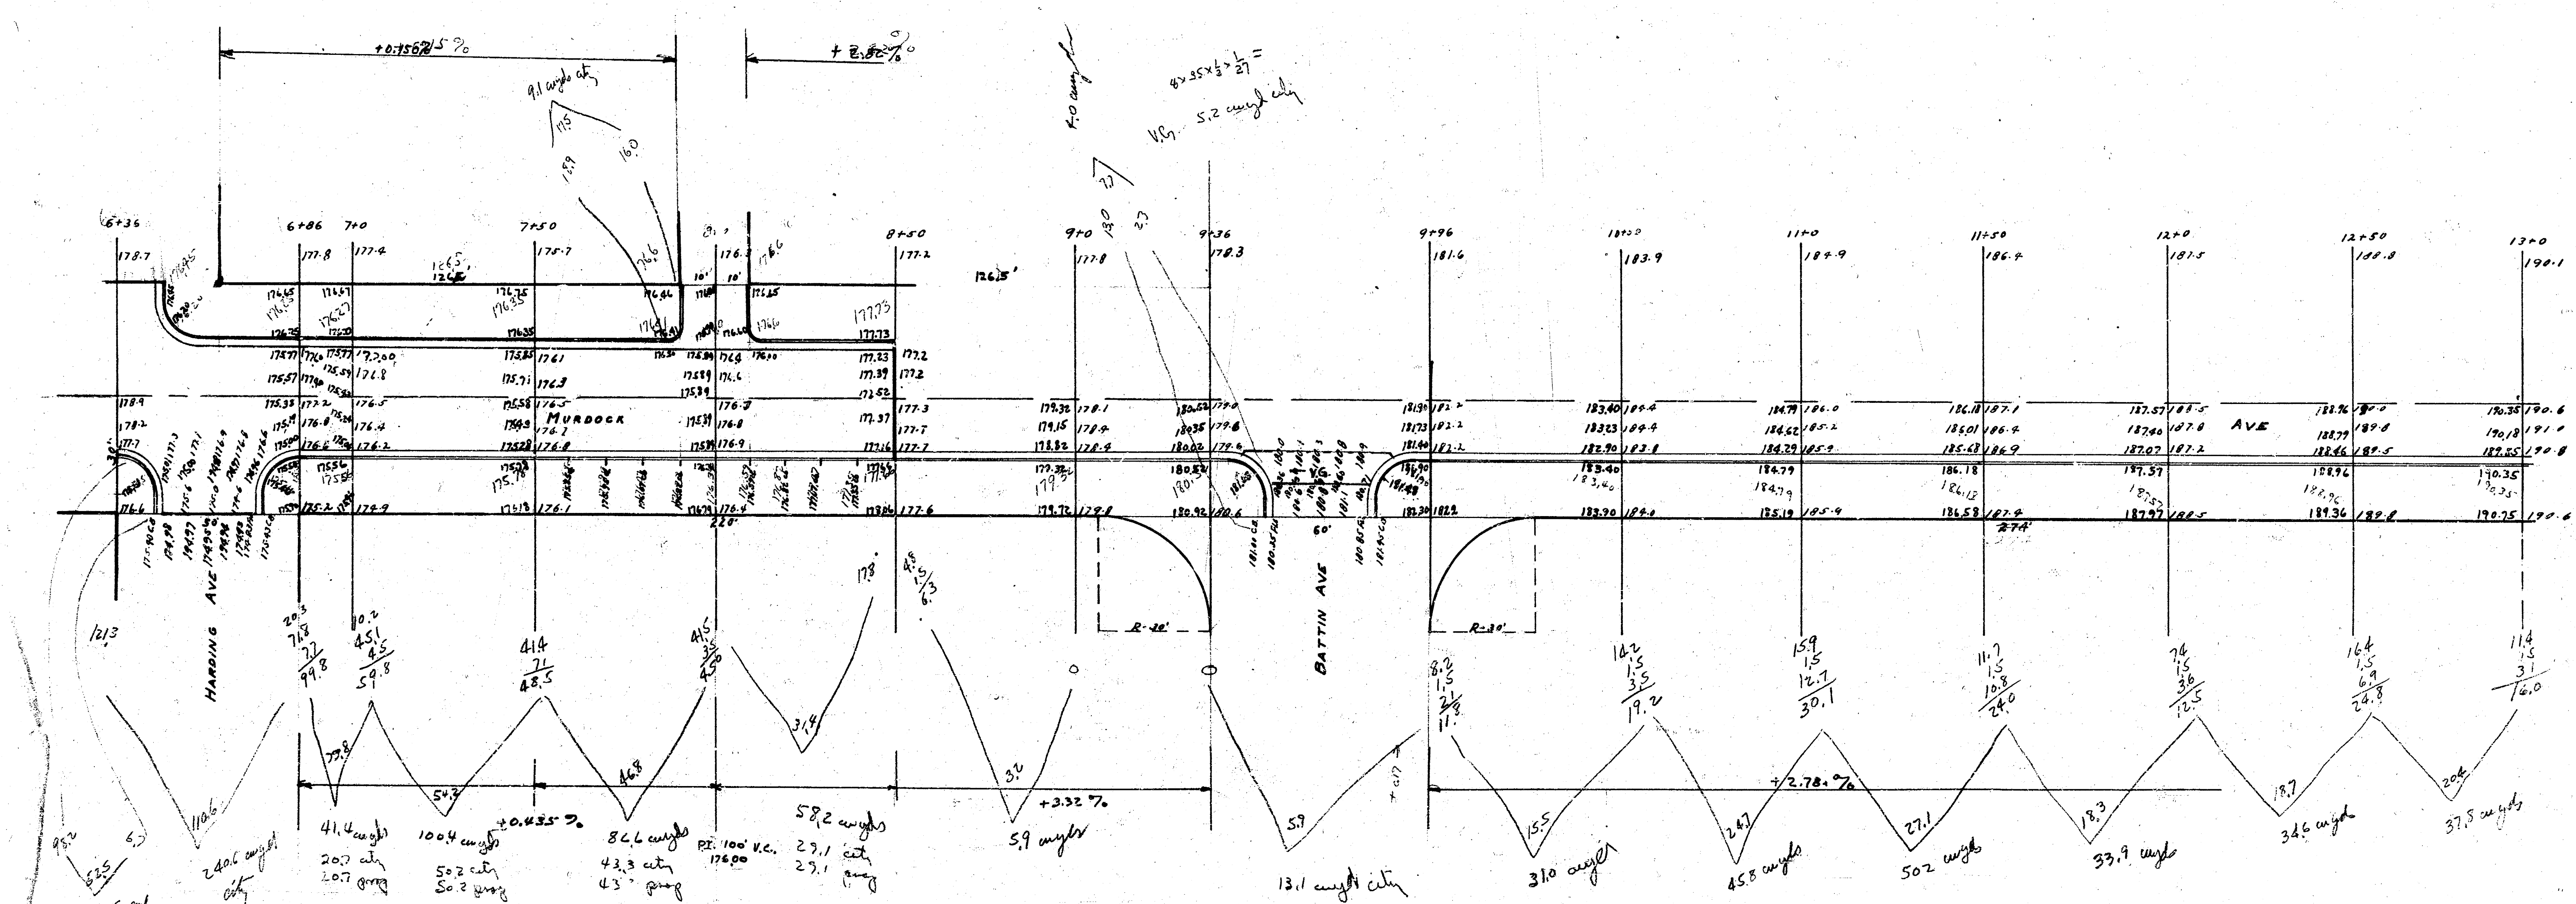

Build 6" concrete pavement and curb and gutter
 on both sides of street from Sta 6+03 to Sta 8+50
 Surface of pavement will be on warped flat
 plane to take drainage across Murdoch.
 P215

1942
MURDOCK AVE - S.S. - E.L. OLIVER TO W.L. MILLER
CB + GTR


Final X Sec.
Book 36, P. 49
14-42

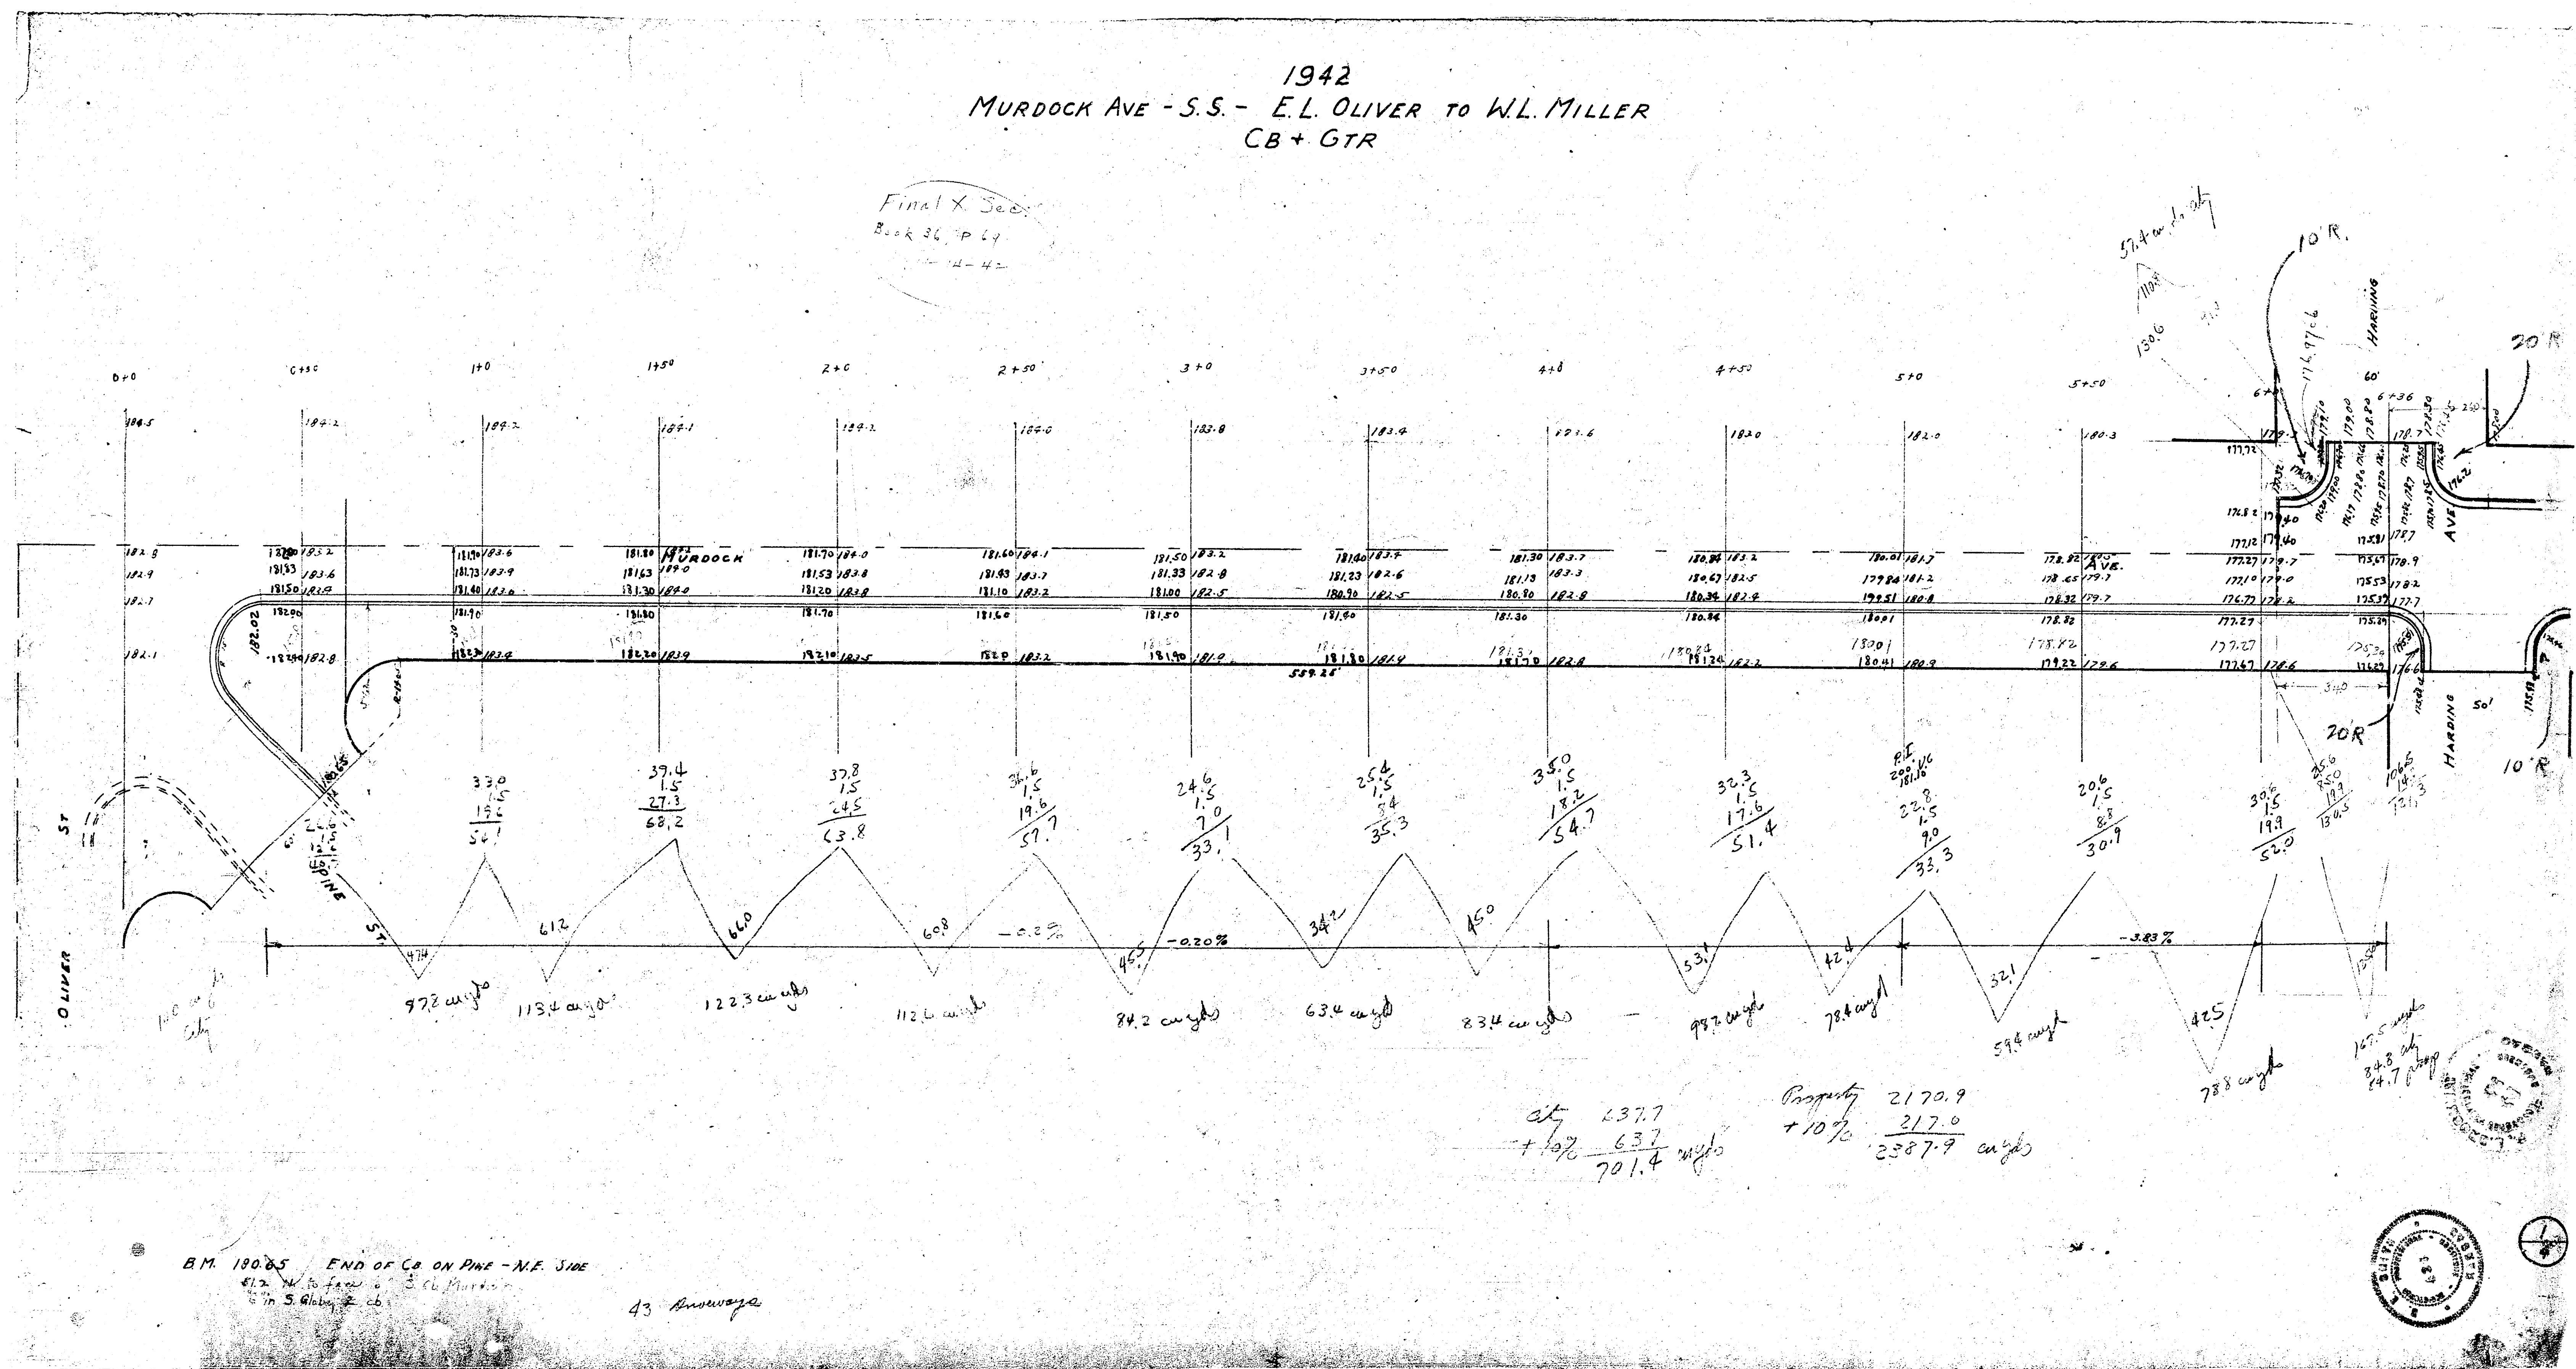

B.M. 190.85 END OF CB ON PINE - N.E. SIDE
E.L. OLIVER TO W.L. MILLER
in S. 6th St. to

43 Runways



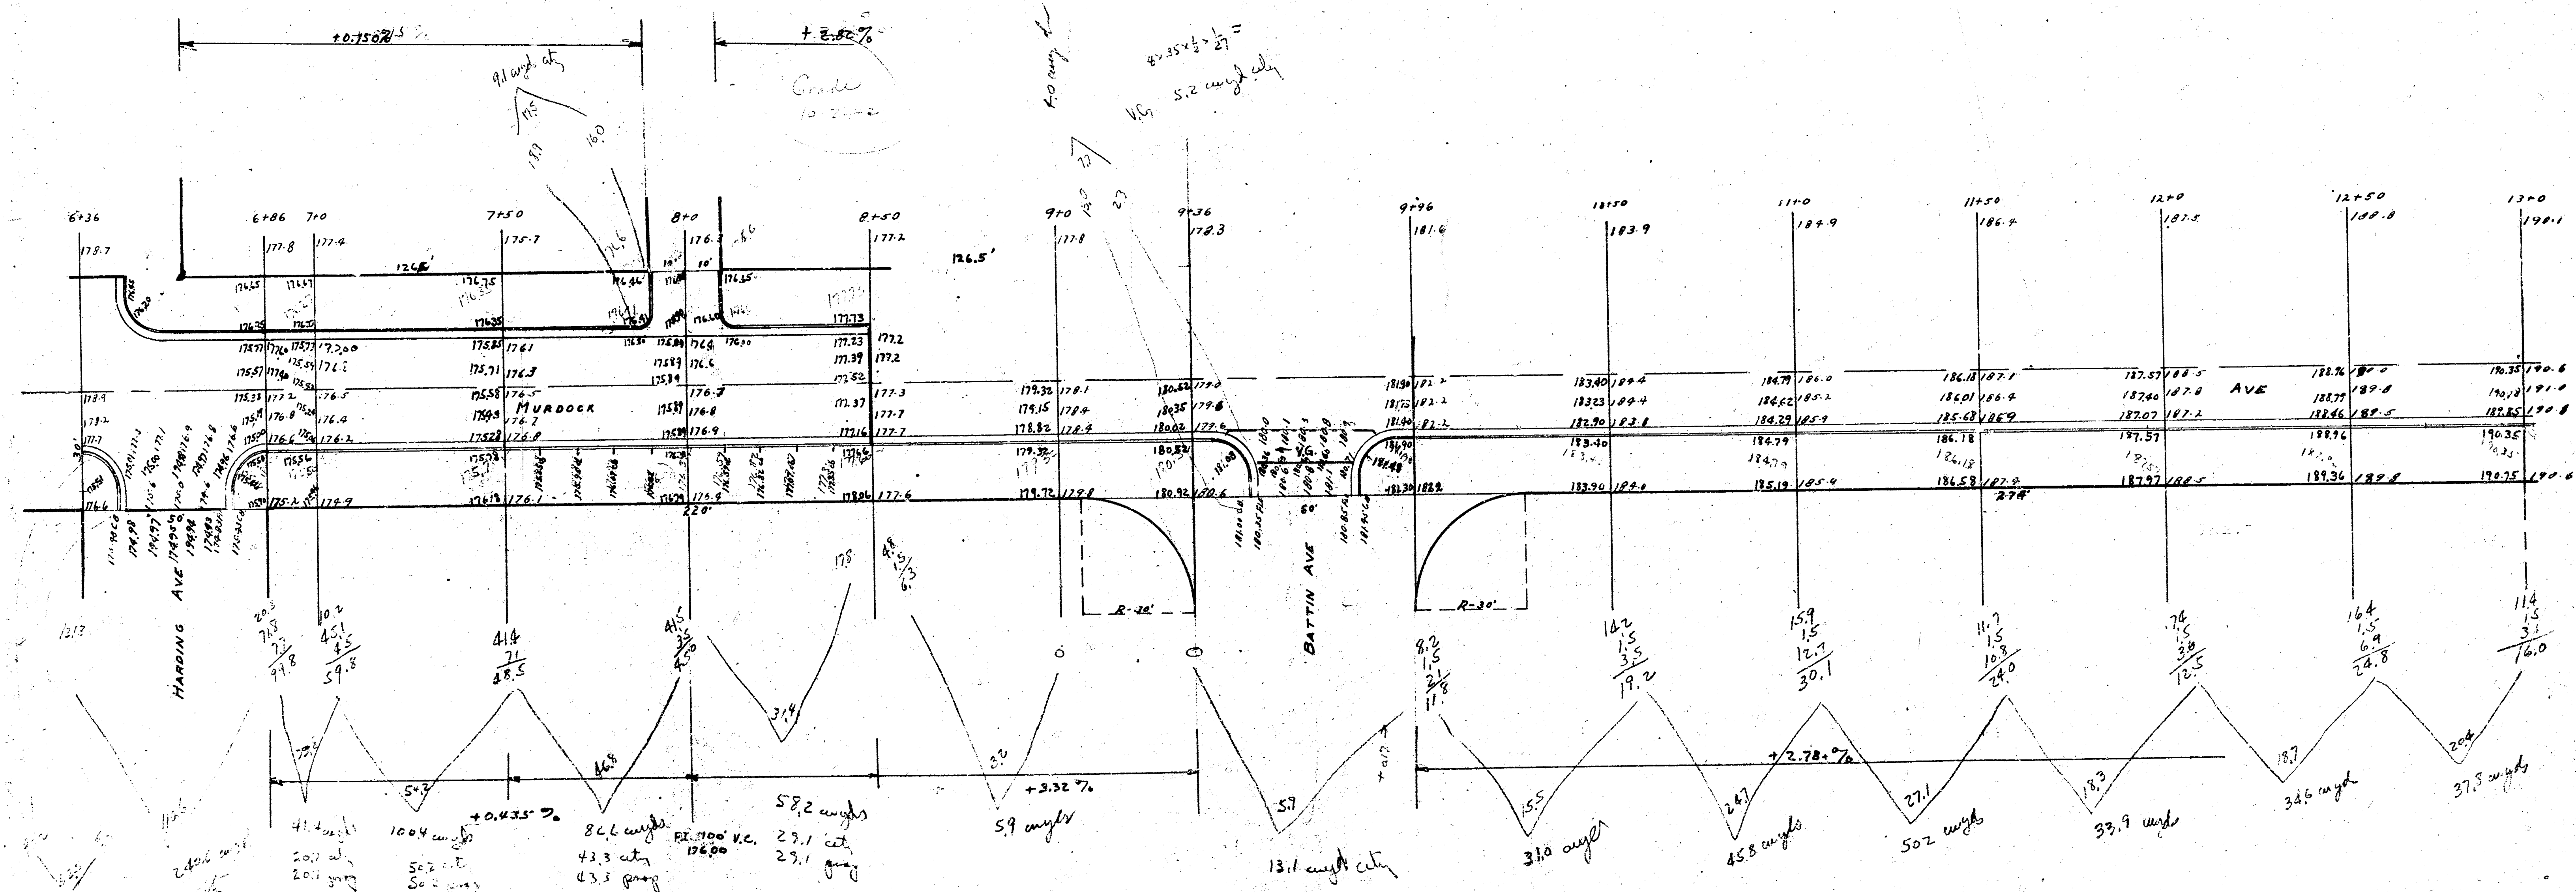

Build 6" concrete pavement and curb and gutter
in both directions from Sta 6+03 to Sta 8+00.
Surface of pavement will be in warped flat
plane to the drainage across Murdock.
P.D.

