


B.M. 122.65 "R" IN FITCHIE N. END CB. RAD., N.E. COR. MCGOMAS & MURDOCK.

EXCAVATION	
Prod.	Qty.
13,12.8	26.6
13,22.8	2.8
13,10.1	5.7

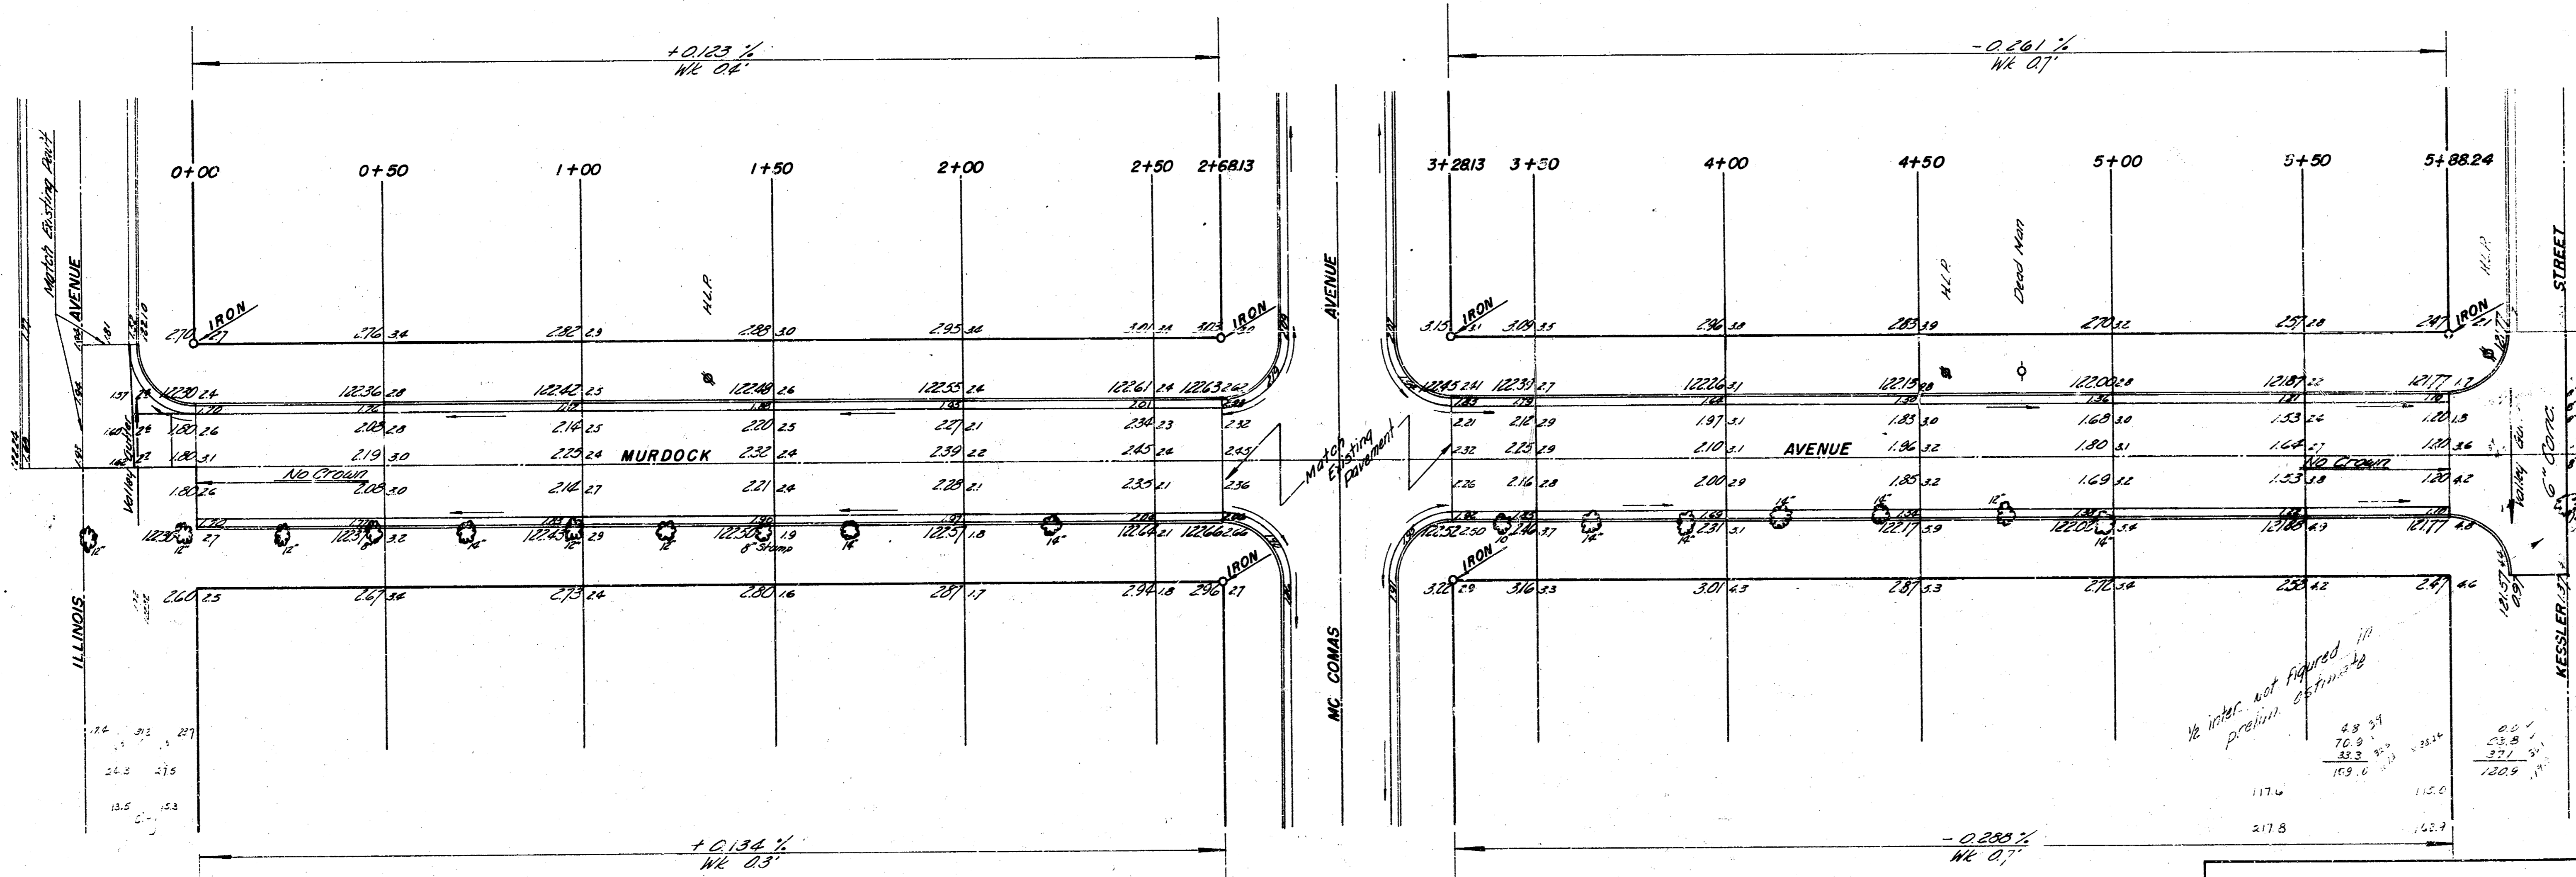

Survey J. H. ...
 City Engineer

67	76	81	17	32	27	00
18.6	18.0	34.2	26.0	15.4	17.7	18.6
6.1	15.9	3.3	00	0.0	0.0	0.0
51.4	64.3	38.4	17.7	18.4	20.4	18.4
59.0	32.5	33.2	23.1	19.3	19.5	
169.3	97.2	61.5	42.8	36.1	18.1	

New Grade set for this block - Exca incorrect.

0.0	5.0	12.0	12.4	9.7
18.6	46.0	62.3	71.3	72.4
0.0	0.0	28.3	63.2	82.0
18.2	61.0	103.1	127.4	124.1
30.8	82.0	115.3	124.7	
32.2	151.5	212.5	234.4	

MURDOCK
 E.L. ILLINOIS - W.L. KESSLER
26' 2' 30" AC.
 CITY OF WICHITA, KANSAS
 B.E. SMITH CITY ENGINEER
 DATE: APRIL 1960, PROJ. NO. C19-215