


30' Concrete

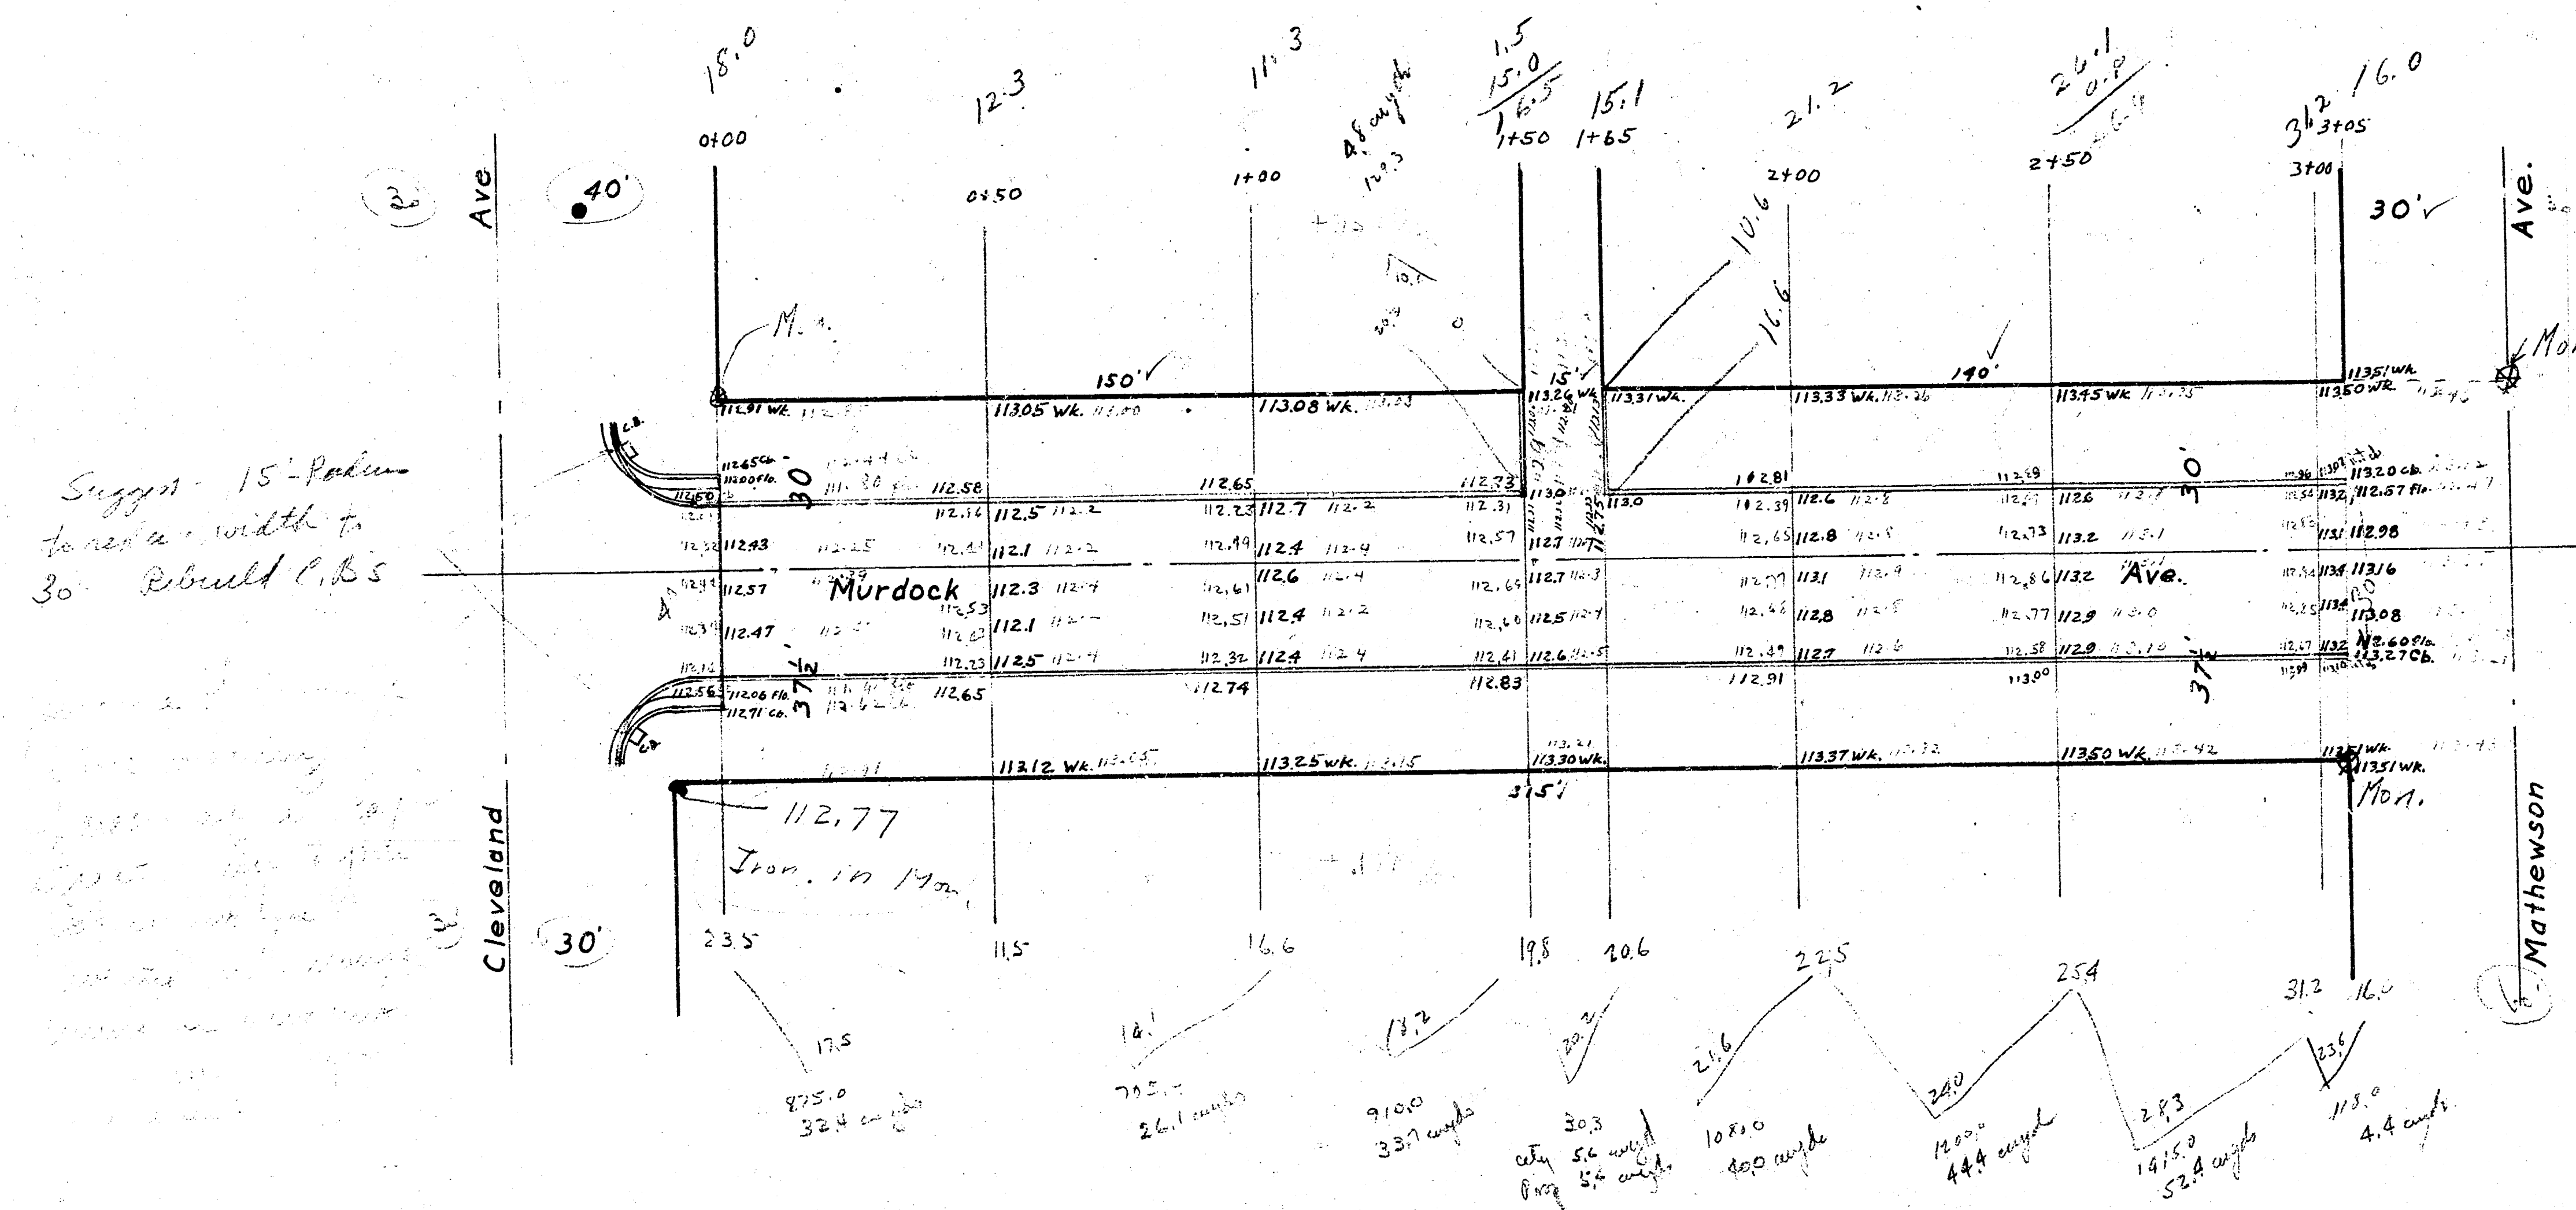

Property = 239.0
 + 10% = 23.9
 262.9

$0.2 = 10\%$
 $2.70\% = \frac{1.0}{11.5}$