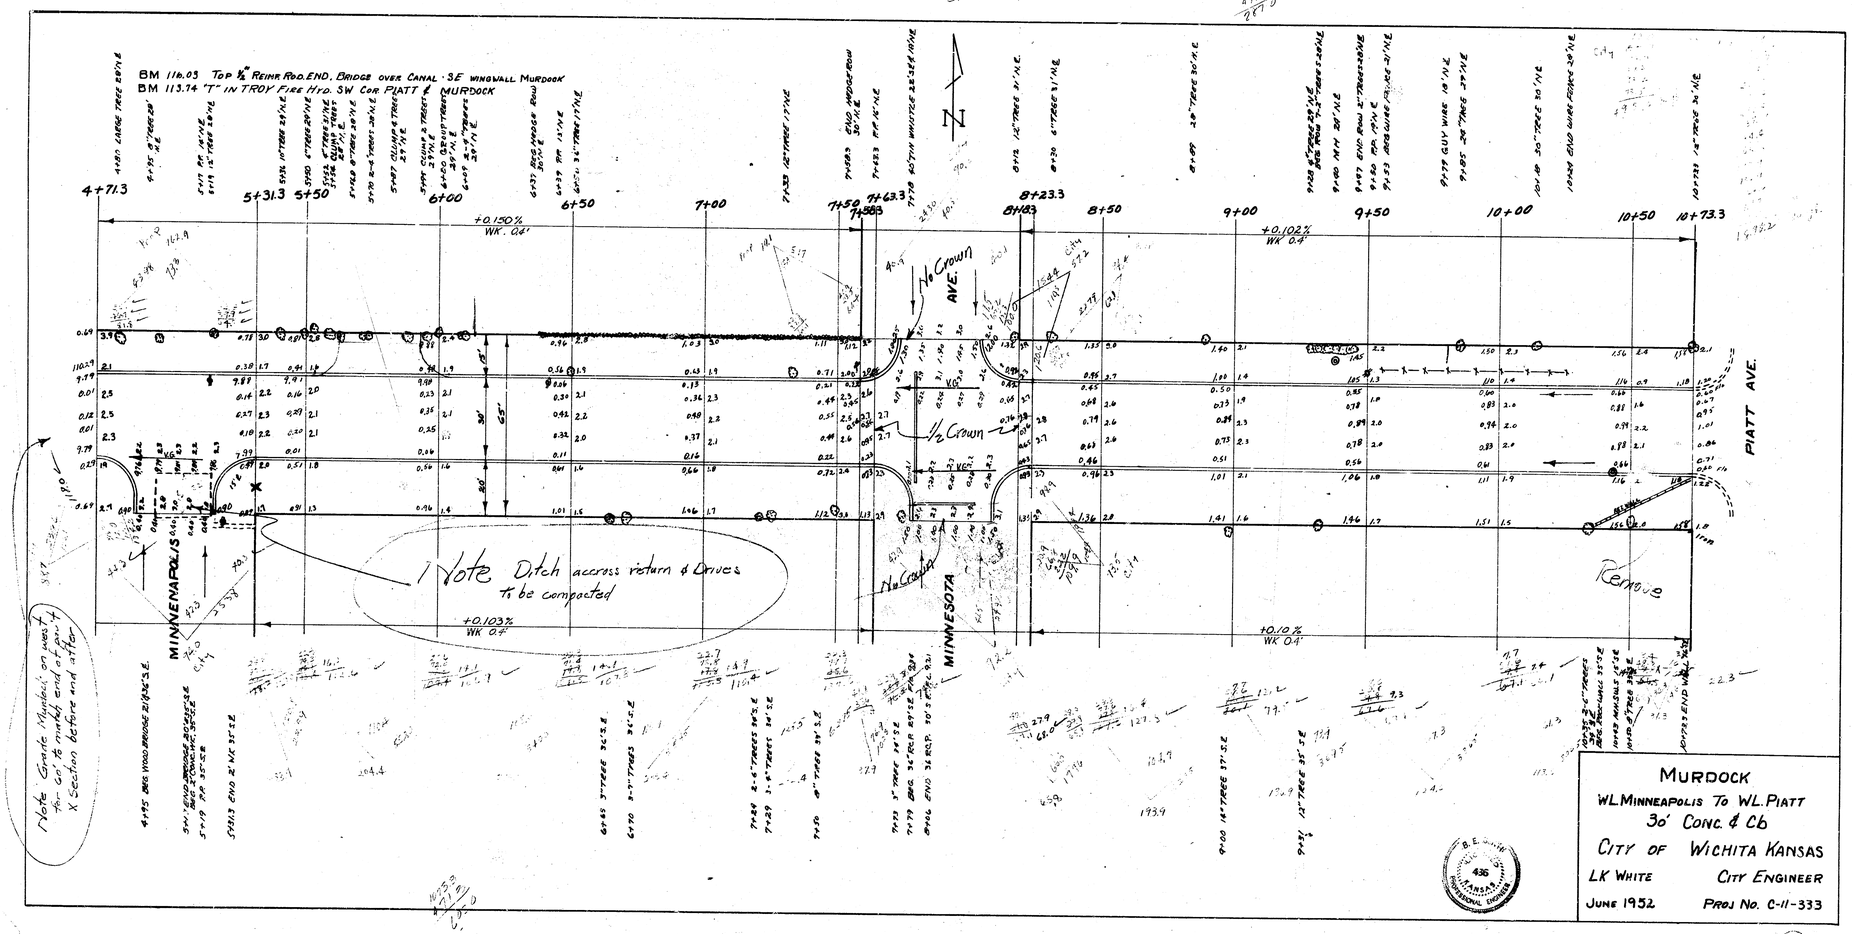

MURDOCK
W.L. MINNEAPOLIS TO W.L. PIATT
30' CONC. & CB
CITY OF WICHITA KANSAS
L.K. WHITE — CITY ENGINEER
JUNE 1952 — PROJ NO. C-11-333