


18-179-Y
SEALED
8-23-58
CHAS. J. JOHNSON

D.M. 128.07 RR SPIKE E.S. HLP. NW. OTT + LYNNURST
BASE LINE = 500' STREET R/W.

SCALE 1"=20'

BASEMENT WINDOW SILL
HOUSE DOOR SILL

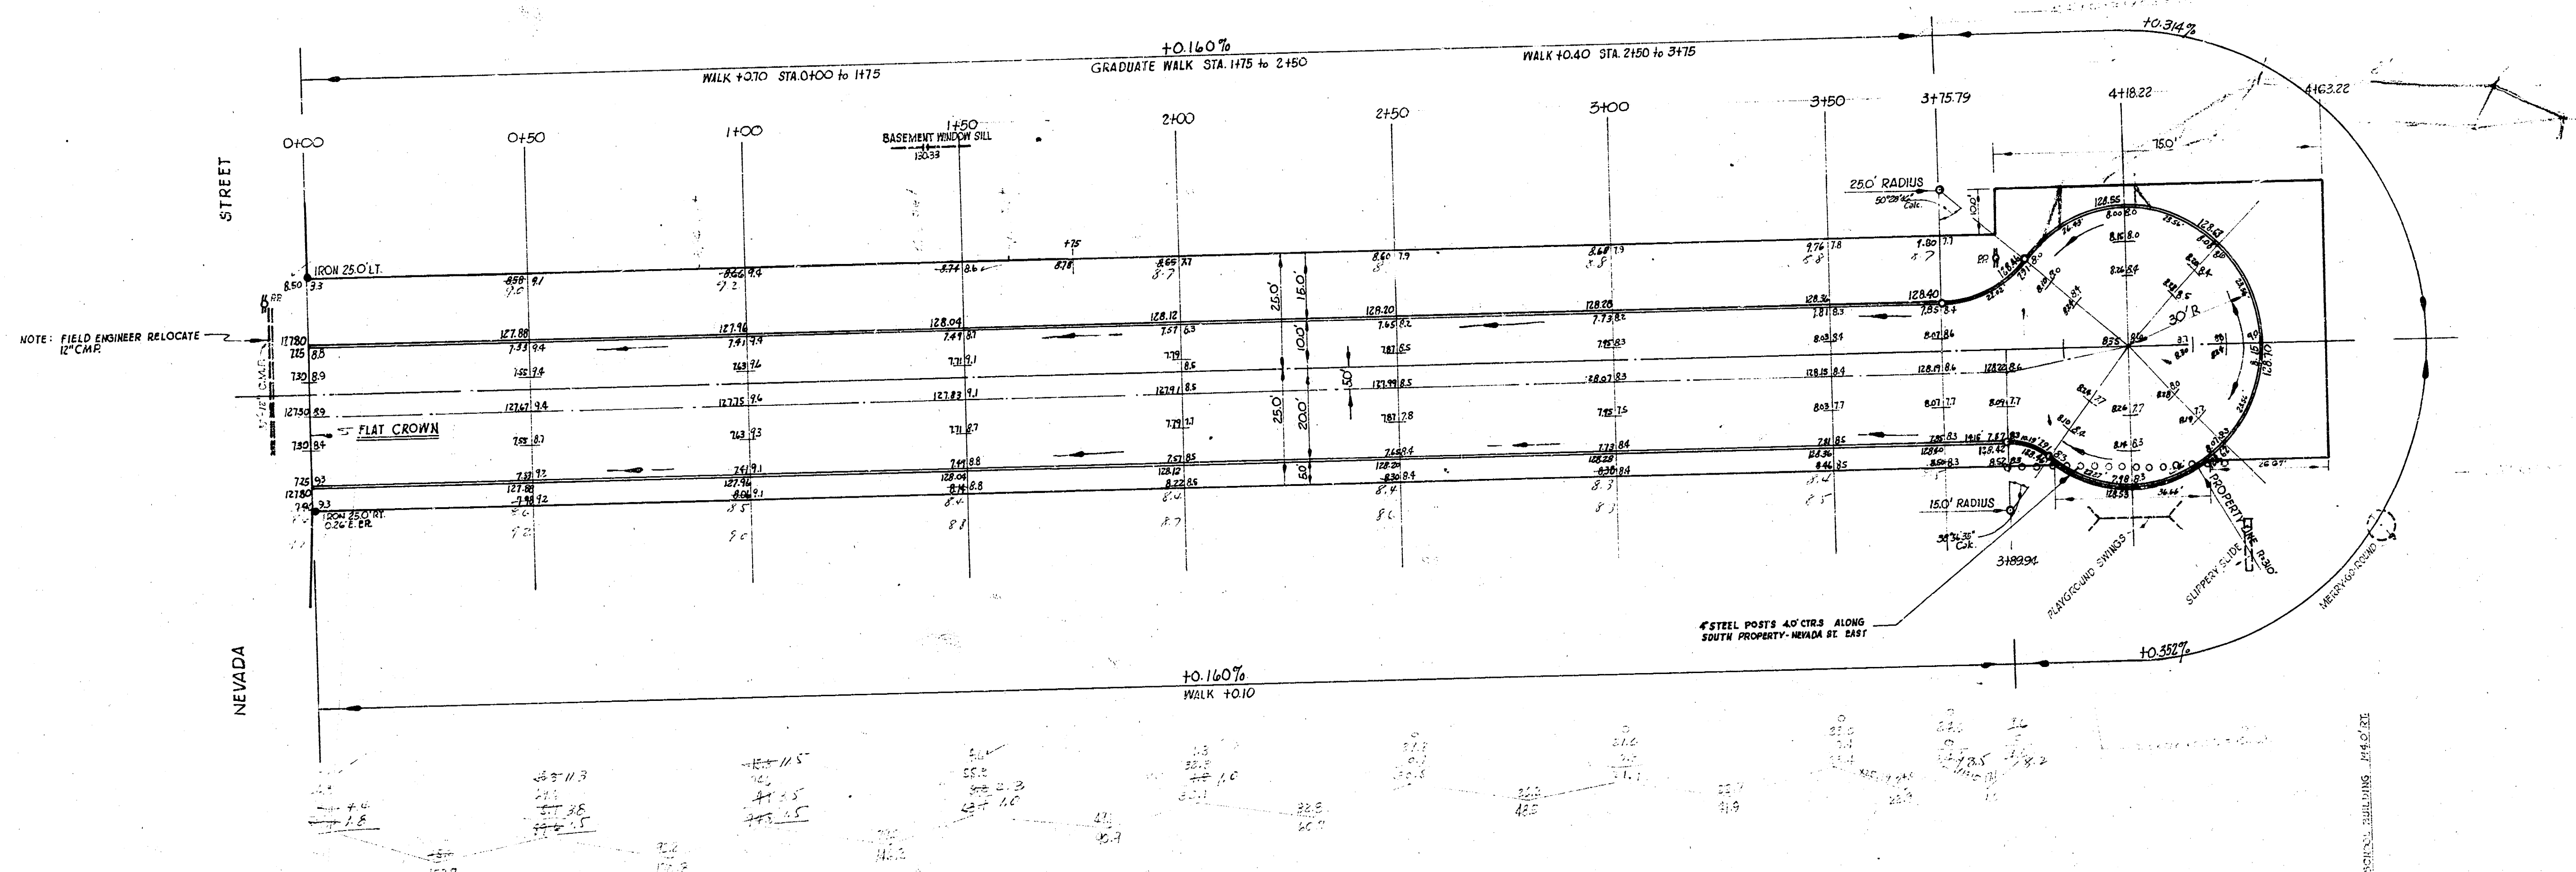

EXCAVATION TOTAL

PROPERTY	CITY
72.0	0
+10% 78.6	
427.6 C.V.	0 C.V.



NEVADA COURT

EL. NEVADA STREET TO and INCLUDING CUL-DE-SAC

30' CONCRETE

CITY OF WICHITA, KANSAS

B.E. SMITH CITY ENGINEER

DATE: SEPT. 1958

PROJECT NO. C18-14A