
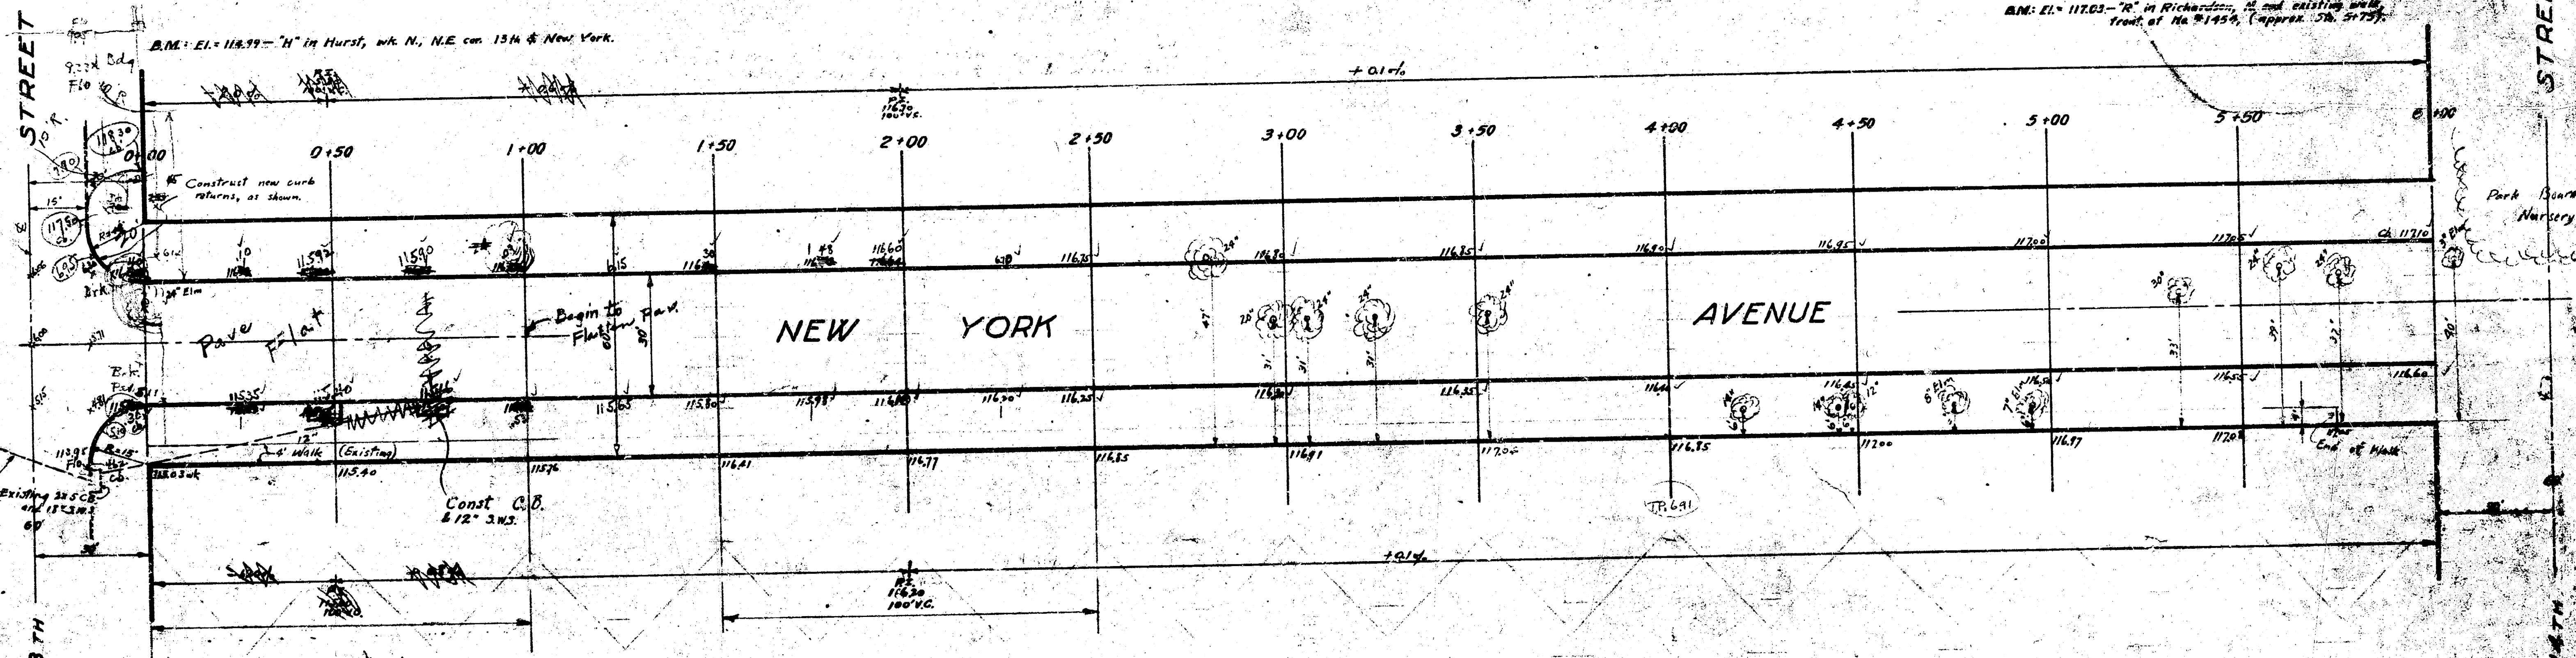


Blue top
10-26-45
O.H.M.

PAVING PLAN-----1945
NEW YORK AVENUE N.L. 13TH
CONCRETE 30' & INTEGRAL CURB S.L. 14TH

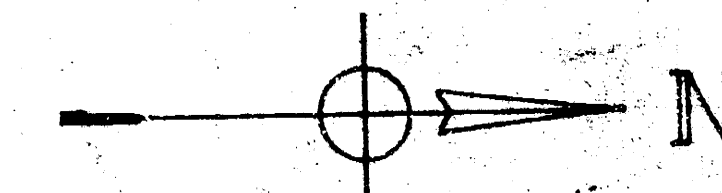

Note:
Revise Grades
0+0 to 2+50
Book 53 P. 20
O.H.M.

NO REVISIONS

EXCAVATION	
Property	5712 cu yds.
City	5761 "
Total Excav. Property	
11473 Cu. Yds.	
On Cross Section Sheet.	

NEW YORK AVE
N.L. 13TH S.L. 14TH

DATE: 9-18-1945
DR. D. M. WHELAN
PUBLIC SERVICE DEPARTMENT
L. K. WHITE, CITY ENGINEER