PAVING PLAN
1942
N.Y. COURT
N.L. 3RD ST
TO
℄ LOT 5 BLK. B

1942

NEW YORK COURT — N.L. THIRD TO ℄ LOT 5-BLOCK-B

28-C.I.

27' Curb to Curb

Note
Change grade
Build C.B.s @ 3rd
C.H.M. 6-27-42

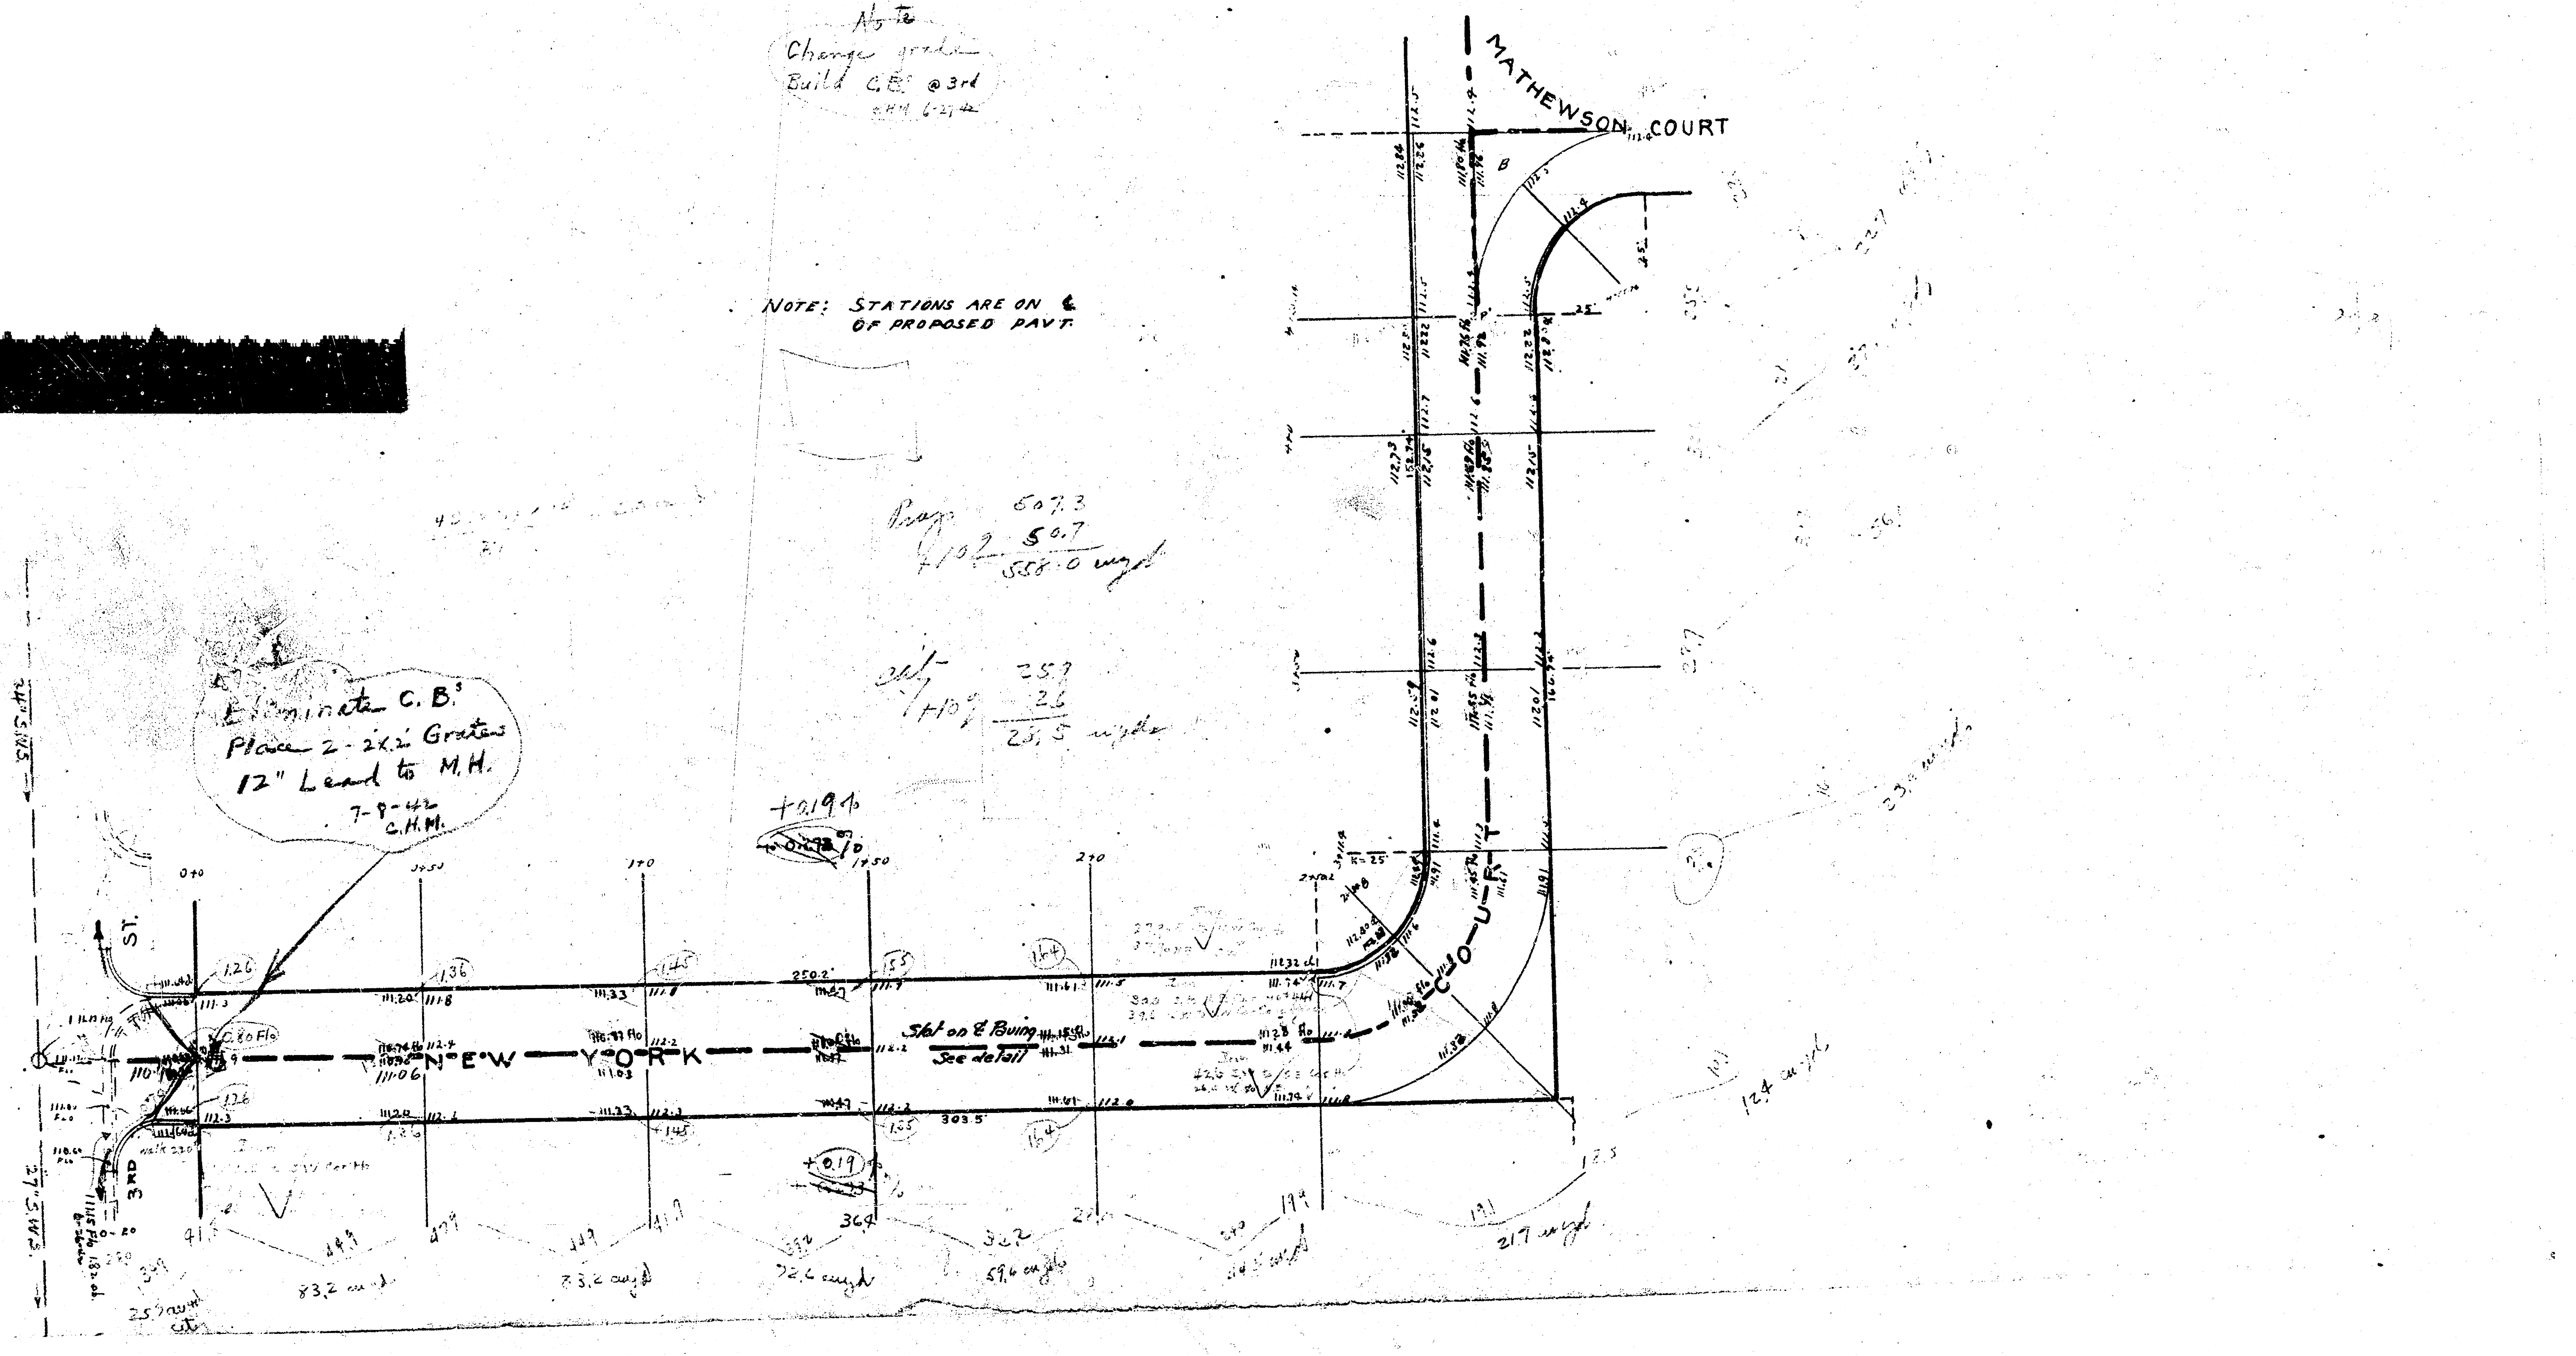

MATHEWSON COURT
N E W Y O R K
C O U R T
ST.
3RD
0+0
0+50
1+0
1+50
2+0
1.26
1.36
1.45
1.55
1.64
250.2'
303.5'
+0.19%
Slot on ℄ Paving
See detail
27' S.W.S.
83.2 cu.yd.
83.2 cu.yd.
72.2 cu.yd.
59.6 cu.yd.
21.7 cu.yd.
12.4 cu.yd.

NOTE: STATIONS ARE ON ℄ OF PROPOSED PAV'T.

Eliminate C.B.s
Place 2 - 2'x2' Grates
12" Lead to M.H.
7-8-42
C.H.M.

Prop. 507.3
+10% 50.7
558.0 cu.yd.

Cut 25.9
+10% 2.6
28.5 cu.yds.

B.M. 111.80 "K" IN KEELER ~~PAT. OF WR.~~ No. SE COR N.Y. + 3RD

1942

NEW YORK COURT — N.L. THIRD TO ℄ LOT 5-BLOCK-B

28-C.I.

27' Curb to Curb

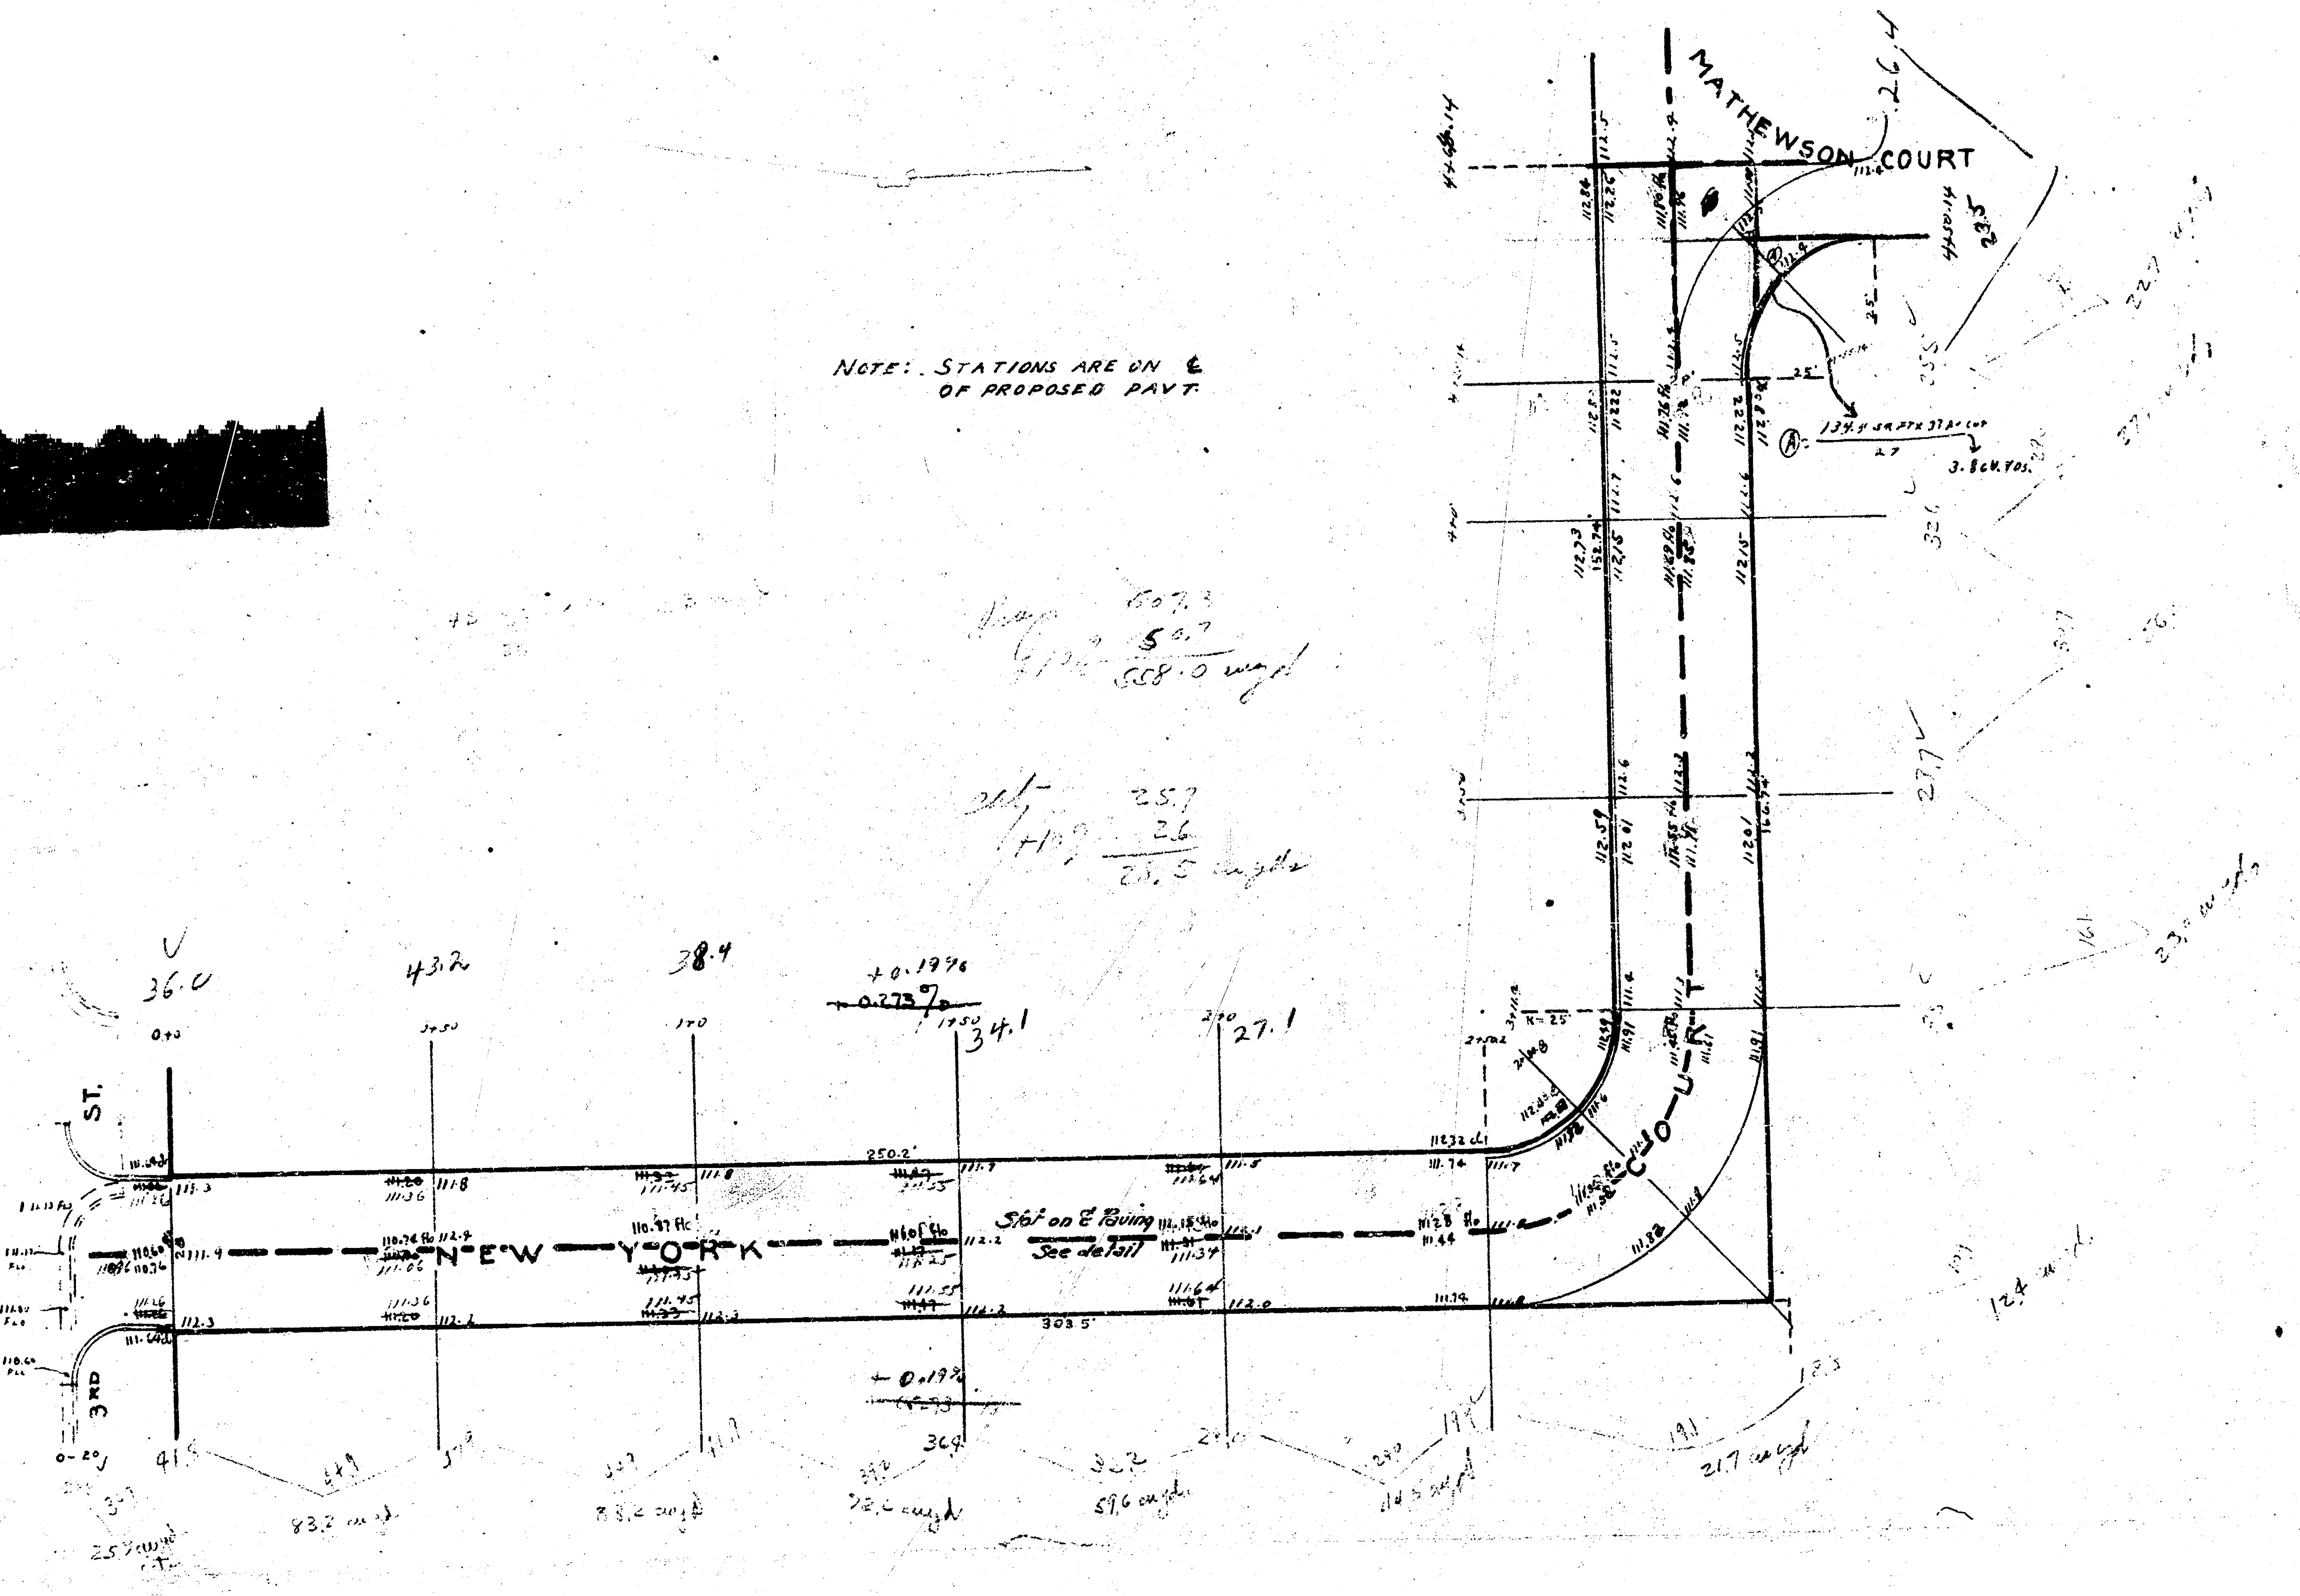
MATHEWSON COURT
COURT
N E W Y O R K
3RD ST.
56' on ℄ Paving See detail
36.0
43.2
38.4
34.1
27.1
250.2'
303.5'

NOTE: STATIONS ARE ON ℄ OF PROPOSED PAVT.

B.M. 111.80 "K" IN KEELER FRT OF HK. No. SE COR N.Y. + 3RD