PAVING PLAN 1945

PARK PLACE N.L. 23 RD. ST. S.L. 24 TH. ST.

COMB. CURB & GUTTER & EXC.

B.M. ELEV. 123.88 "W" IN W.D. HORST & WK. S. SE. COR. PARK PLACE & 23RD. ST.
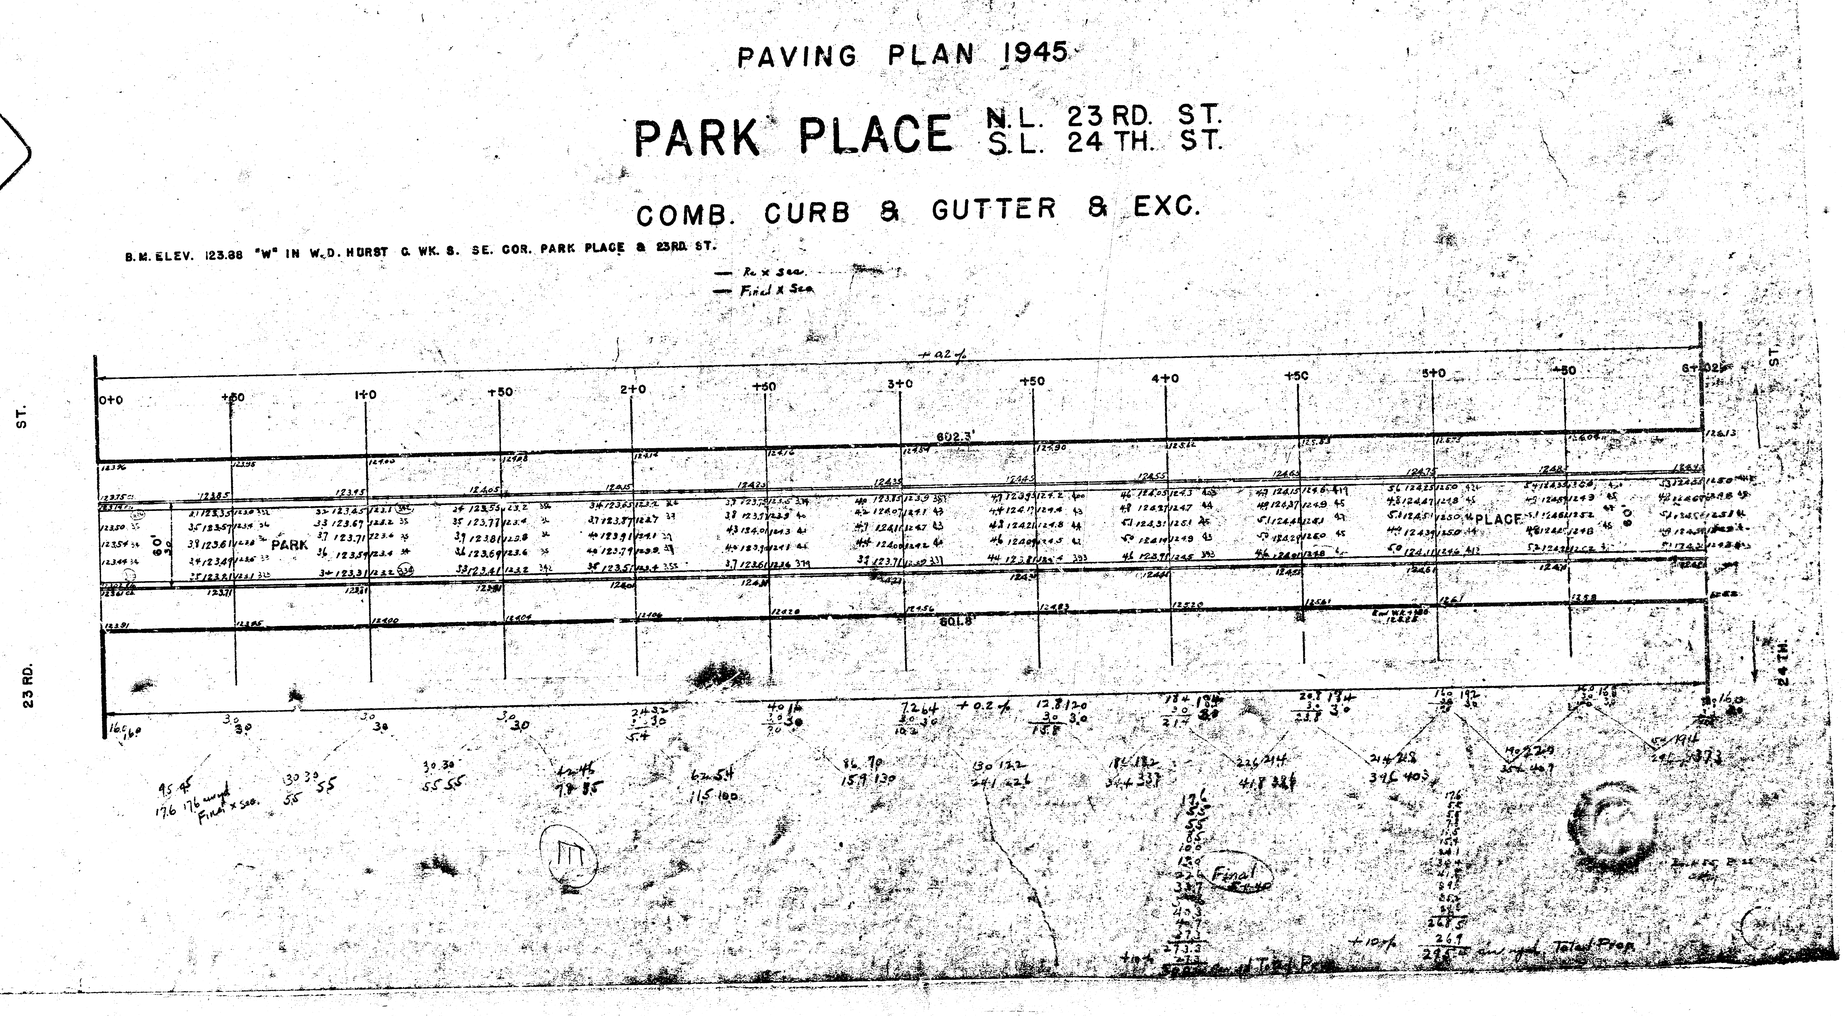
— Re x Sec.
— Final x Sec.