


B.M. 11972 'E' in Ritchie S curb Pincrest, W.L. Ridgewood.
B.M. 12439 'G' in Globe E curb Old Manor, N.L. Kinraid

Stationing on face of E curb.

CURVE DATA
for E.C. $\Delta = 49^{\circ}53'$ $E = 281.78$
for E.C. $\Delta = 49^{\circ}53'$ $E = 293.80$ $L = 255.73$
The P.C. of the curve & property lines coincide,

Exc.
Prop 3554.2
+1.0%
2809.16 as 105.
SIT 74.7
105.0
54.2 in 105.

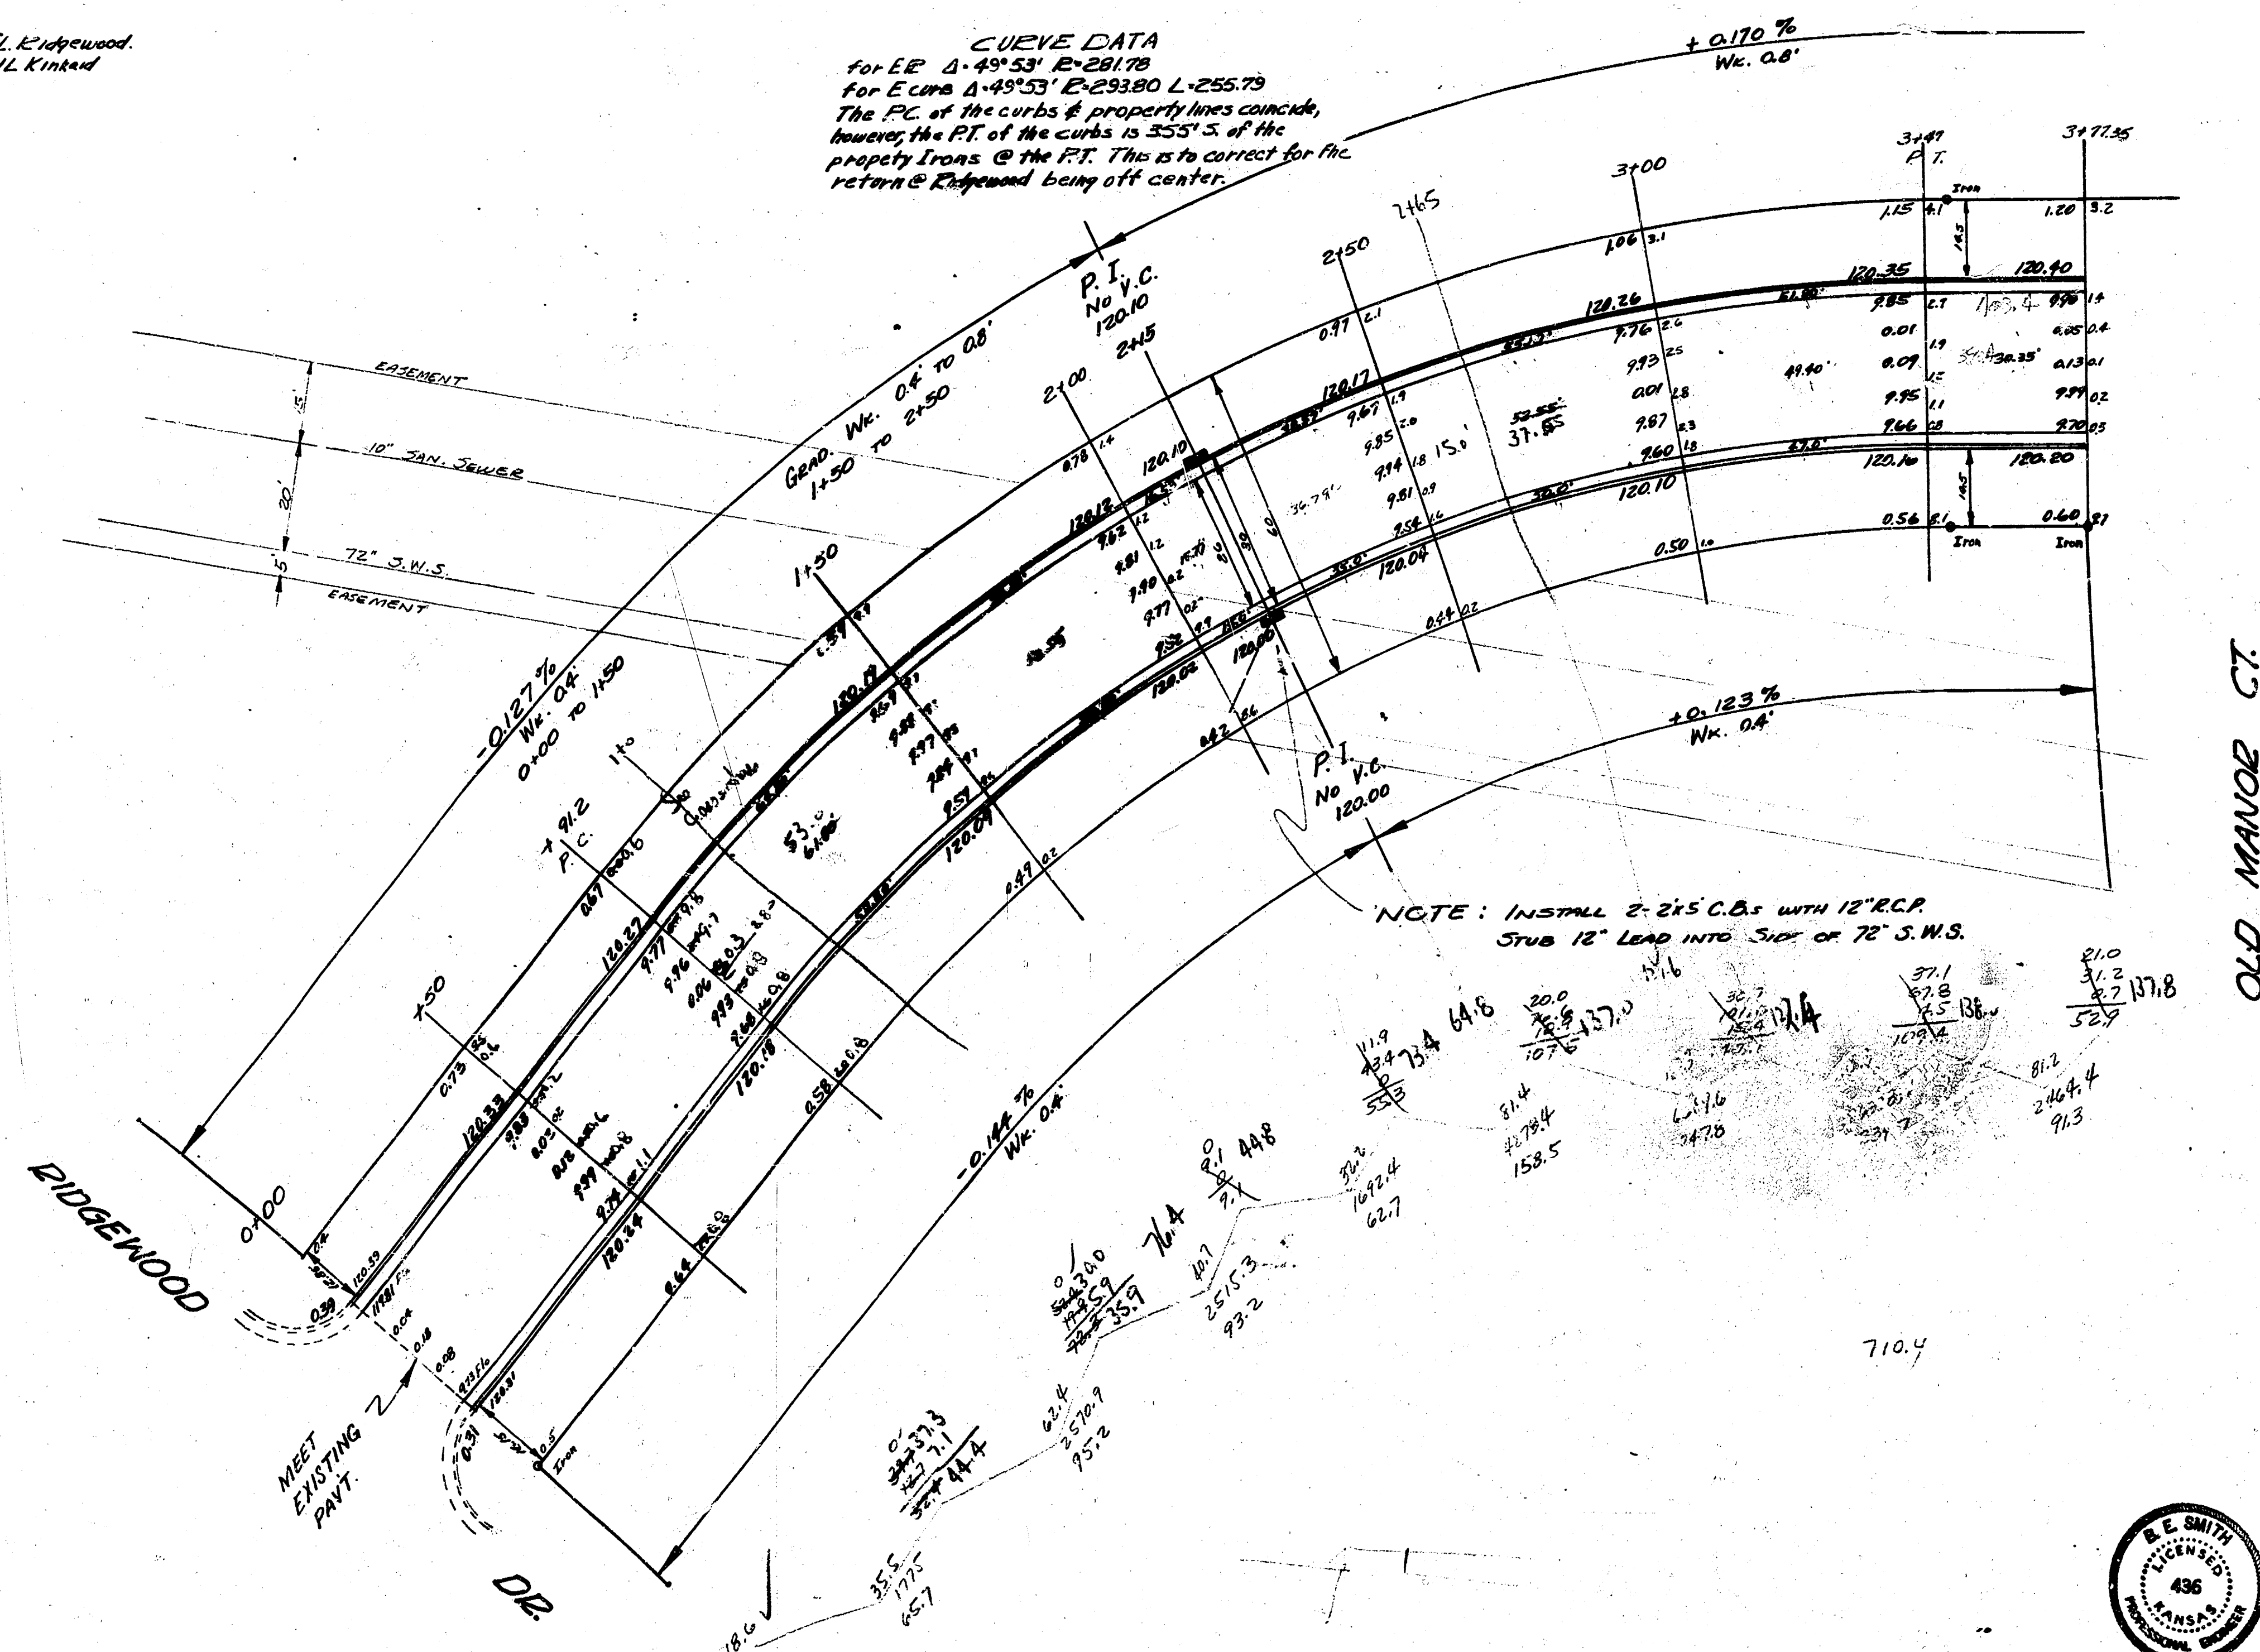

OLD MANOR CT.

OLD MANOR ROAD
W.L. RIDGEWOOD TO S.L. KINRAID
26'-2'-30' AC.

CITY OF WICHITA, KANS.

B.E. SMITH
DEC. 1902
CITY ENGINEER
Proc. No. 12-68



1/2

