



B.M. 131.33 RR SPIKE, S.E. Lt. POLE BET. PINECREST & OLD MANOR 60' N of N.L. KINNAID
 B.M. 149.556 S. END N. ROAD E.S. COR. ISLAND S.W. COR. OLIVER & Mt. VERNON
 B.M. 141.76 NW COR. MAIN S. S.L. Mt. Vernon, S.L. ELMON
 B.M. 142.16 N.W. COR. N. ROAD No. 5003 S.W. CORNER of Mt. Vernon
 B.M. 133.19 S.W. COR. CORN. POND No. 8E Old Manor & Mt. Vernon


Note: Stripings on W.R.

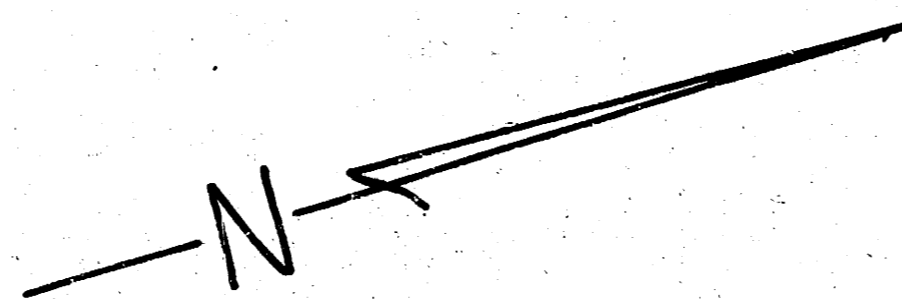



E.V.C.	
PROP.	CITY
3815.1	264.2
+10%	+10%
4190.6 at 425.	400.0 at 425.

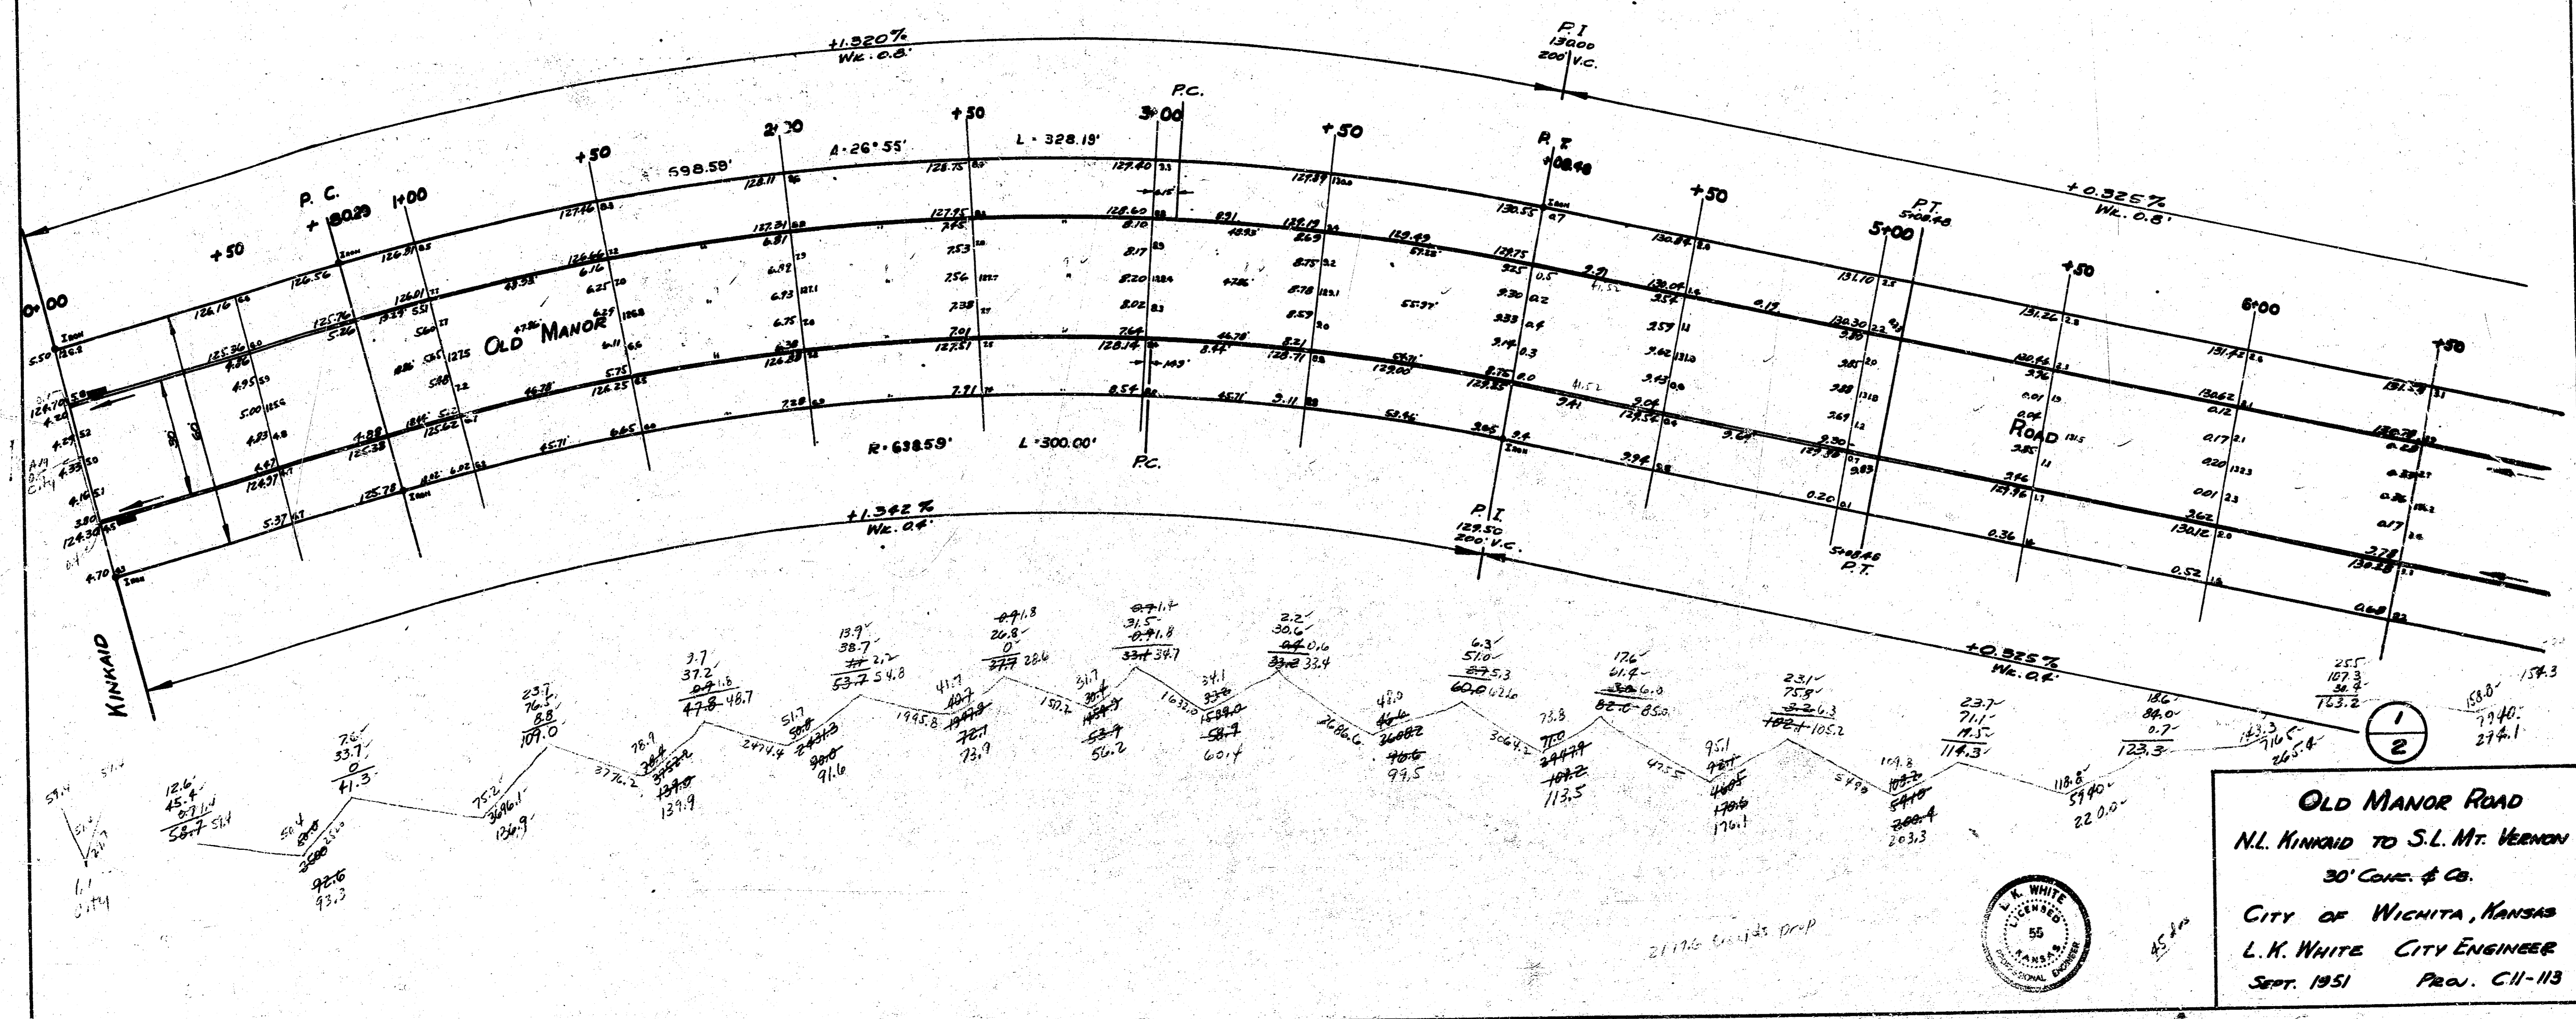

OLD MANOR ROAD
 N.L. KINNAID TO S.L. Mt. VERNON
 30' CONC. & CO.
 CITY OF WICHITA, KANSAS
 L.K. WHITE CITY ENGINEER
 SEPT. 1951 PROJ. C11-113

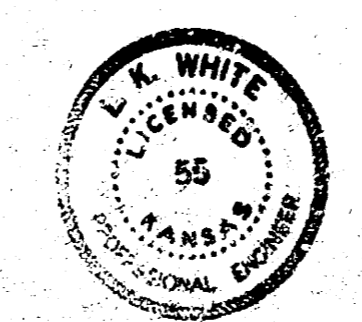


Surveyed by Miss TC 1-15-52
 Plan Date July 1950
 Scale 1" = 200'

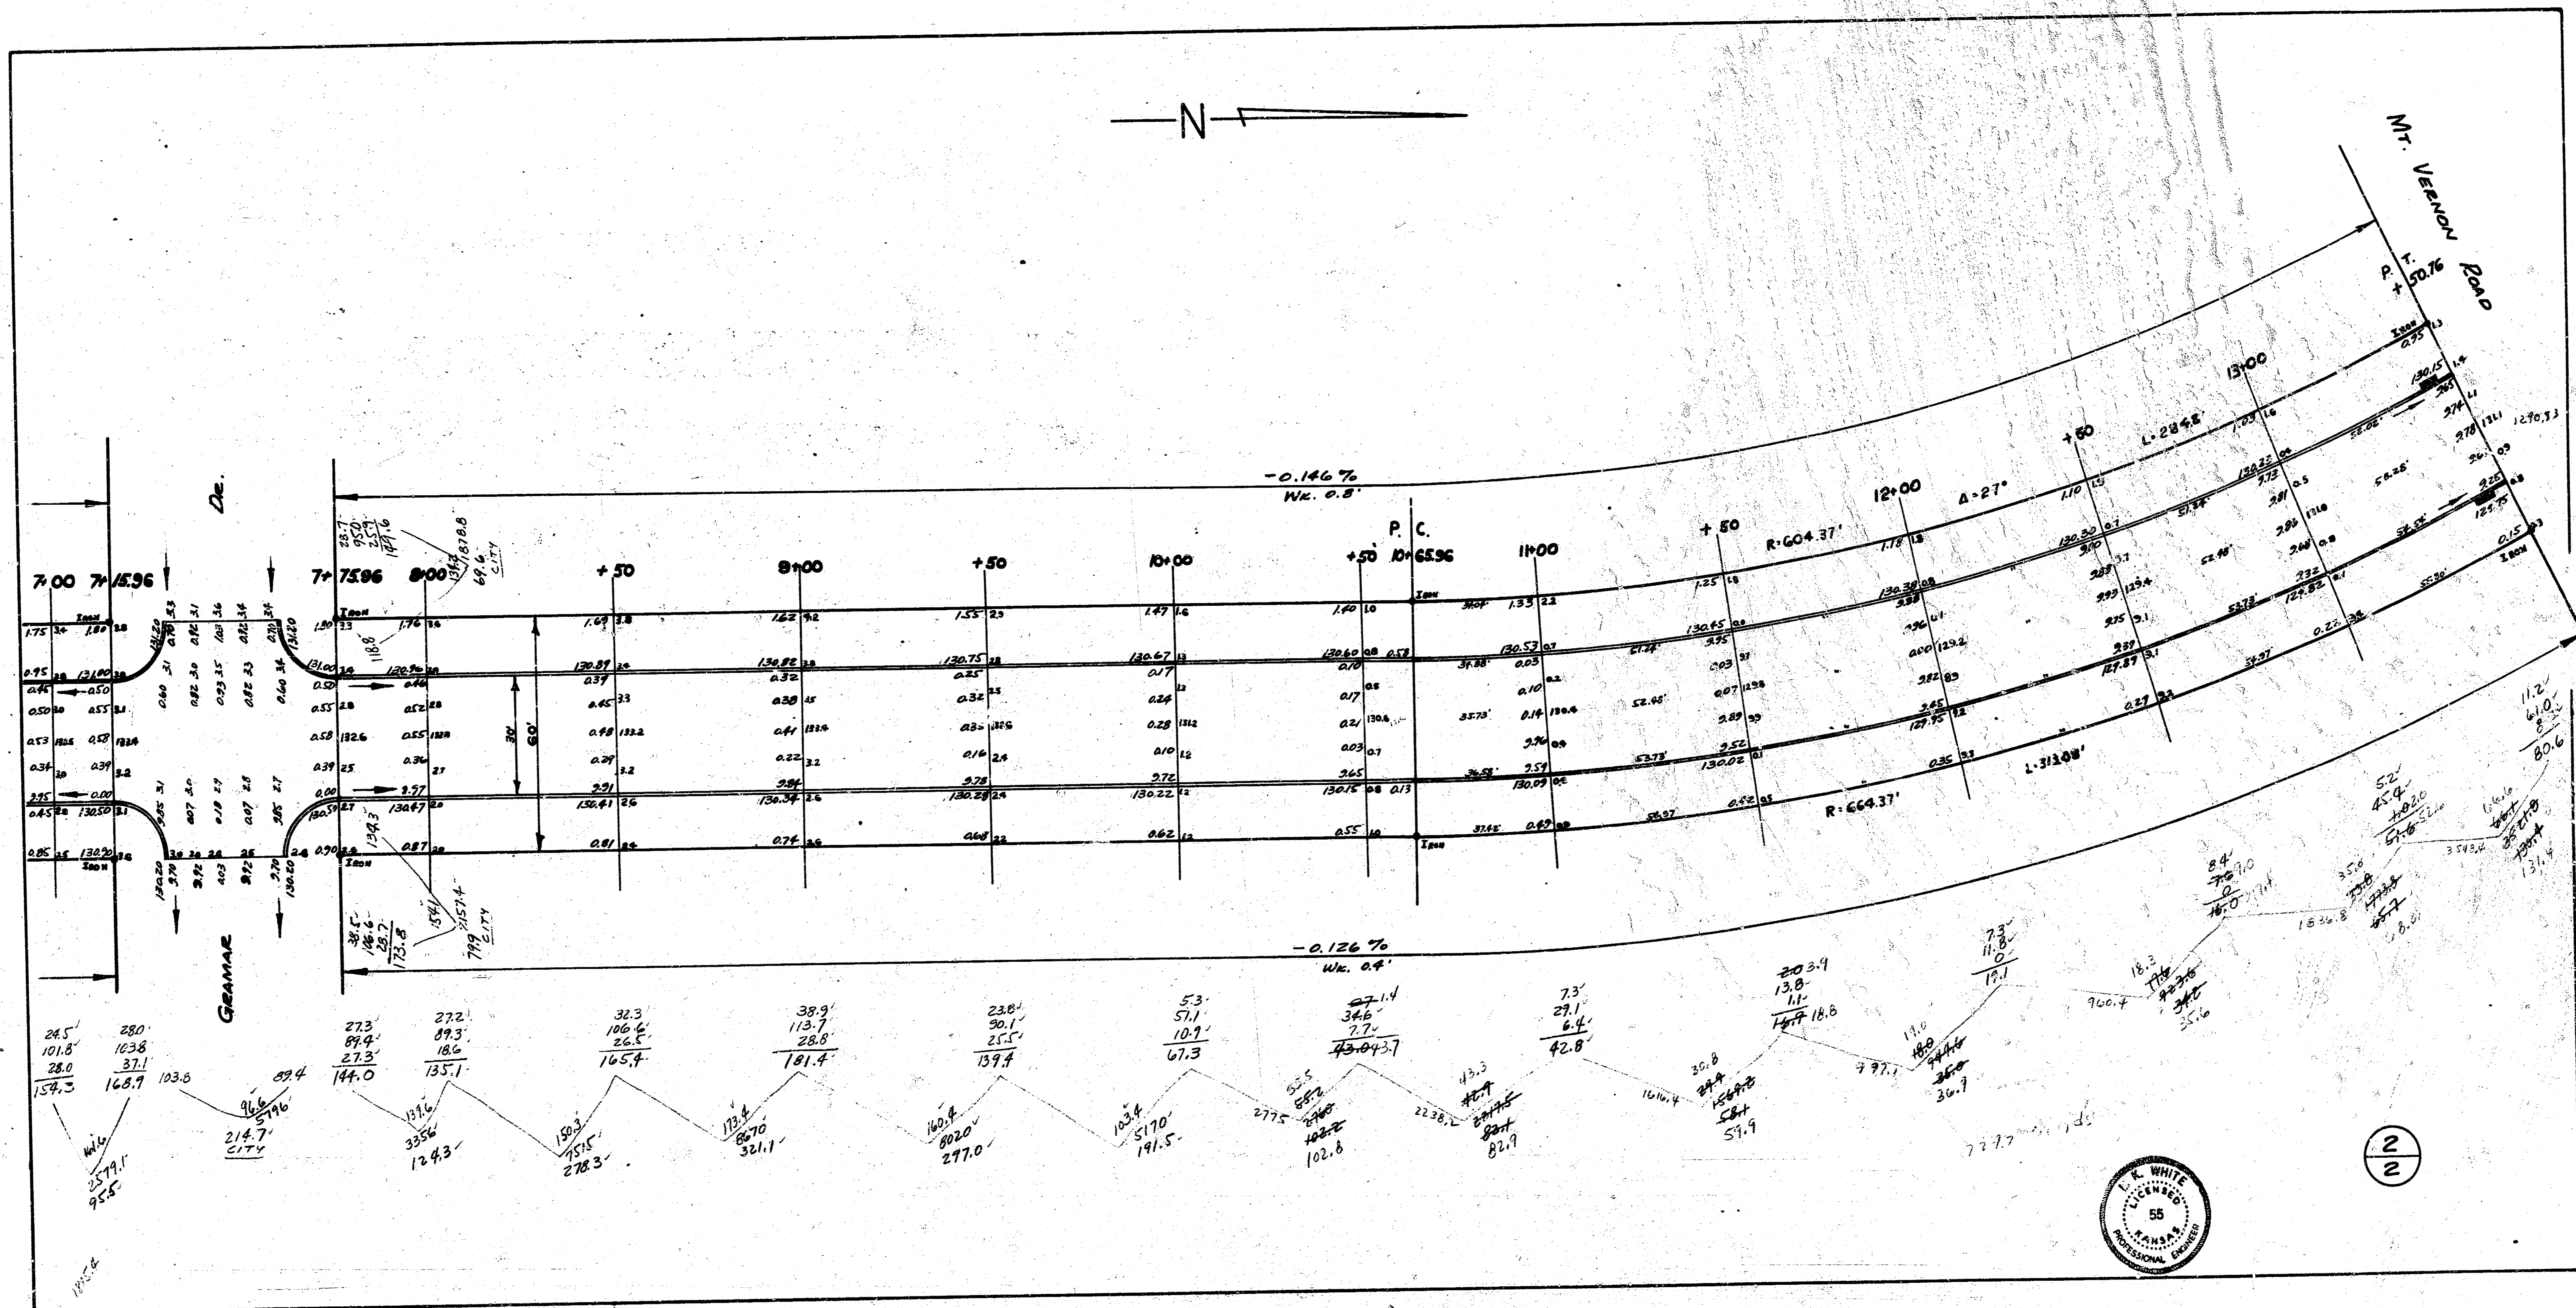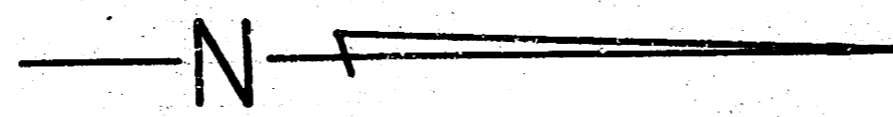

H-1

B.M. 130.61 'B' in Builders Fwk. N.E. Cor. Mt. Vernon & Old Manor
B.M. 139.87 Standard N.W. Cor. Mt. Vernon & Edgemoor


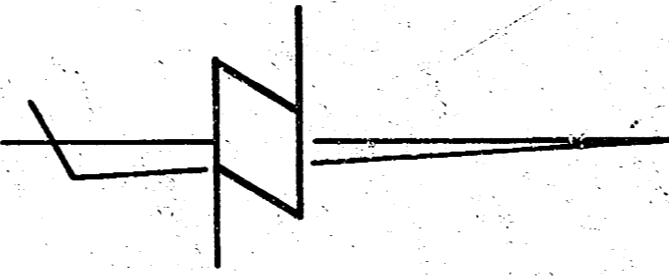


Property

99.6	Fill
98.6	5.4
97.7	1.8
96.8	13.5
95.9	12.5
95.0	12.2
94.1	12.0
93.2	12.0
92.3	12.0
91.4	12.0
90.5	6.1
89.6	9.6% Fill
88.7	10.8
87.8	10.8
-0.4	10.8
-1.3	10.8
26.0 x 2 = 52.0 in 100' run
2.0 x 25 = 50.0 477' runs

MT. VERNON ROAD

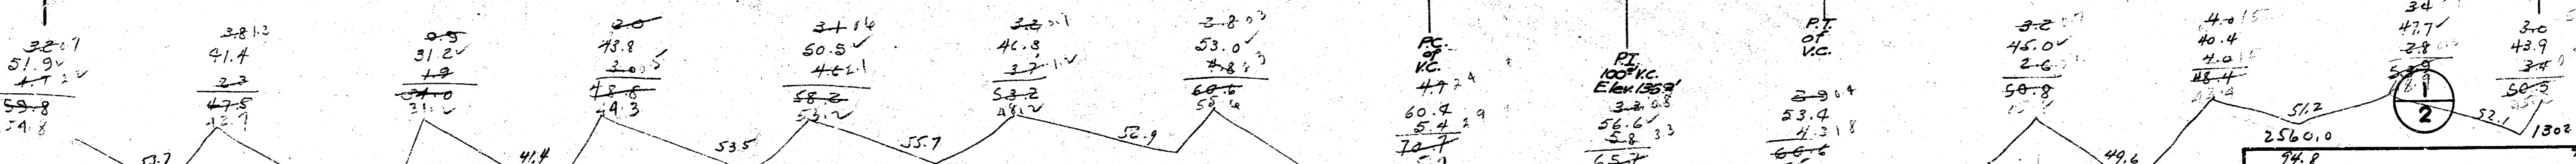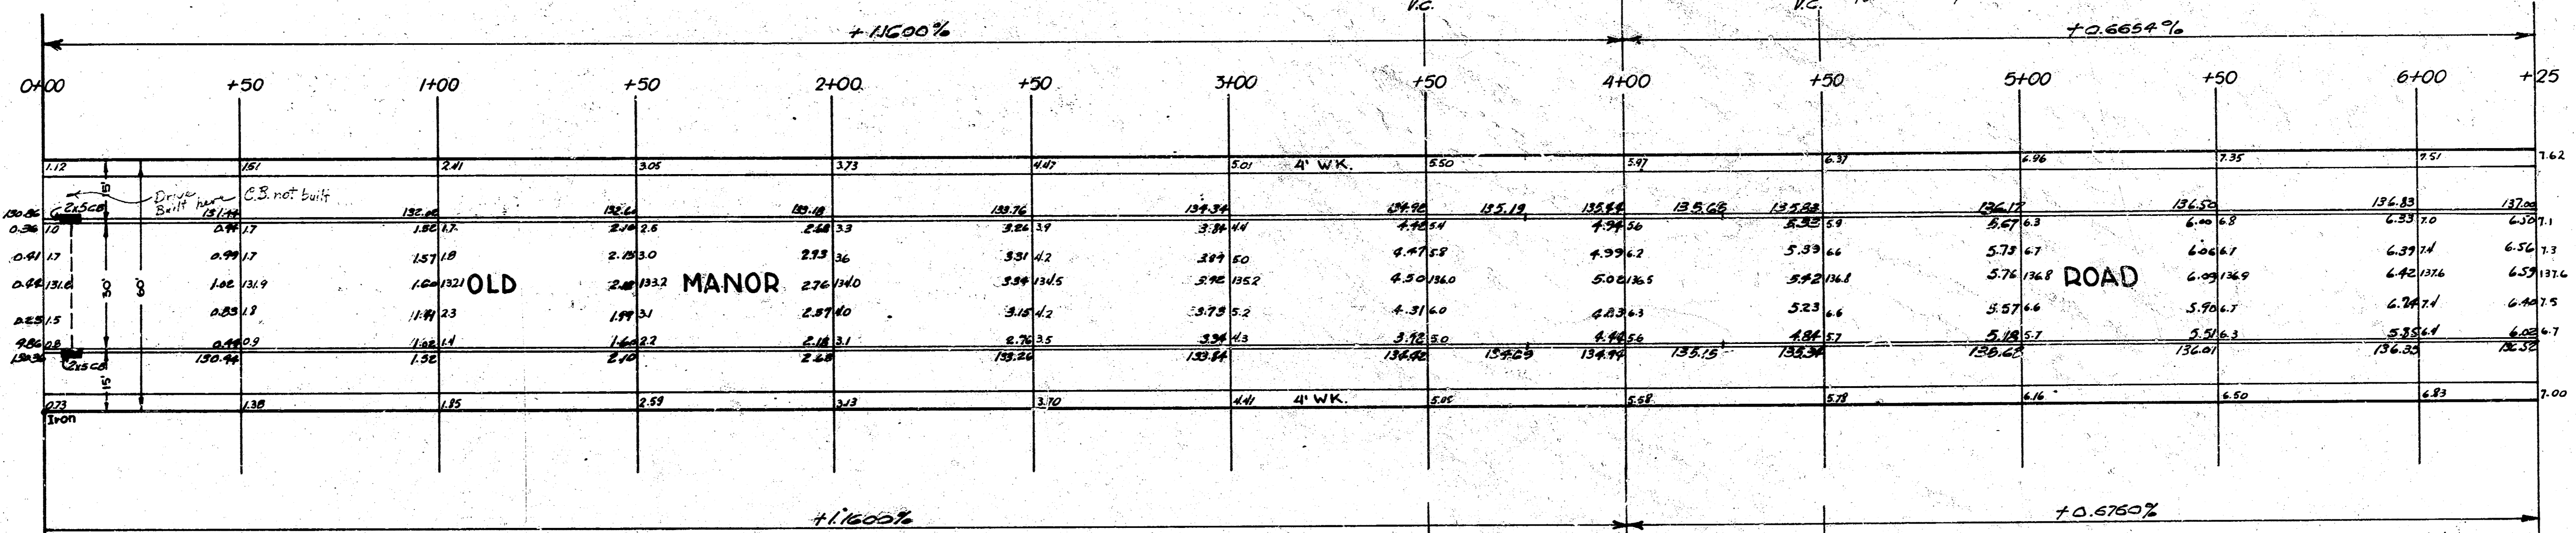


OLD MANOR ROAD
 N.L. MT. VERNON RD. TO S.L. FUNSTON AVE
 30' Conc & Cb.
 CITY OF WICHITA, KANSAS
 L.K. WHITE CITY ENGINEER
 SEPT. 1981 PROJ. NO. 1C11-123



H-1

B.M. 14083 'X' on cb. E.S. Old Manor S.Cb. Funston

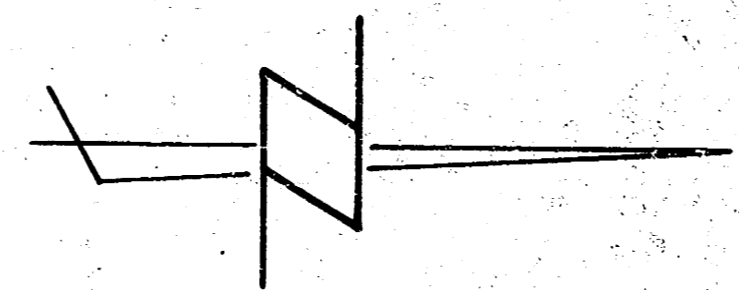


