
CHM 76

B.M. 131.33 R.R. SPIKE, SS L.P. POLE BET. PINECREST & OLD MANOR 60' N OF NL KINKAID
B.M. 149.556 S. END N RAIL ES. GDR ESMRD SW. COR. OLIVER & MT. VERNON
B.M. 141.76 NW COR WALL S. SL MT. VERNON, WL CLINTON
B.M. 142.16 N.W. COR. N. PORCH No. 5003 S.W. GRANADA & MT. VERNON
B.M. 133.19 S.W. COR. CONC. PORCH No. NE OLD MANOR & MT. VERNON

NOTE: STATIONING ON W.B.

E.V.C.

PROP.	CITY
3915.1	264.2
+10%	+10%
4196.6 cu. yds.	400.6 cu. yds.

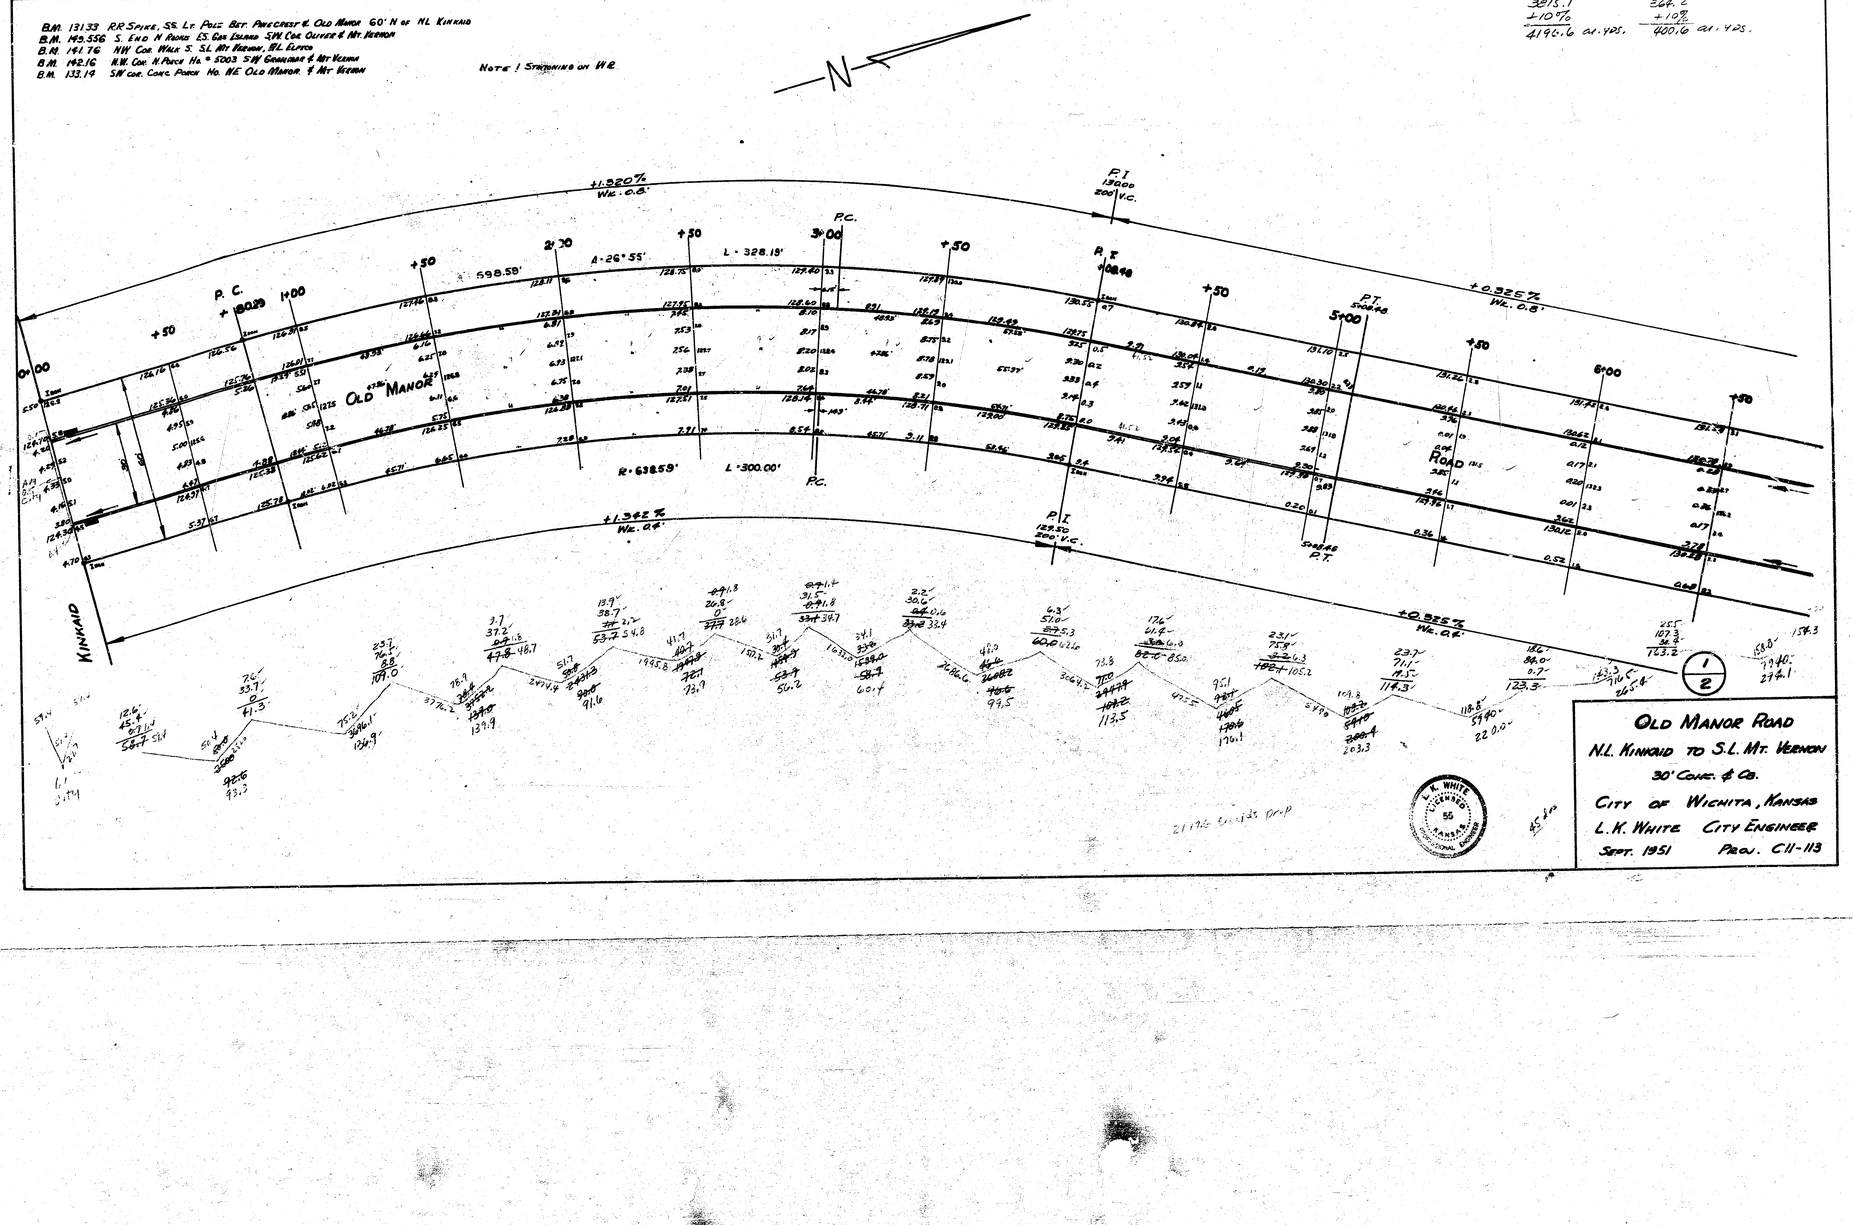

Survey Cert Mtns 76 1-15-52
Plan Doc 1 of Mtns Mon Sections 7-28-52

OLD MANOR ROAD

N.L. KINKAID TO S.L. MT. VERNON


30' CONC. & CB.

CITY OF WICHITA, KANSAS

L.K. WHITE CITY ENGINEER

SEPT. 1951 PROJ. C11-113

L. K. WHITE LICENSED 55 KANSAS PROFESSIONAL ENGINEER

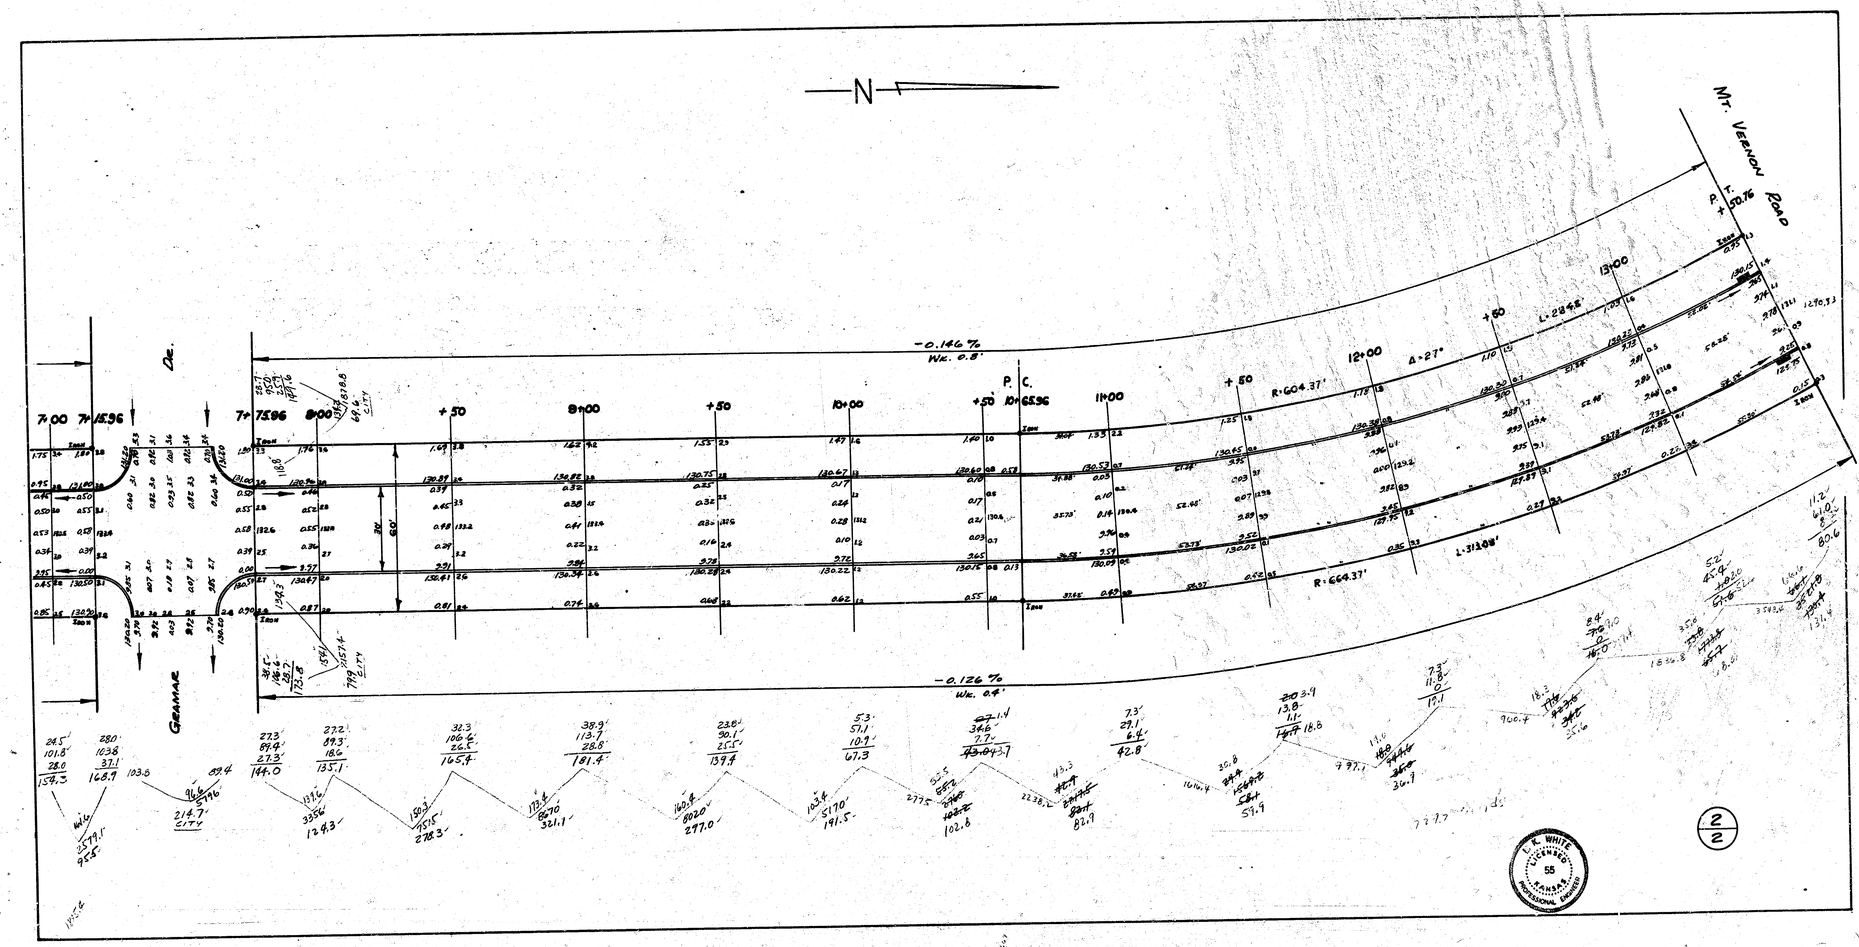
N
MT. VERNON ROAD
GRAMAR
P.C.
R=604.37'
R=664.37'
Δ=27°
L=2848'
L=3138'
-0.146%
-0.126%
7+00
7+15.96
7+75.96
8+00
8+50
9+00
9+50
10+00
10+65.96
11+00
11+50
12+00
12+50
13+00
P+50.76
E.K. WHITE
LICENSED
55
KANSAS
PROFESSIONAL ENGINEER
2/2

H-1

B.M. 130.61 "B" in Builders F.w.x. N.E. Cor. Mt. Vernon & Old Manor
B.M. 139.87 Standard N.W. Cor. Mt. Vernon & Edgemoor

SCALE 1"=20'

Property

99.4 / 78.6 / 76.7 / 99.1 / 103.2 / 105.4 / 121.7 / 126.3 / 117.0 / 117.2 / 97.9 / 99.5 / 96.2 / 102.0 / 77.5 / 99.8 / 93.7 / 76.3 / 2.4 / 2.7 / 1.3 / 1.5 / 1.3 / 1.2 / 1503 / 1503 / 102.1±0.2%

1473.5 Cu. yds. Excav.

Fill
1.0
12.6
13.5
18.5
20.2
13.6
14.0
6.1
90 @ 110%
106.0 Cu. yds. Fill

106.0 x 1/3 = 35.3 cu. yds.
35.3 x 2.7 = 95.3 tons
35.3 x 1.35 = 47.7 tons

PI. 100' V.C. Elev. 139.70
PC. of V.C.
PT. of V.C.
+1.1600%
+0.6654%

0+00 +50 1+00 +50 2+00 +50 3+00 +50 4+00 +50 5+00 +50 6+00 +25

MT. VERNON ROAD

OLD MANOR

4' W.K.

+1.1600%
+0.6760%


2685.0 99.4
2040.0 75.6
2070.0 76.7
2675.0 99.1
2785.0 103.2
2845.0 105.4
3285.0 121.7
3410.0 126.3
3160.0 117.0
2785.0 103.2
2480.0 91.9
2560.0 94.8
1302.5 48.2


L.K. WHITE LICENSED KANSAS PROFESSIONAL ENGINEER 65

OLD MANOR ROAD
N.L. MT. VERNON RD. TO S.L. FUNSTON AVE.
30' Conc. & Cb.
CITY OF WICHITA, KANSAS
L.K. WHITE CITY ENGINEER
SEPT. 1981 PROJ. NO. 1C11-123

H-1

B.M. 140.83 'X' on cb. E.S. Old Manor S.Cb. Funston

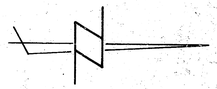

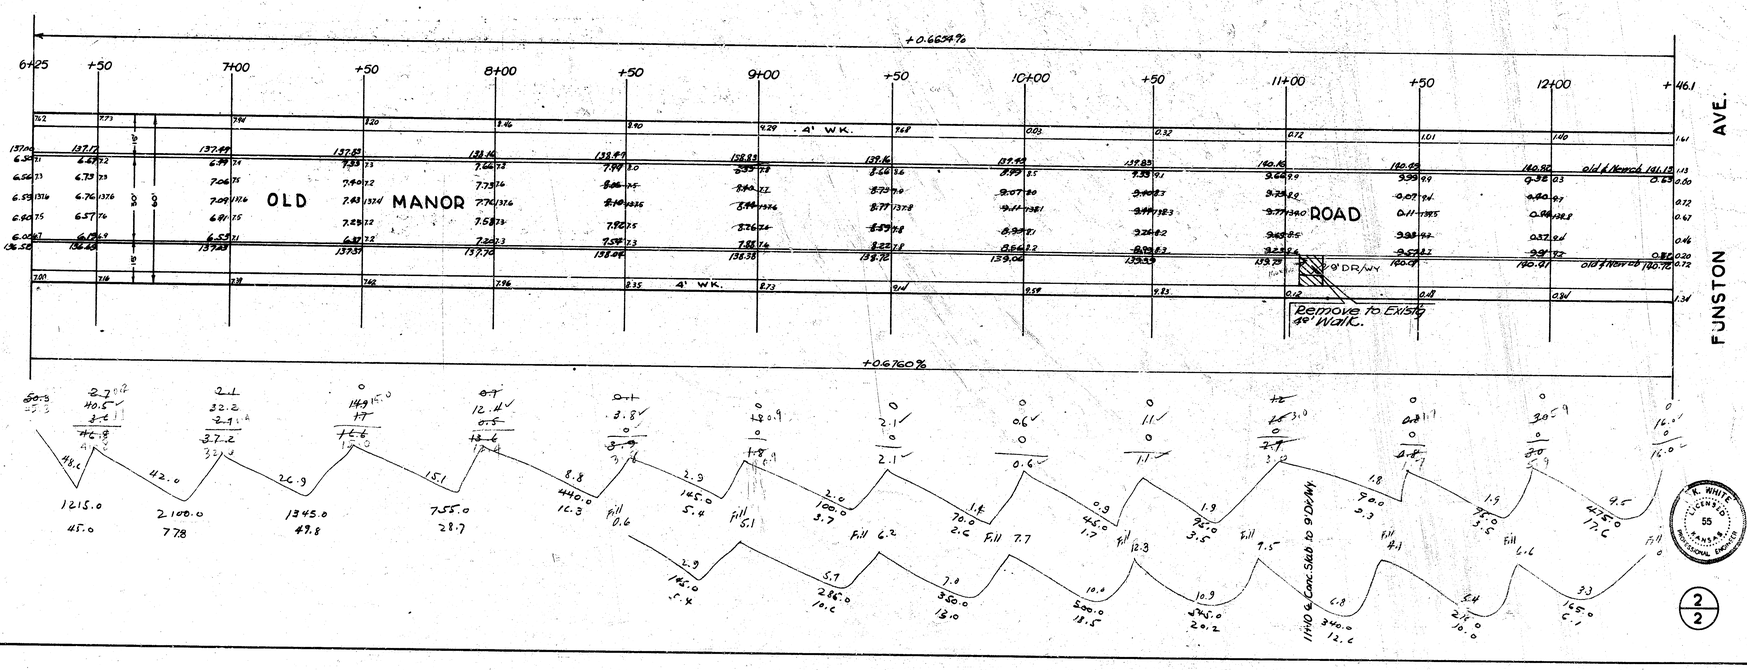

2/2