
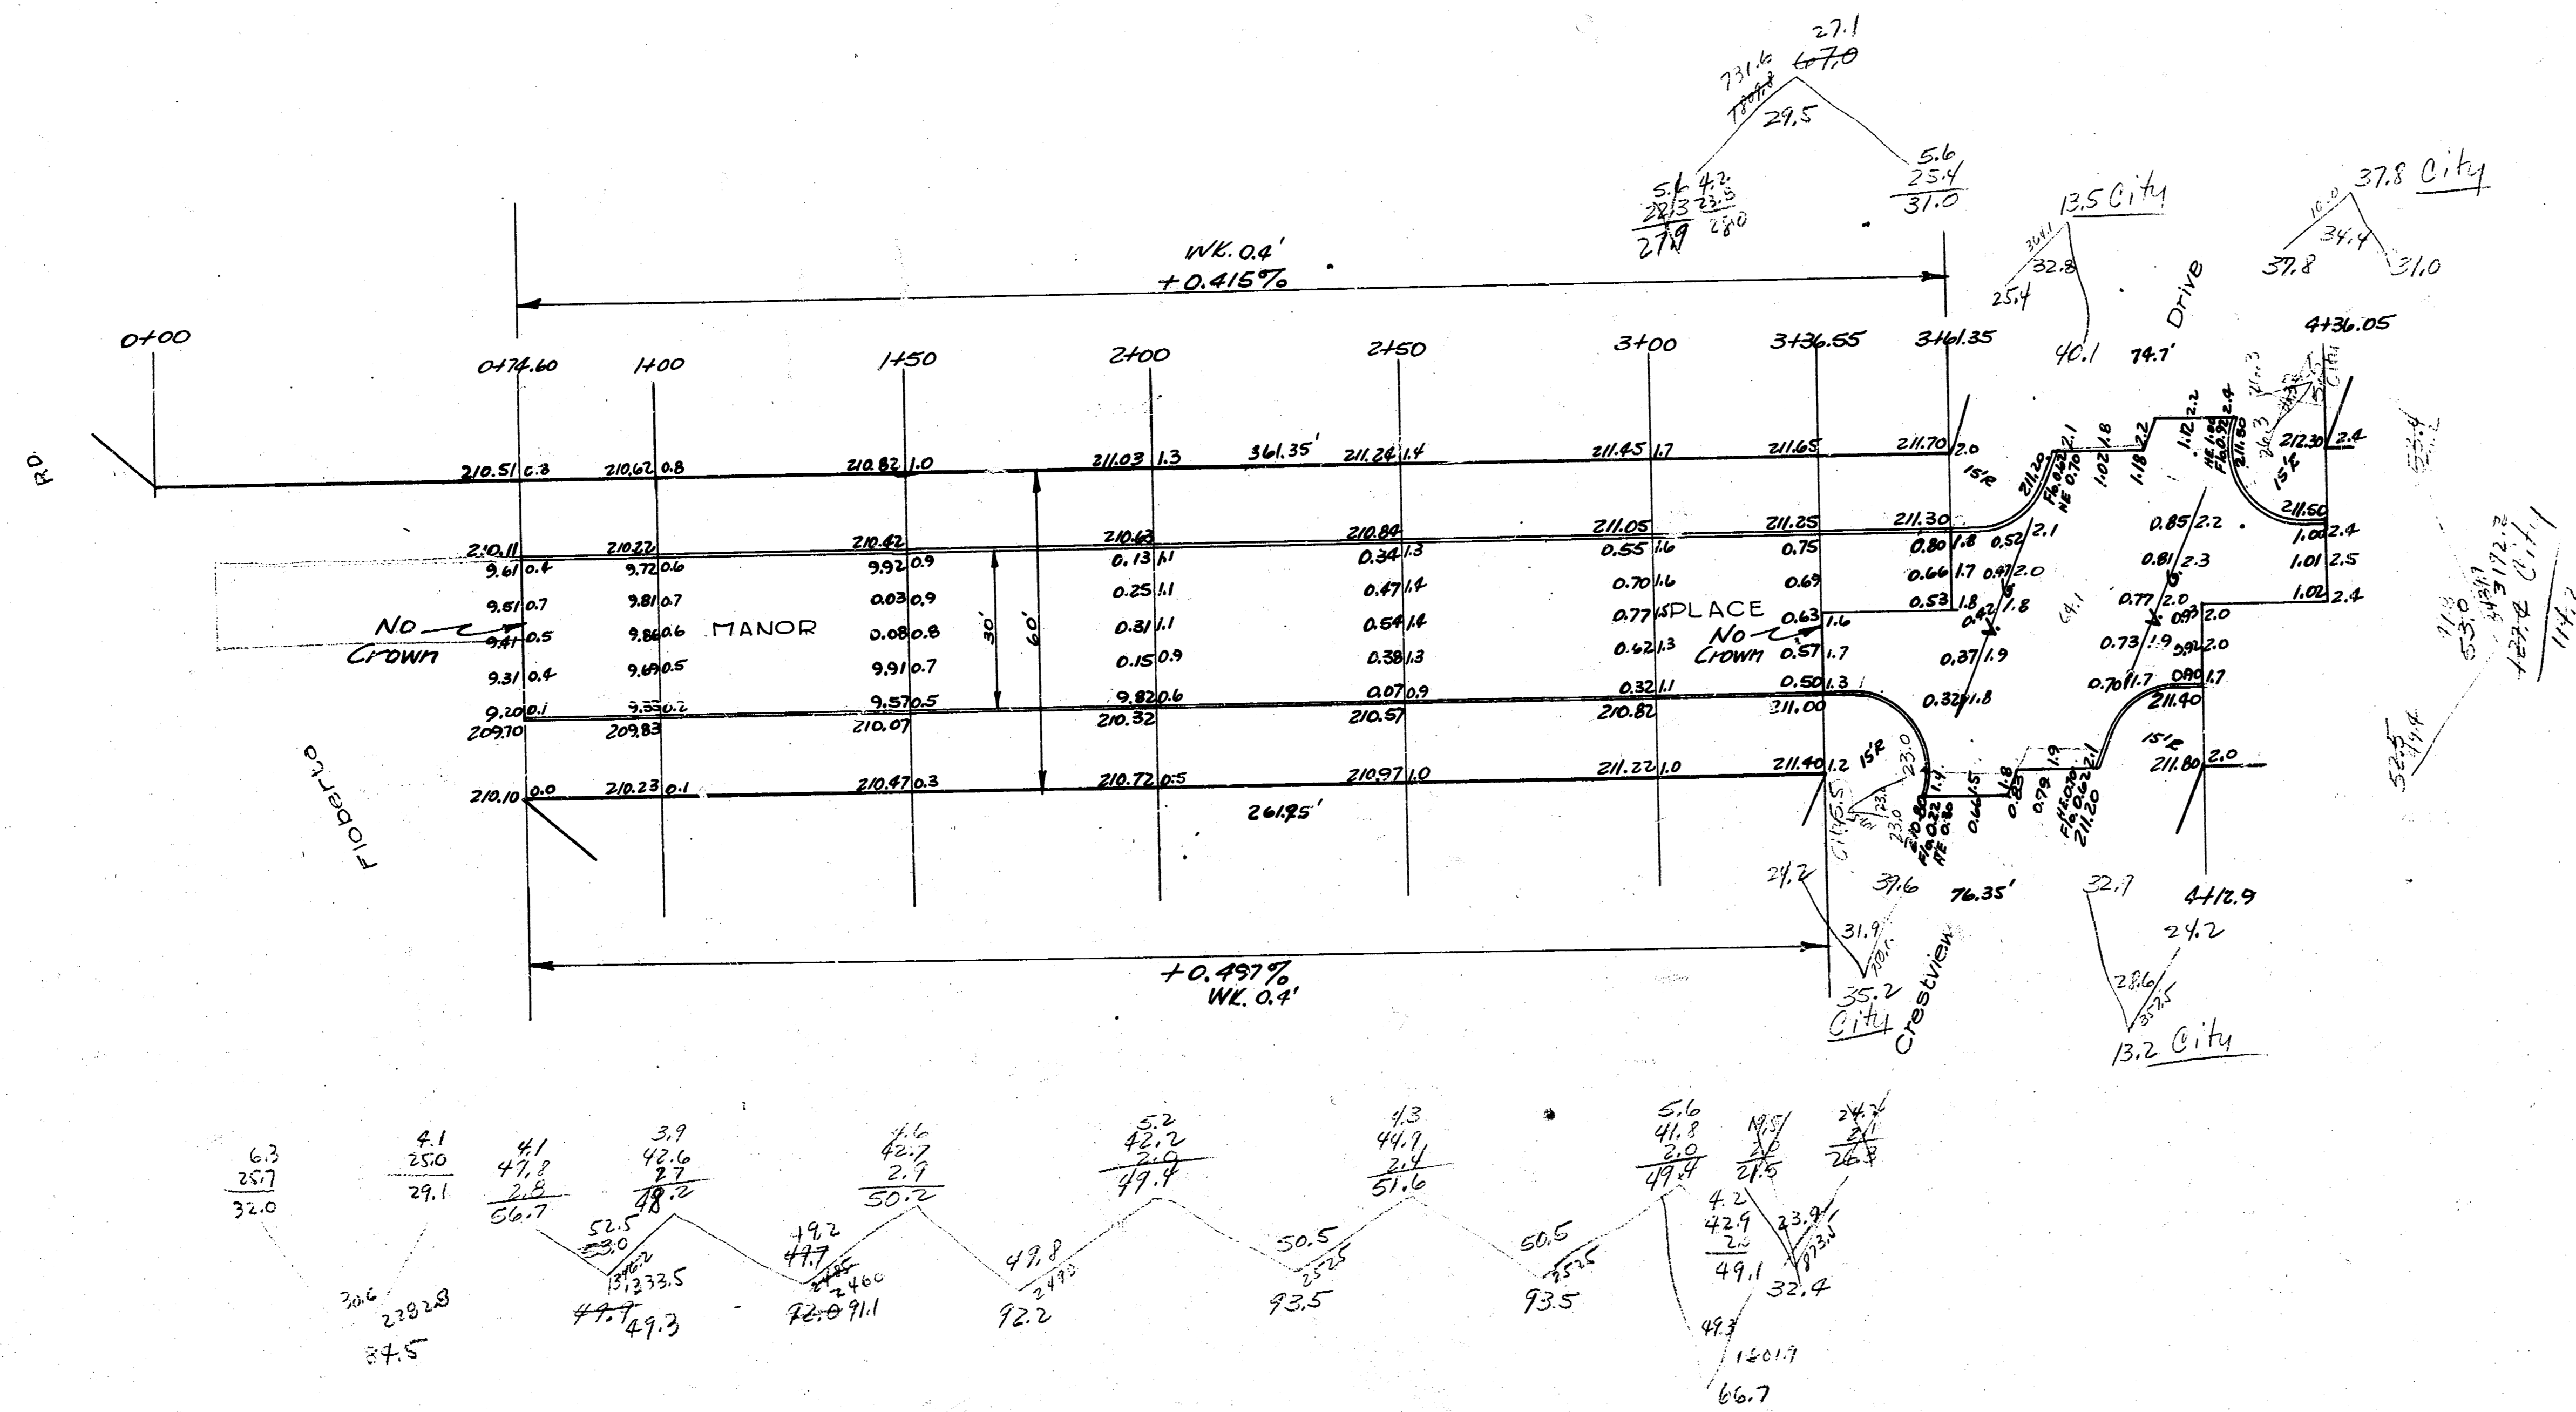



B.M. 21794 Top Iron E.L. Oliver N.L. Crestview Dr.

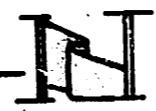

Prop.	City
47.9	5.5
72.0	35.2
72.2	13.2
73.5	127.4
73.5	5.5
32.4	37.8
67.0	13.5
520.5	235.2
+15%	+15%
572.6	258.9
572.6	258.9

Grand Total

Prop.	City
572.6	258.9
1105.7	1678.3

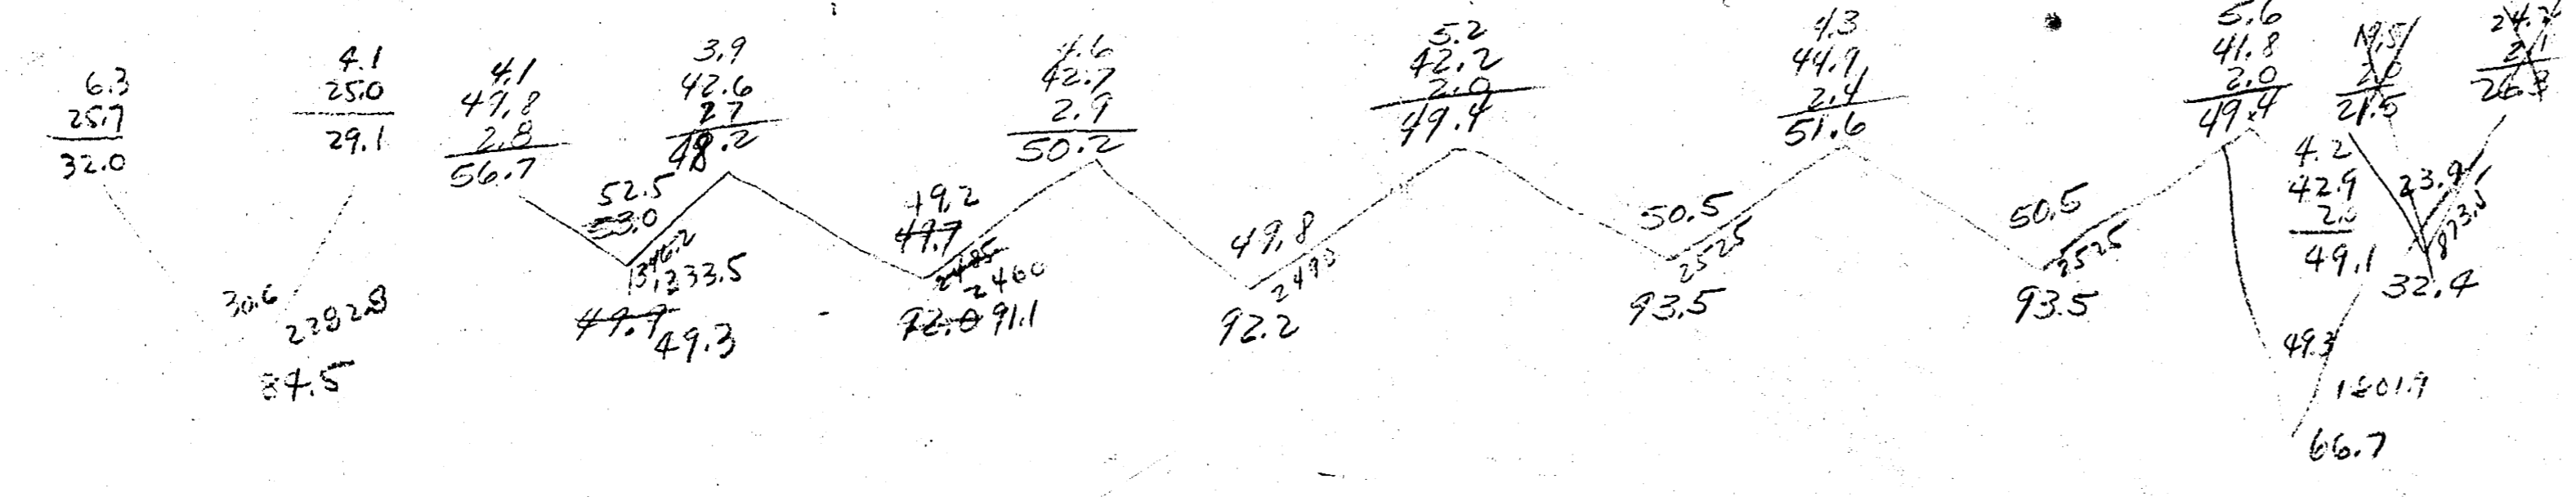

1/2

Manor Place
 Wt. Flaberta Road St Kensington
 30' Conc & Cb
 City of Wichita, Kansas
 LK White City Engineer
 Date: 9-28-48 Project No C18-127

