



BM 187.44 6" IN GLOBE N. CO. PINECREST & SL. CENTRAL

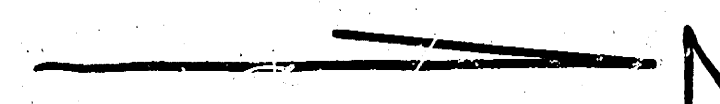

90
 26.9
 27.0
 26.9
 24.6
 114.4
 125.8

4.1
 4.5

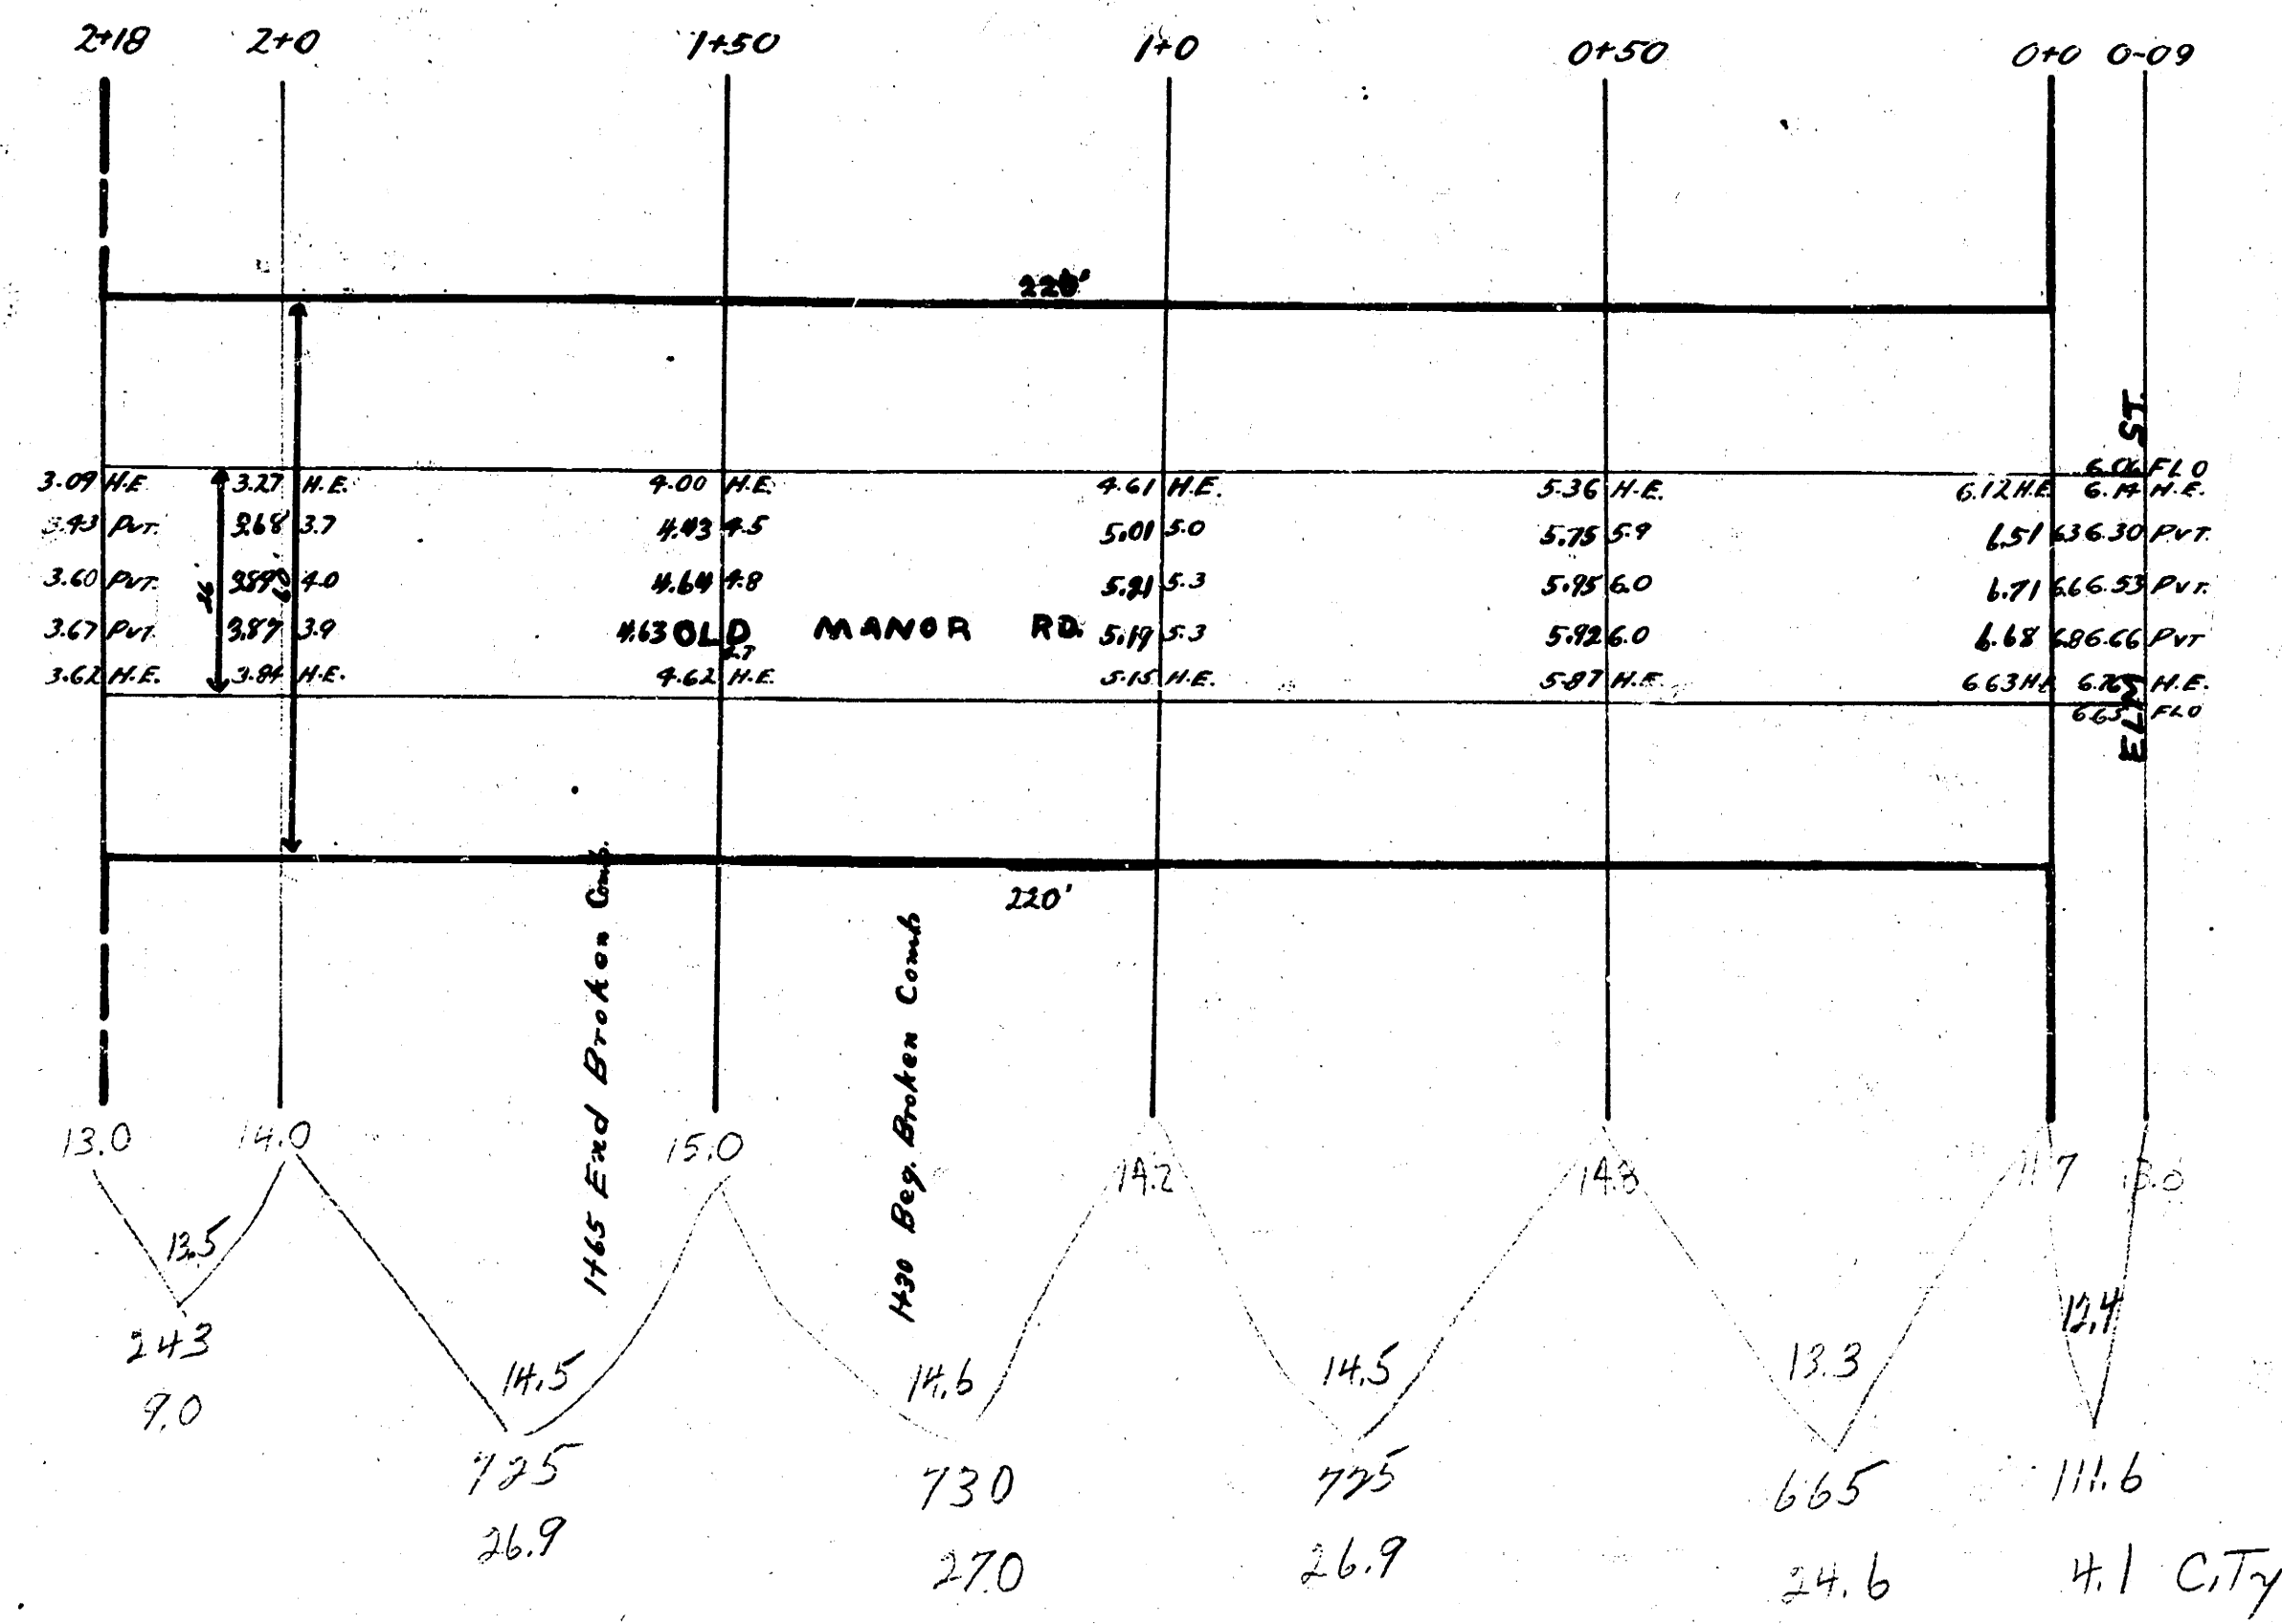

OLD MANOR RD.
 SL. ELM. 10' N. AL. CENTRAL
 26' Curb
 City of Wichita, Kansas
 L.K. WHITE City Engineer
 September 1907

4 15 4 8