

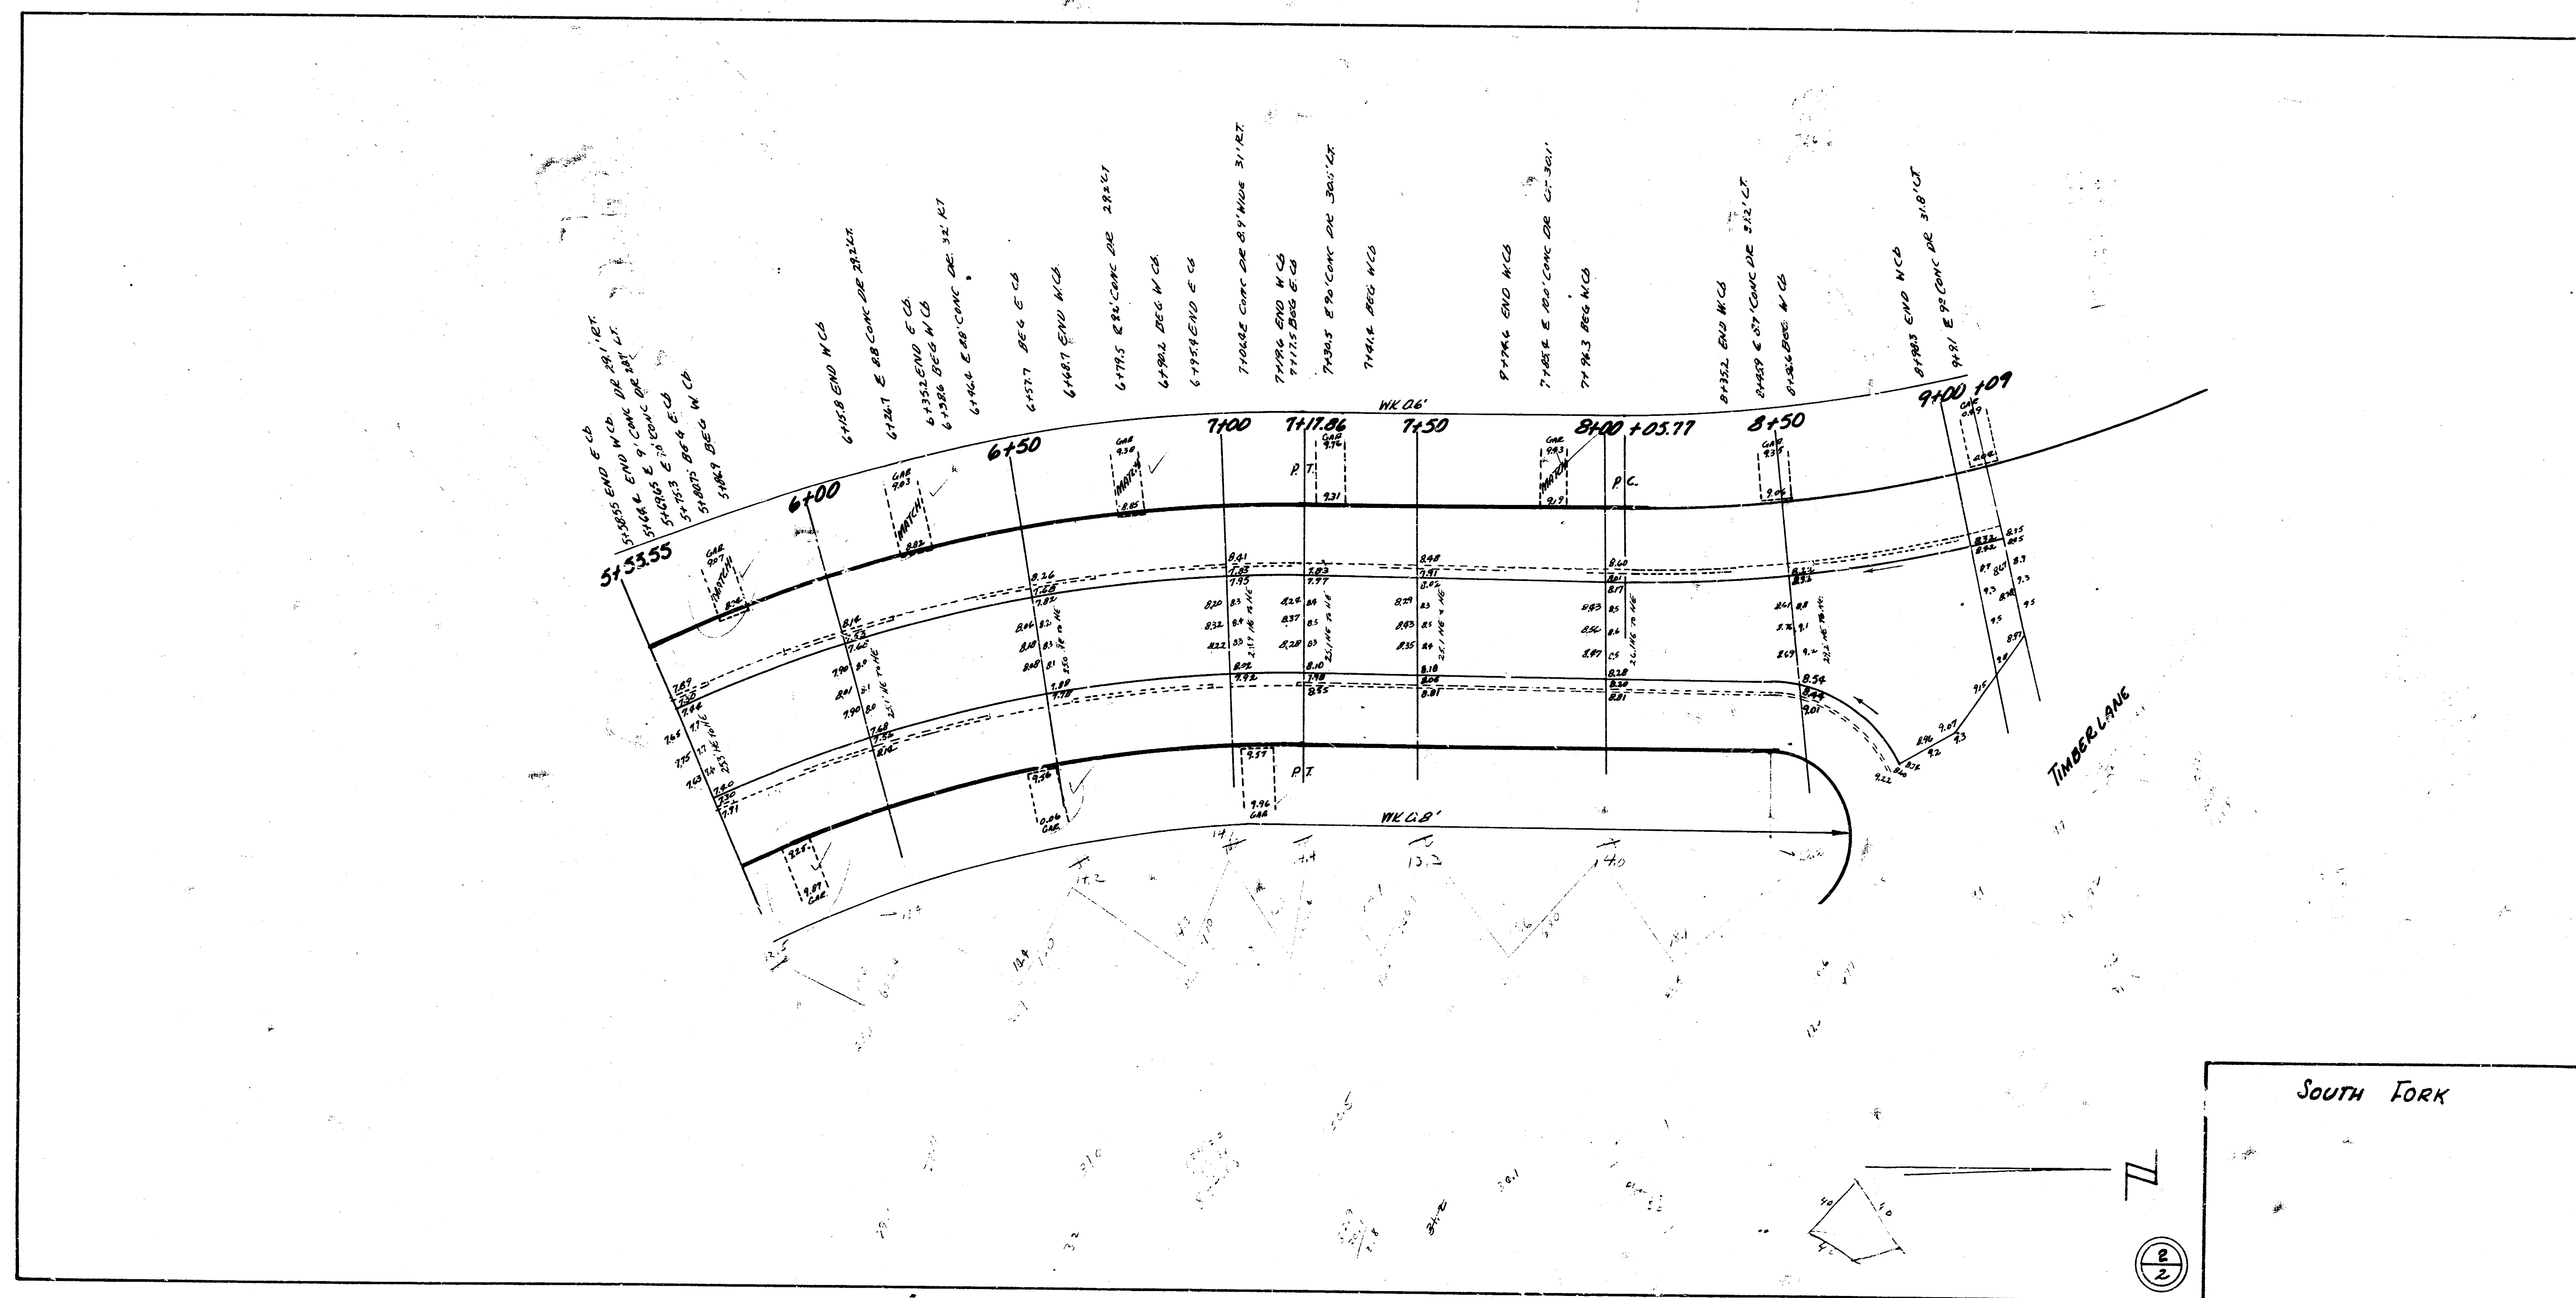
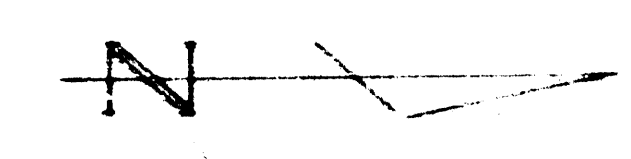


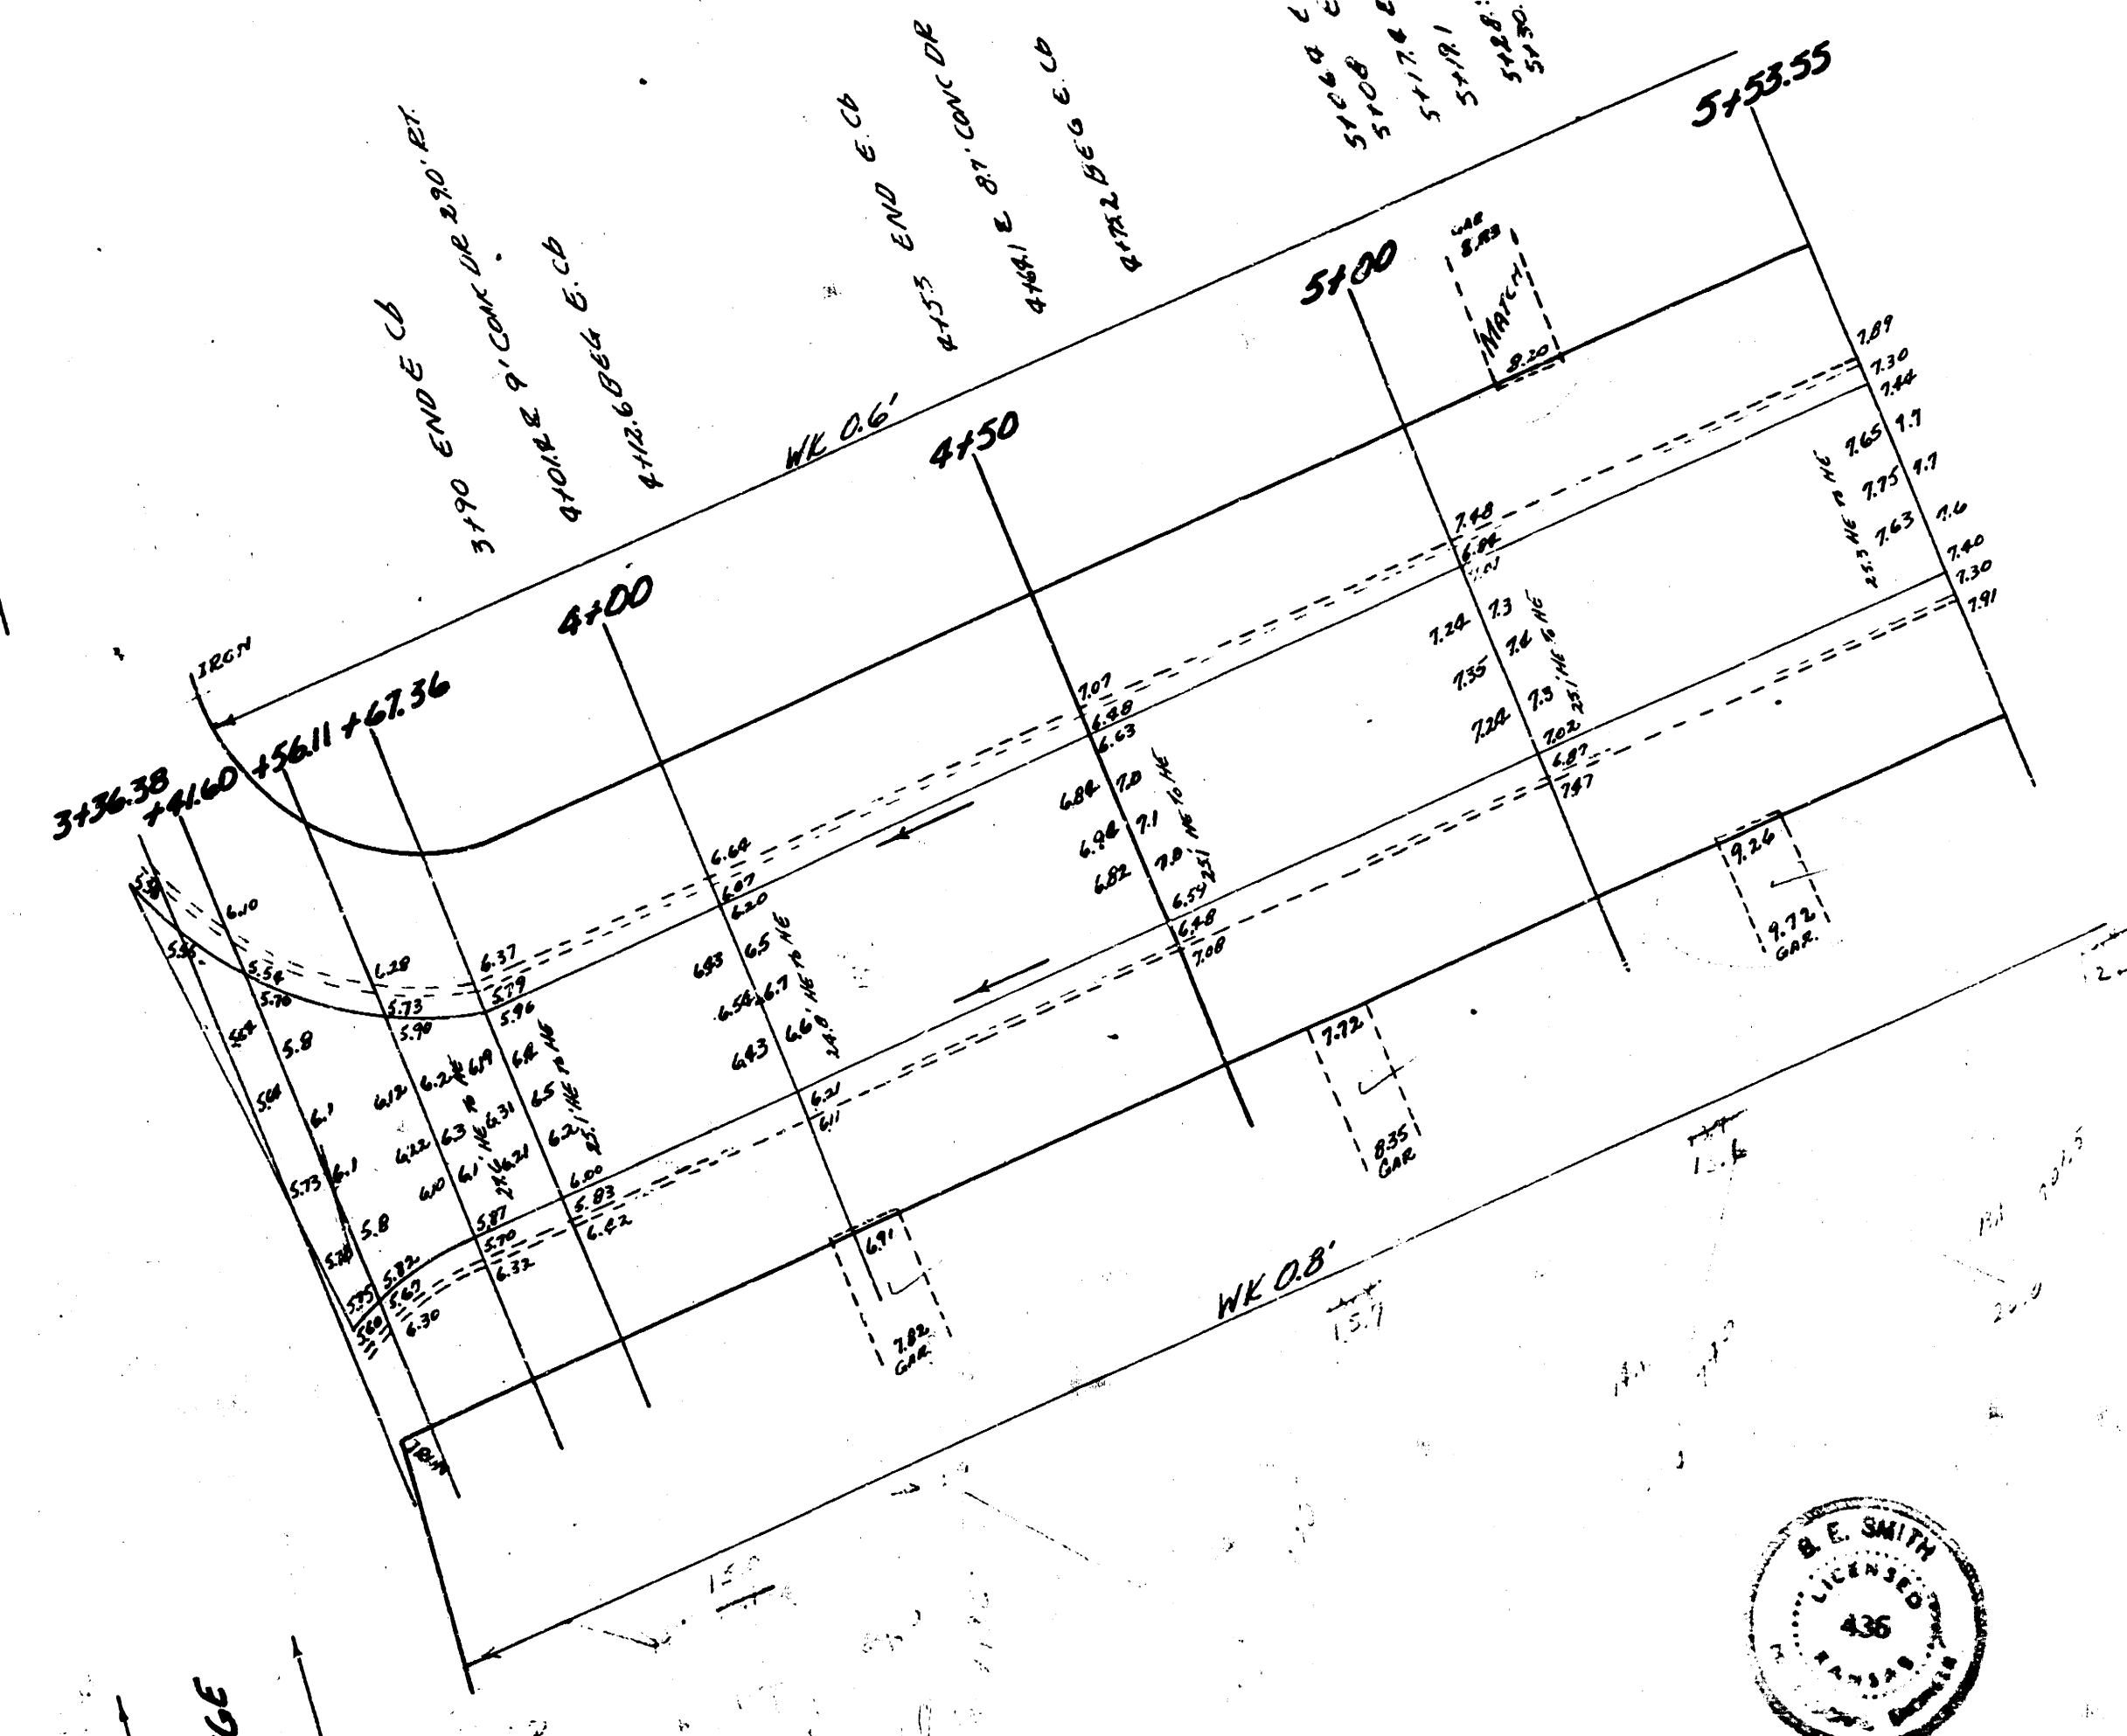

BM 99.07 N.W. COR. CONC. PAVEN 16" 3023 SOUTH FORK COURT
 BM 98.54 "1" IN MUELLER F. PAVEN N.W. COR. SOUTH FORK DR. & RANGE ROAD
 BM 101.37 N.W. COR. CONC. PAVEN 16" 2802 TIMBERLANE SE COR. TIMBERLANE & SOUTH FORK

STA ON E

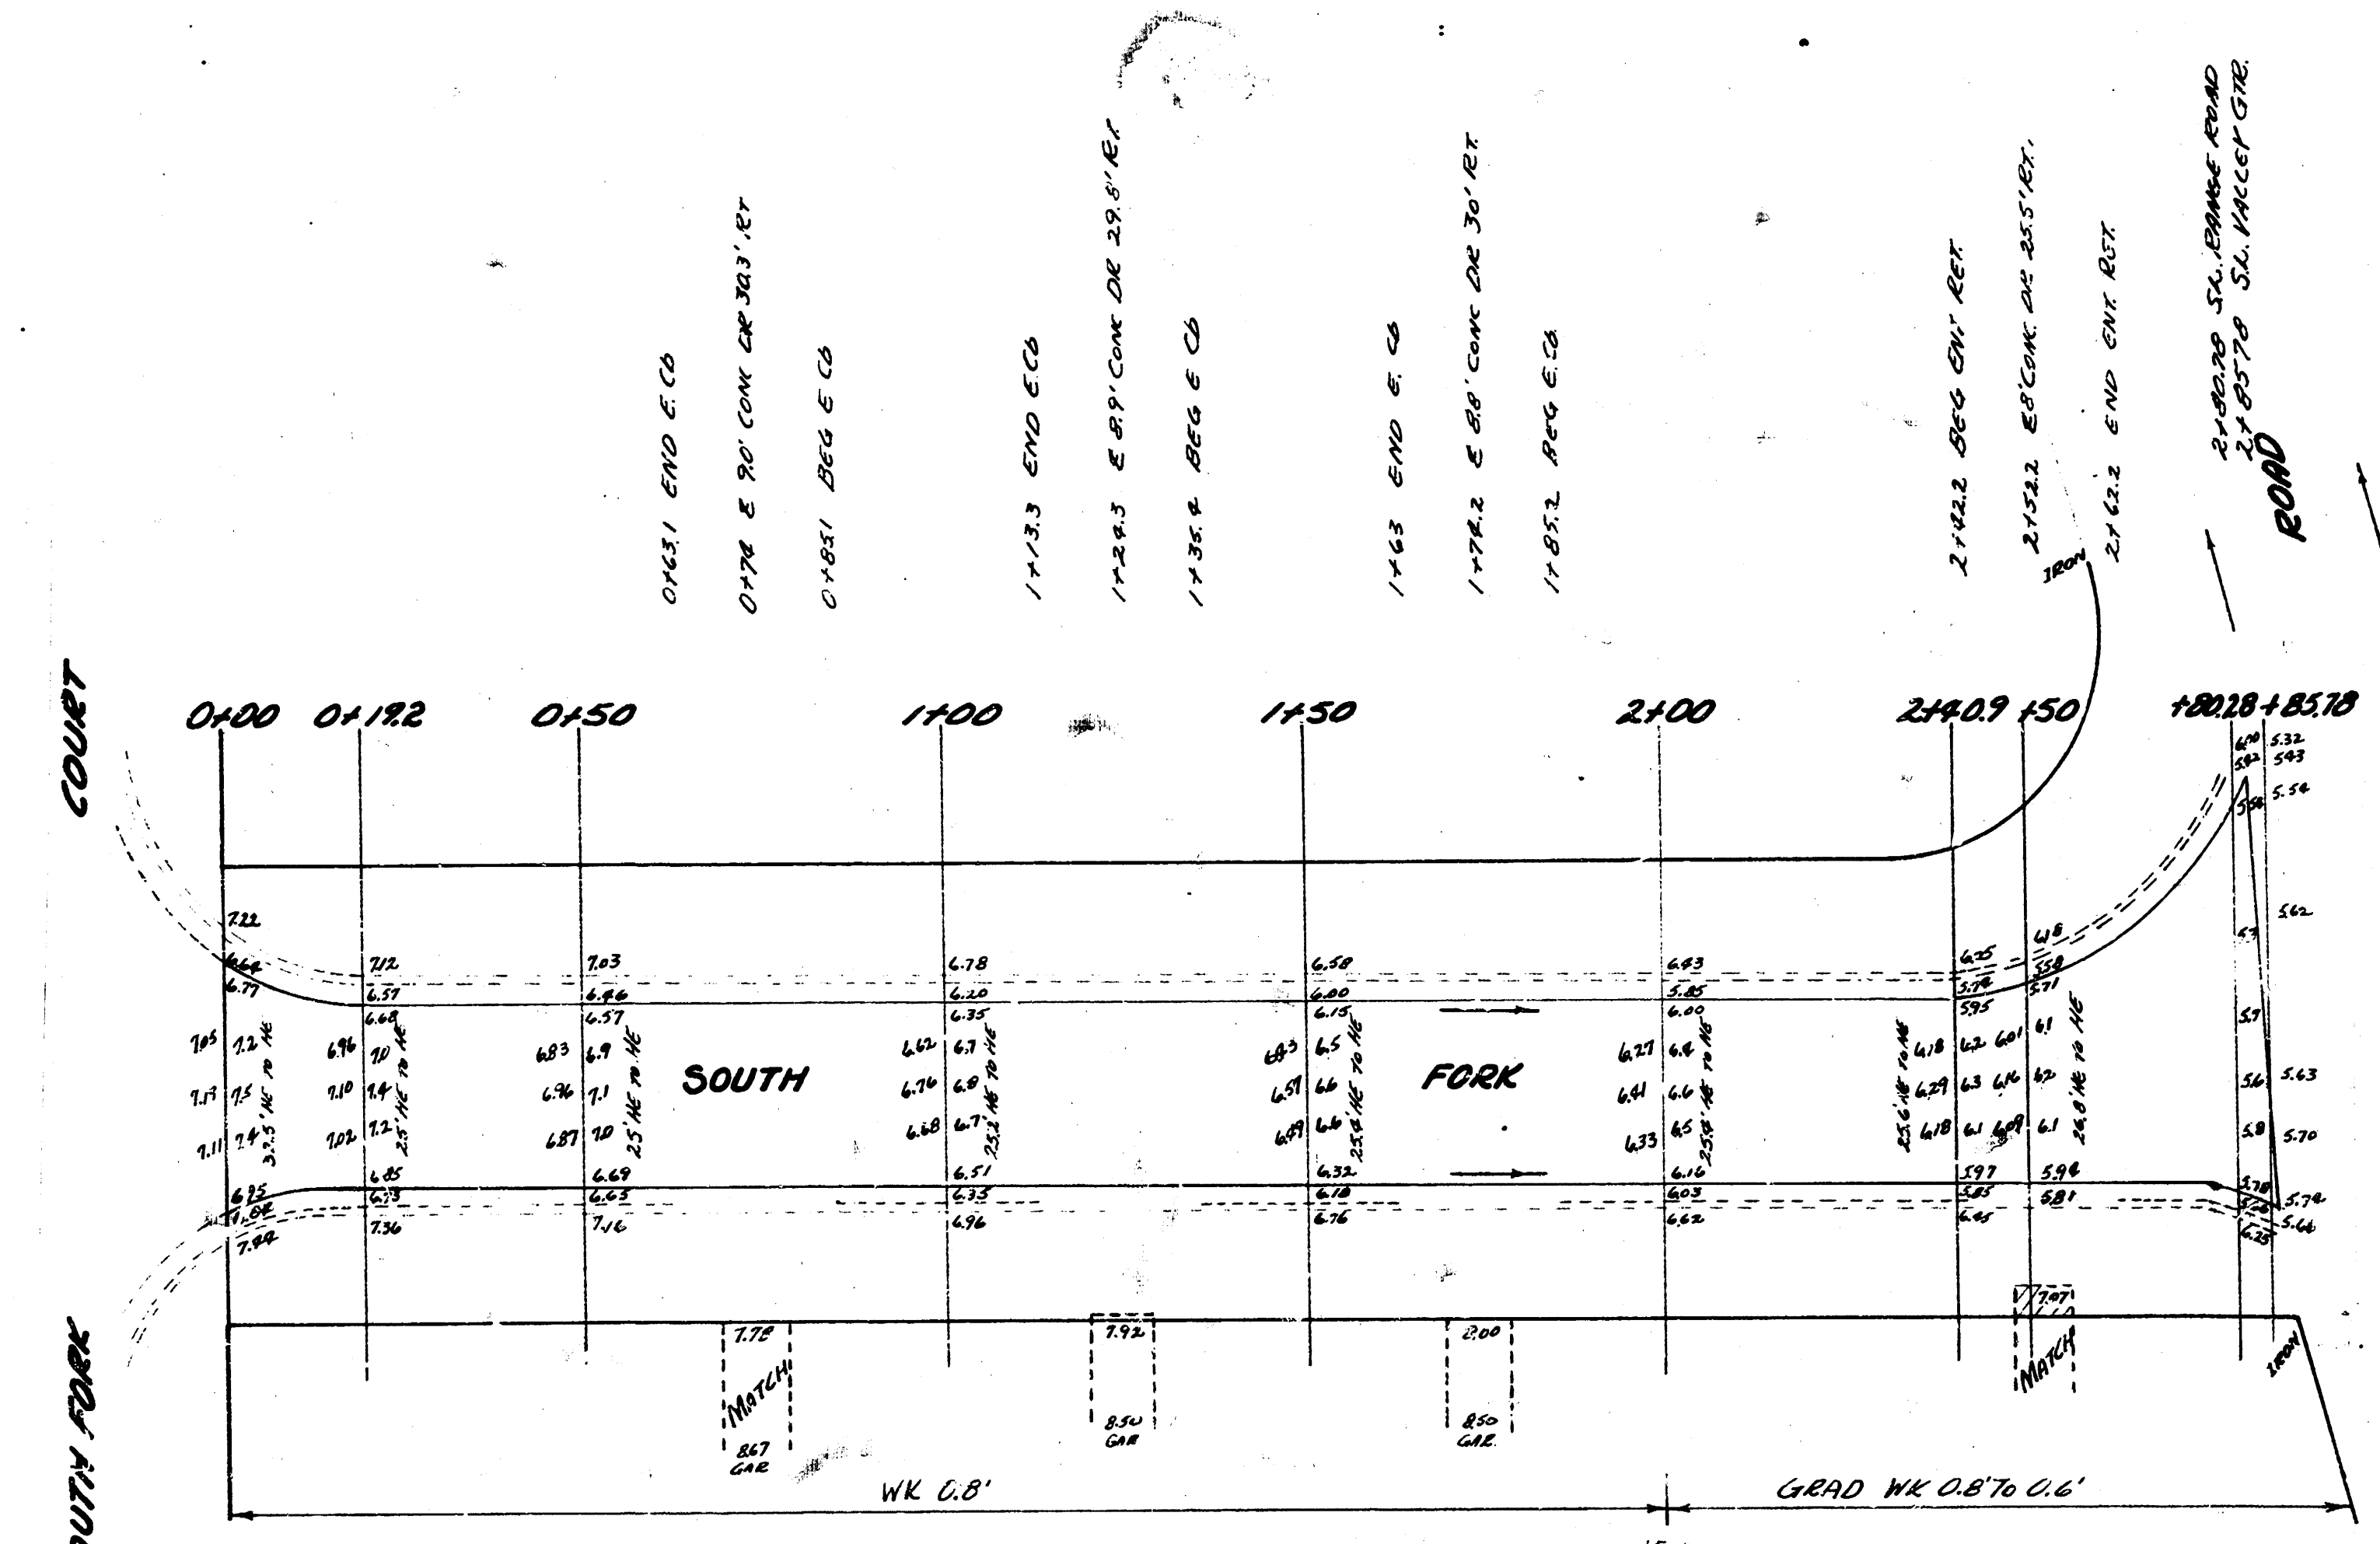

SOUTH FORK
 N.W. COR. CONC. PAVEN 16" 3023 SOUTH FORK COURT
 BM 98.54 "1" IN MUELLER F. PAVEN N.W. COR. SOUTH FORK DR. & RANGE ROAD
 BM 101.37 N.W. COR. CONC. PAVEN 16" 2802 TIMBERLANE SE COR. TIMBERLANE & SOUTH FORK
26' CONC.
CITY OF WICHITA KANSAS
B.E. SMITH CHIEF ENGINEER
 JUNE 1925