Set all elevations on E.S. .1 higher to provide some run off into intersection at Elm St.
P.S.F.

SPRUCE AVE. N.L. ELM TO S.L. FRISCO R/W: 30' CONCRETE INTEGRAL CURB

B.M. Elev. 118.23 Top W. end Conc. Pipe W.S. Grove N.S. Frisco Flr.
118.99 Kirn Keller on Wk 20' S. of Frisco Elev. E.S. Spruce.
114.37 Top of Thru C. Elm & Spruce.
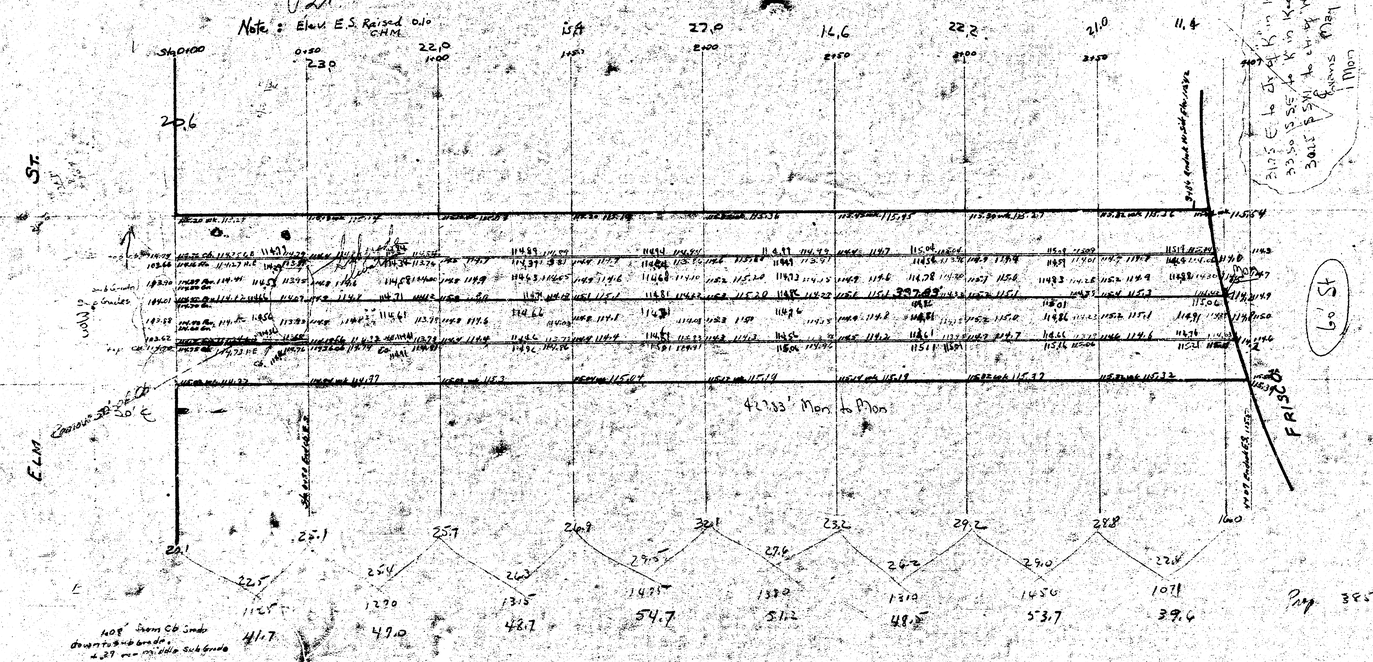
Note: Elev. E.S. Raised 0.10 C.H.M.