


1941
 SPRUCE ST. - SL. RANDOM ROAD - N.L. MURDOCK AVE.
 26-2-30 - 2" A.C. - 5" CONC. BASE

Figures on right side of sta. line are ground elev's.
 Figures on left side of sta. line are grade elev's.

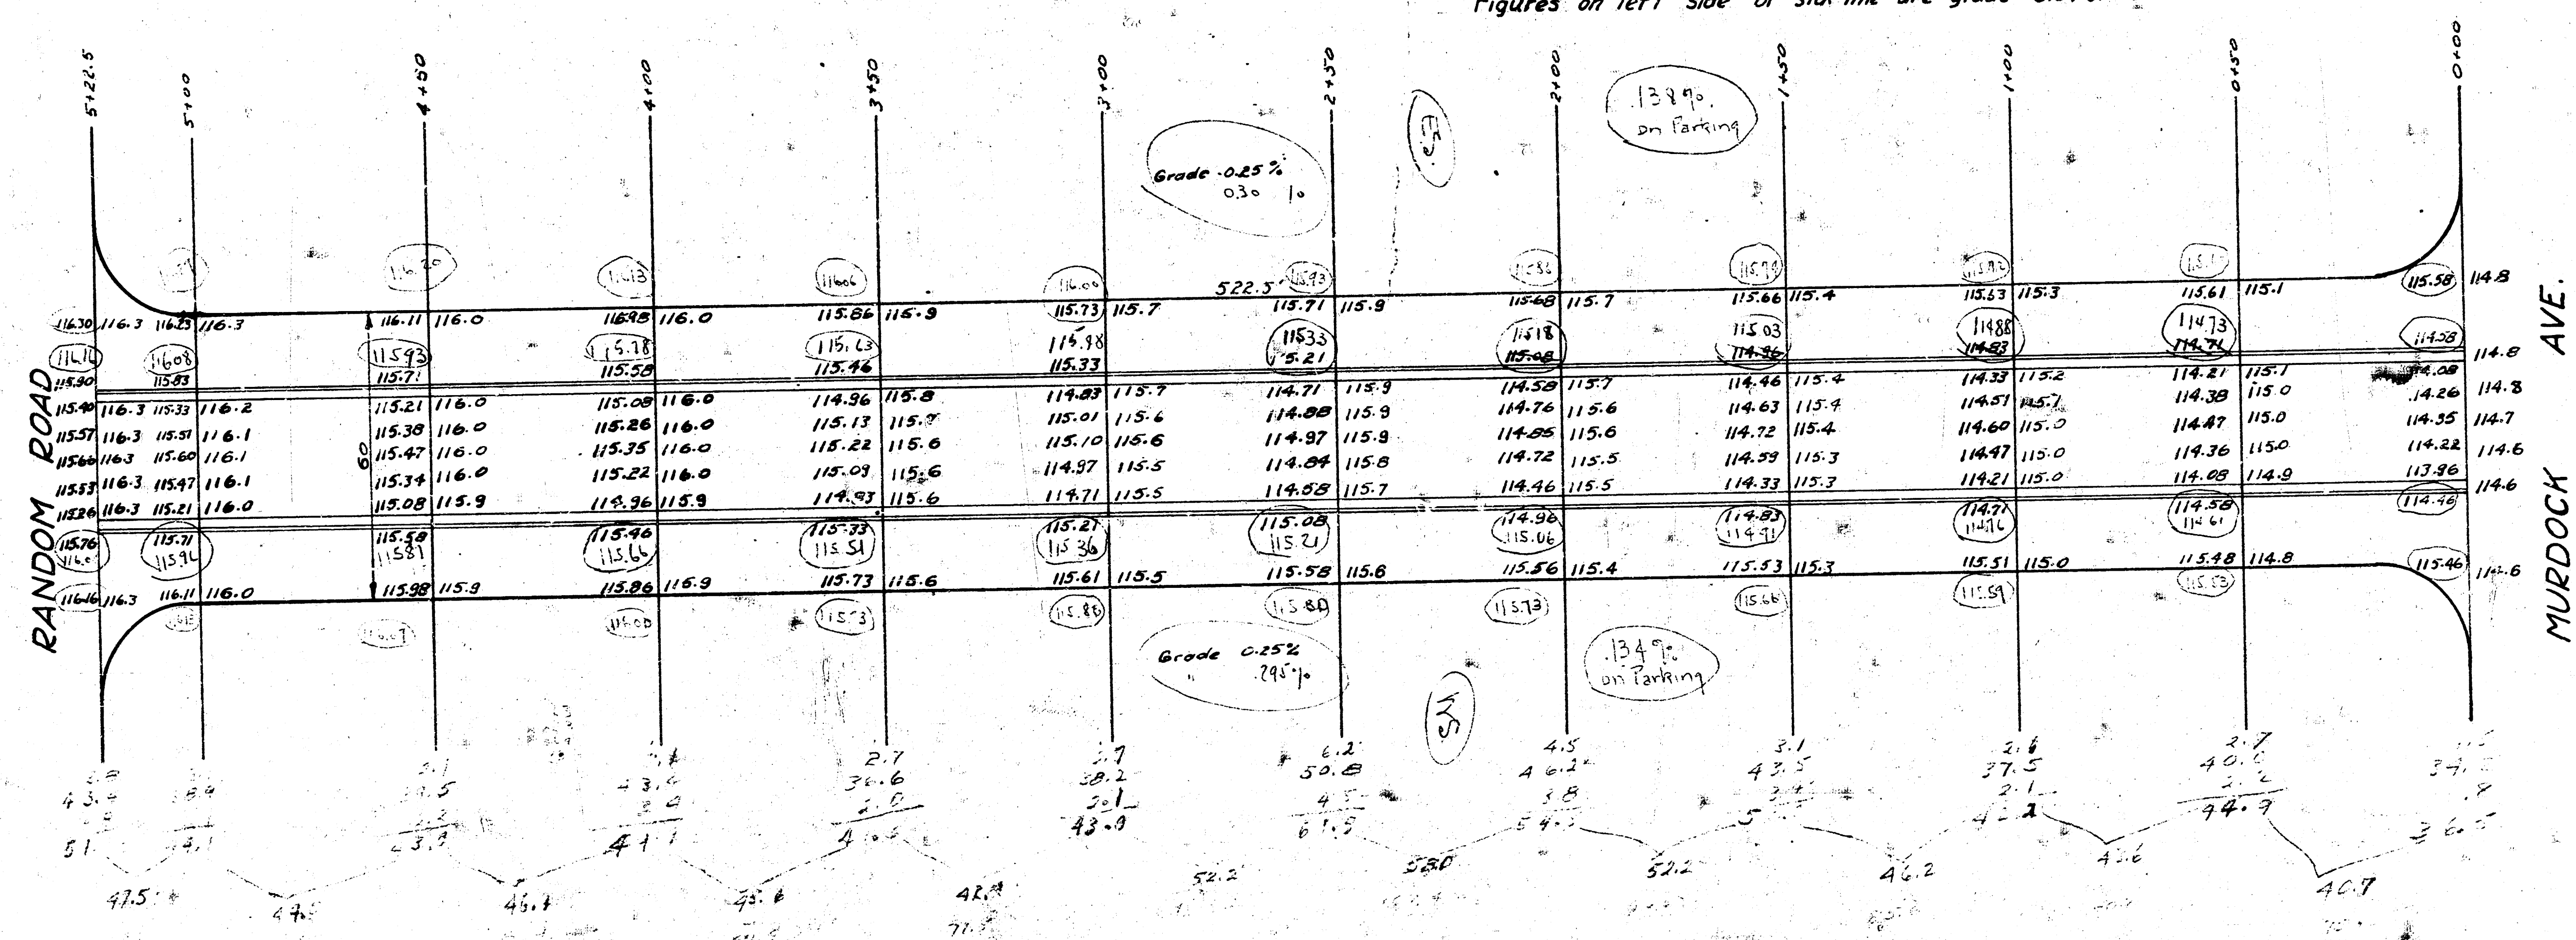

B.M. - H7-03 118.23 Top of West end of 42" conc. pipe at
 Grove & N.S. Frisco R/W.

Total cu. yds 912.4
 94.2
 1003.6