
1941
SPRUCE ST. - SS. 10TH SS. 11TH
26' CONC.

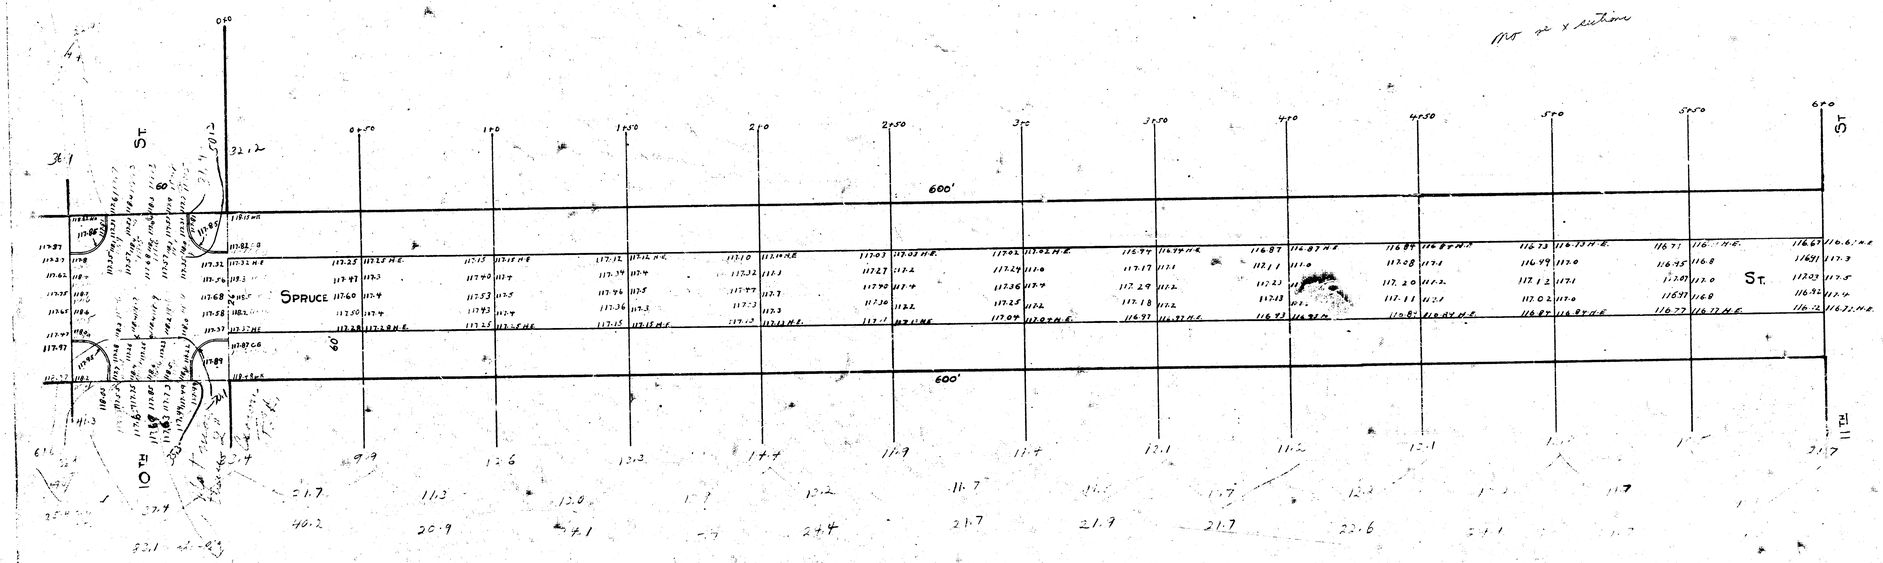


B.M. 117.35 "C" IN CAMPBELL C.W.S. S.W. SPRUCE & 11TH
B.M. 117.87 E.C.B. SPRUCE N.L. 10TH