
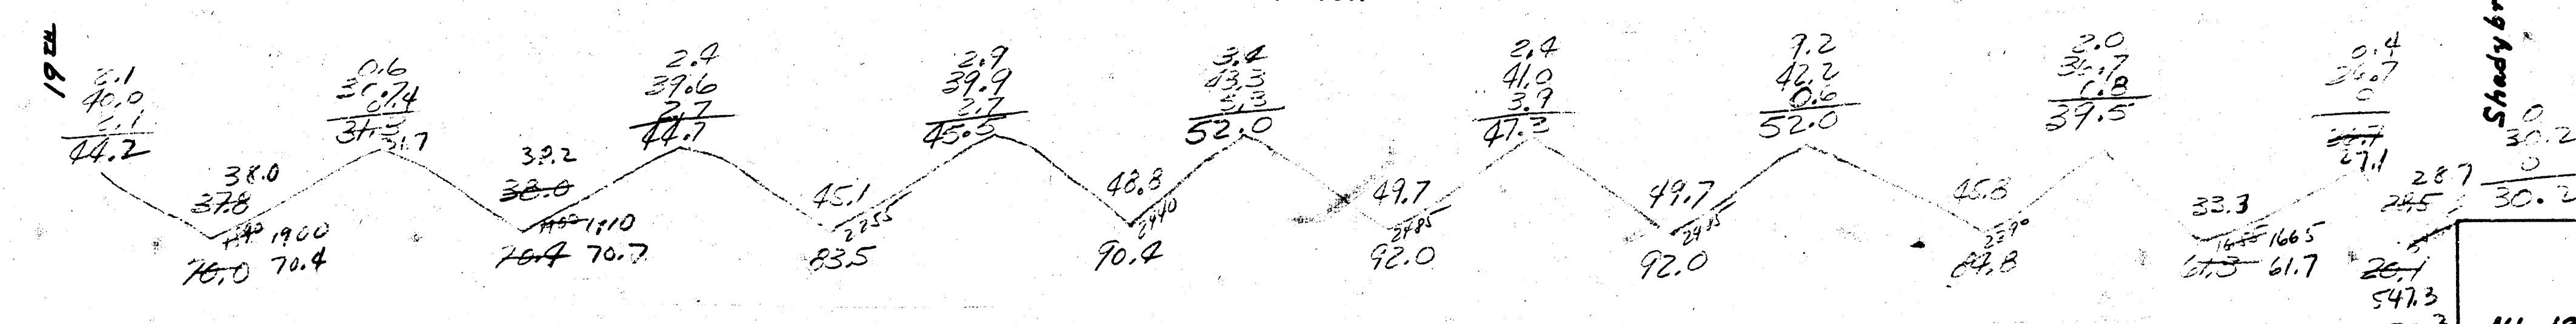


B.M. 130.52 "6" in globe on Wk. S.S. Drive at 2002 N. Grove

Prop. C.F.
 100
 70.2
 63.5
 90.2
 12.0
 92.0
 50.8
 61.3
 30.1
 30.2
 694.7
 +10%
 764.2 C.F. 100

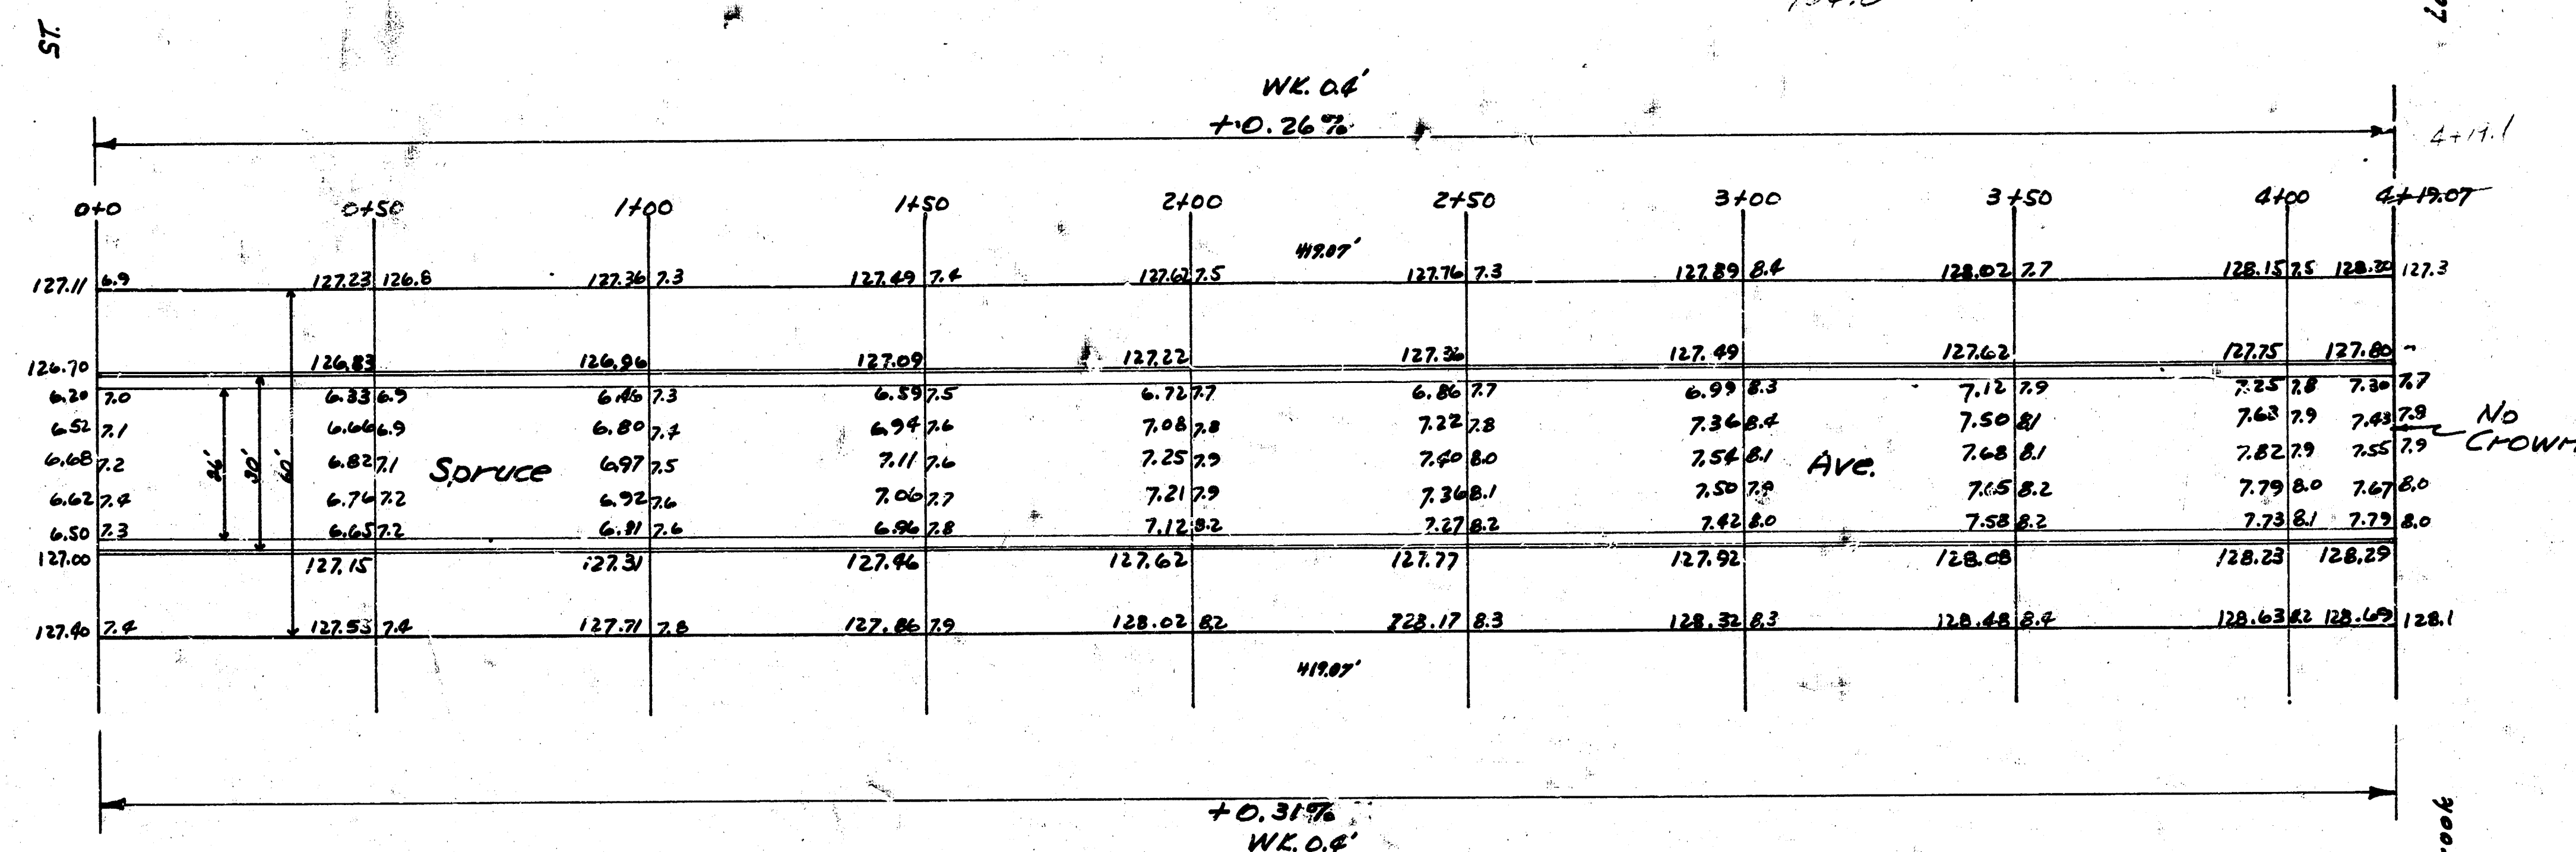

Spruce Ave.
 N.L. 19" — S.L. Shadybrook Lane
 26' 2' 30" A.C.
 City of Wichita, Kansas
 L.H. White City Engineer
 August 1948 Project C18-116