
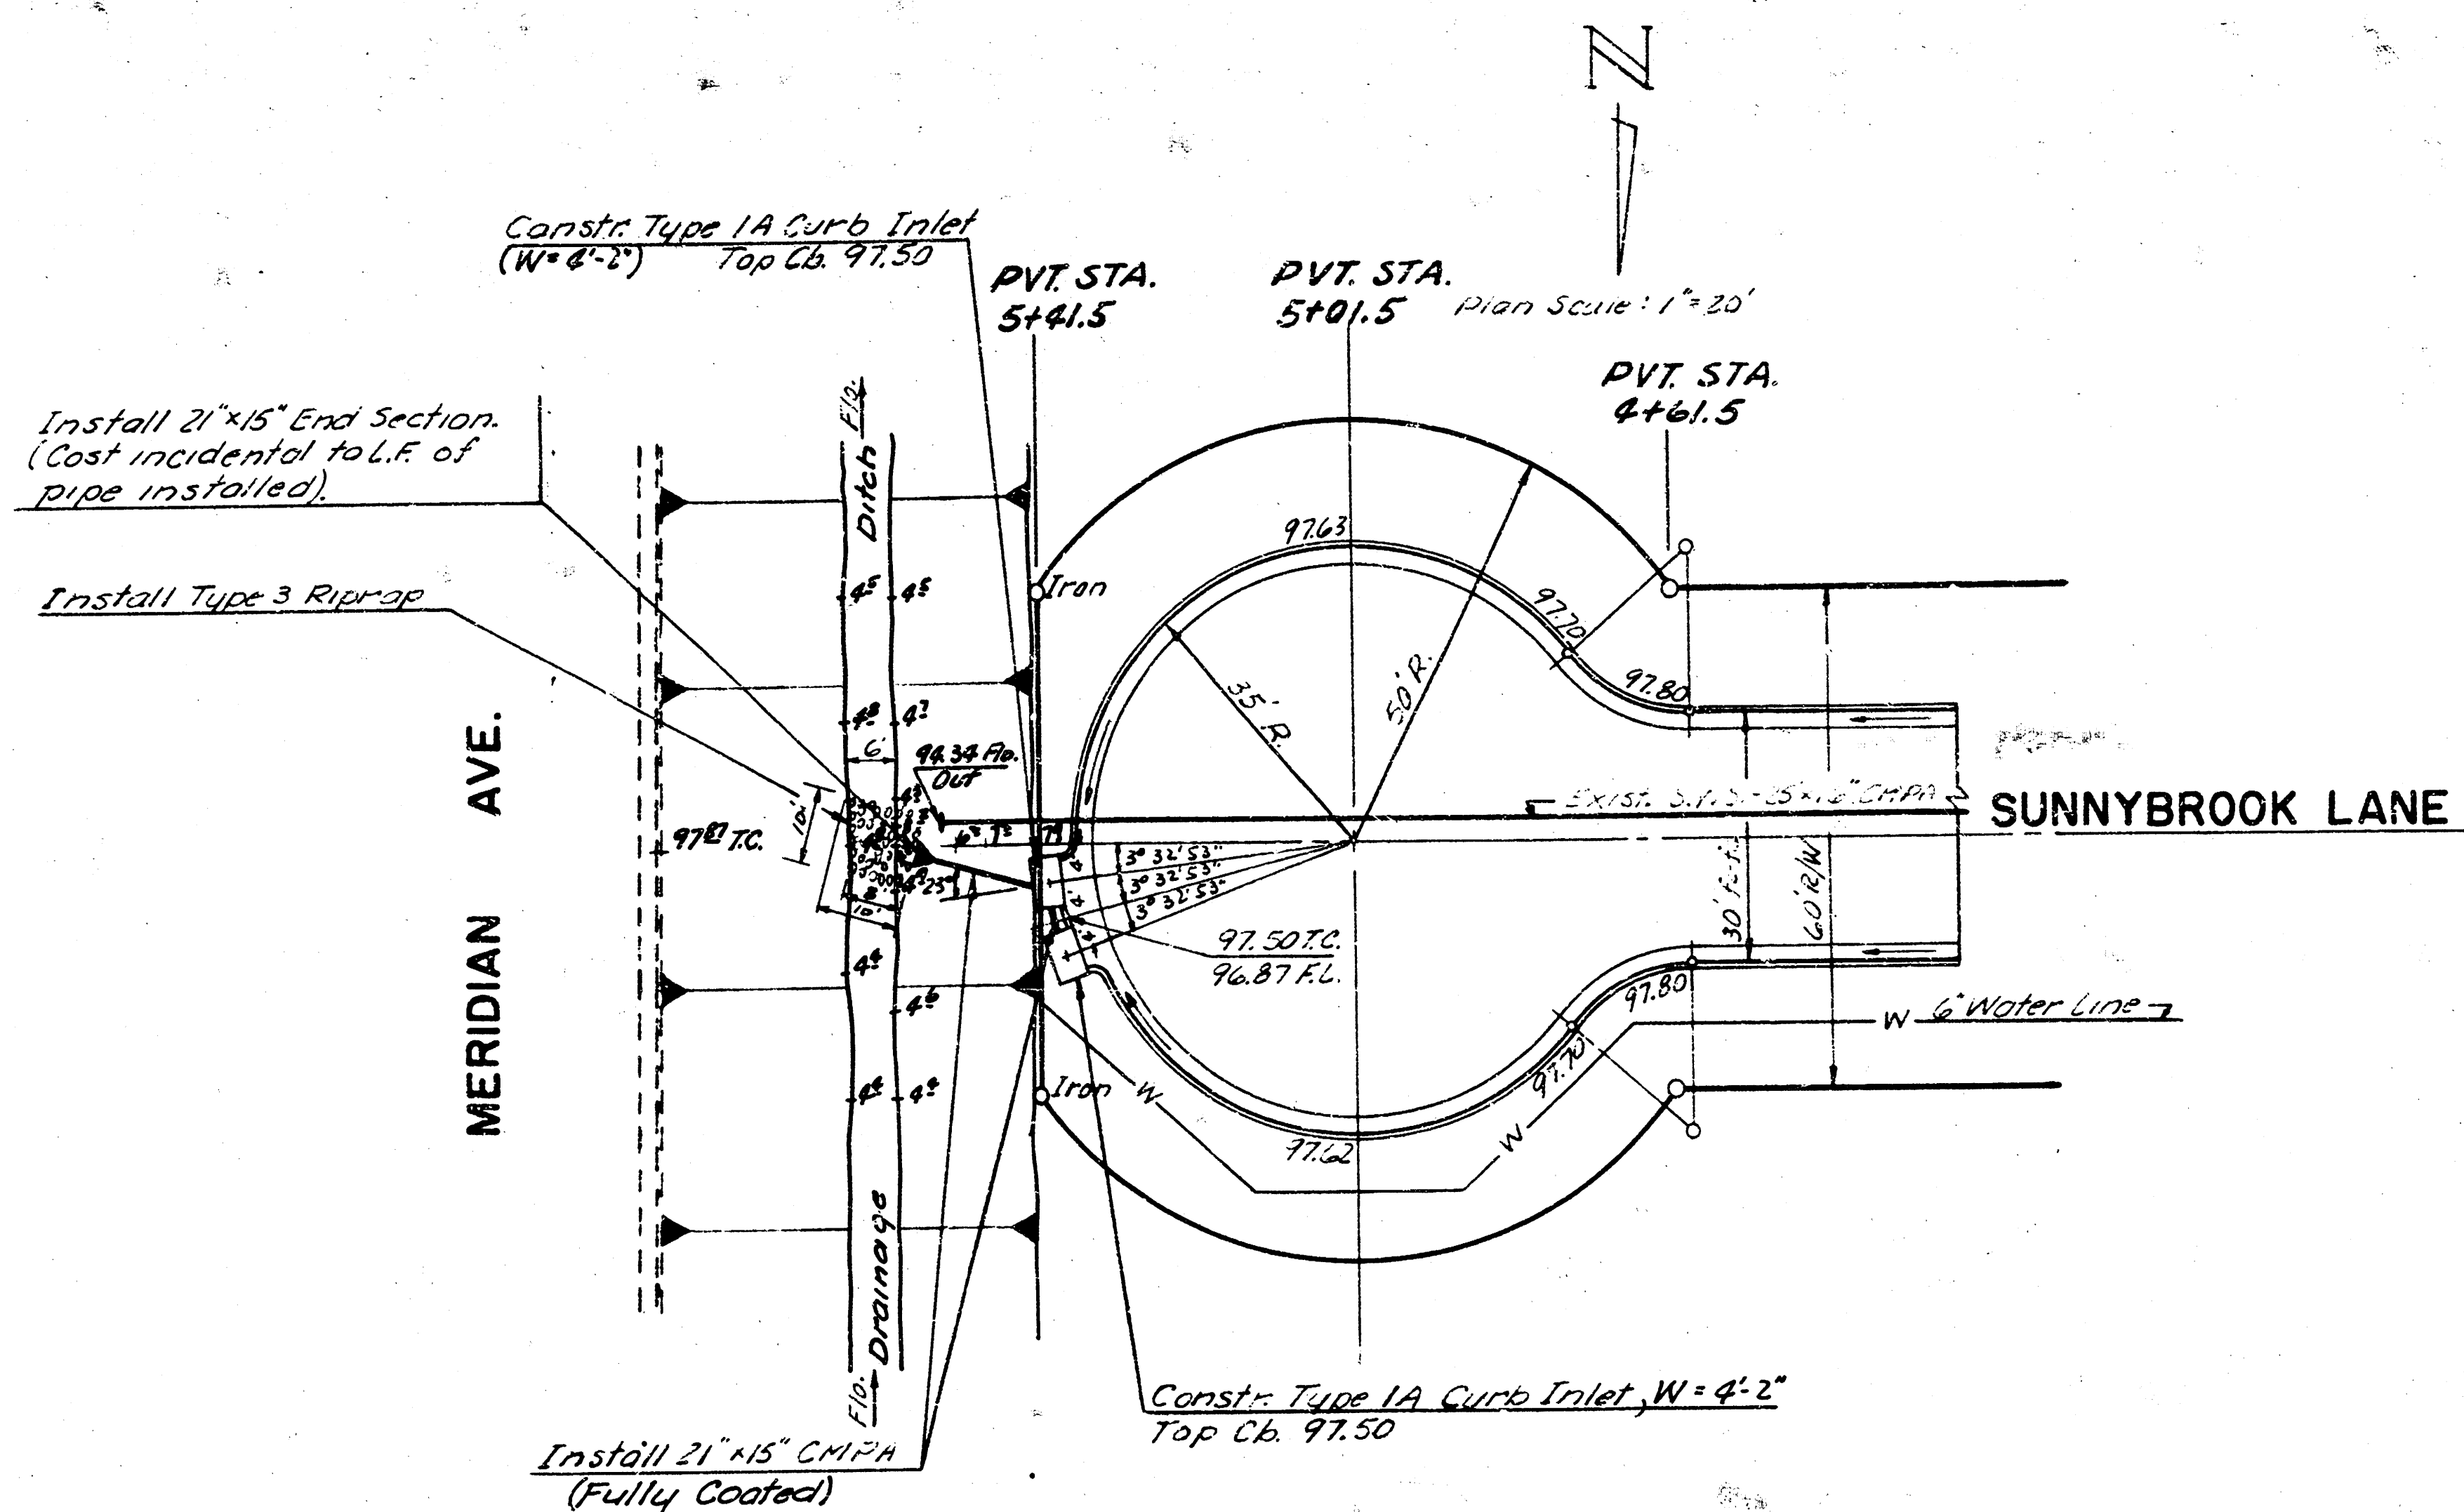




PLAN	DATE	BY
	2/2/79	ZLK
	NOTES	ALC
	NO. 101	1/1

PROFILE	DATE	BY
	2/2/79	ZLK
	NOTES	ALC
	NO. 101	1/1




B.M. 98.55 "d" Top of Sunnybrook 5' W. of W. Richmond
 B.M. 98.80 R.R. Spk. N.W. 1/4 R.P. S.E. Cont. Richmond 1 Southgate

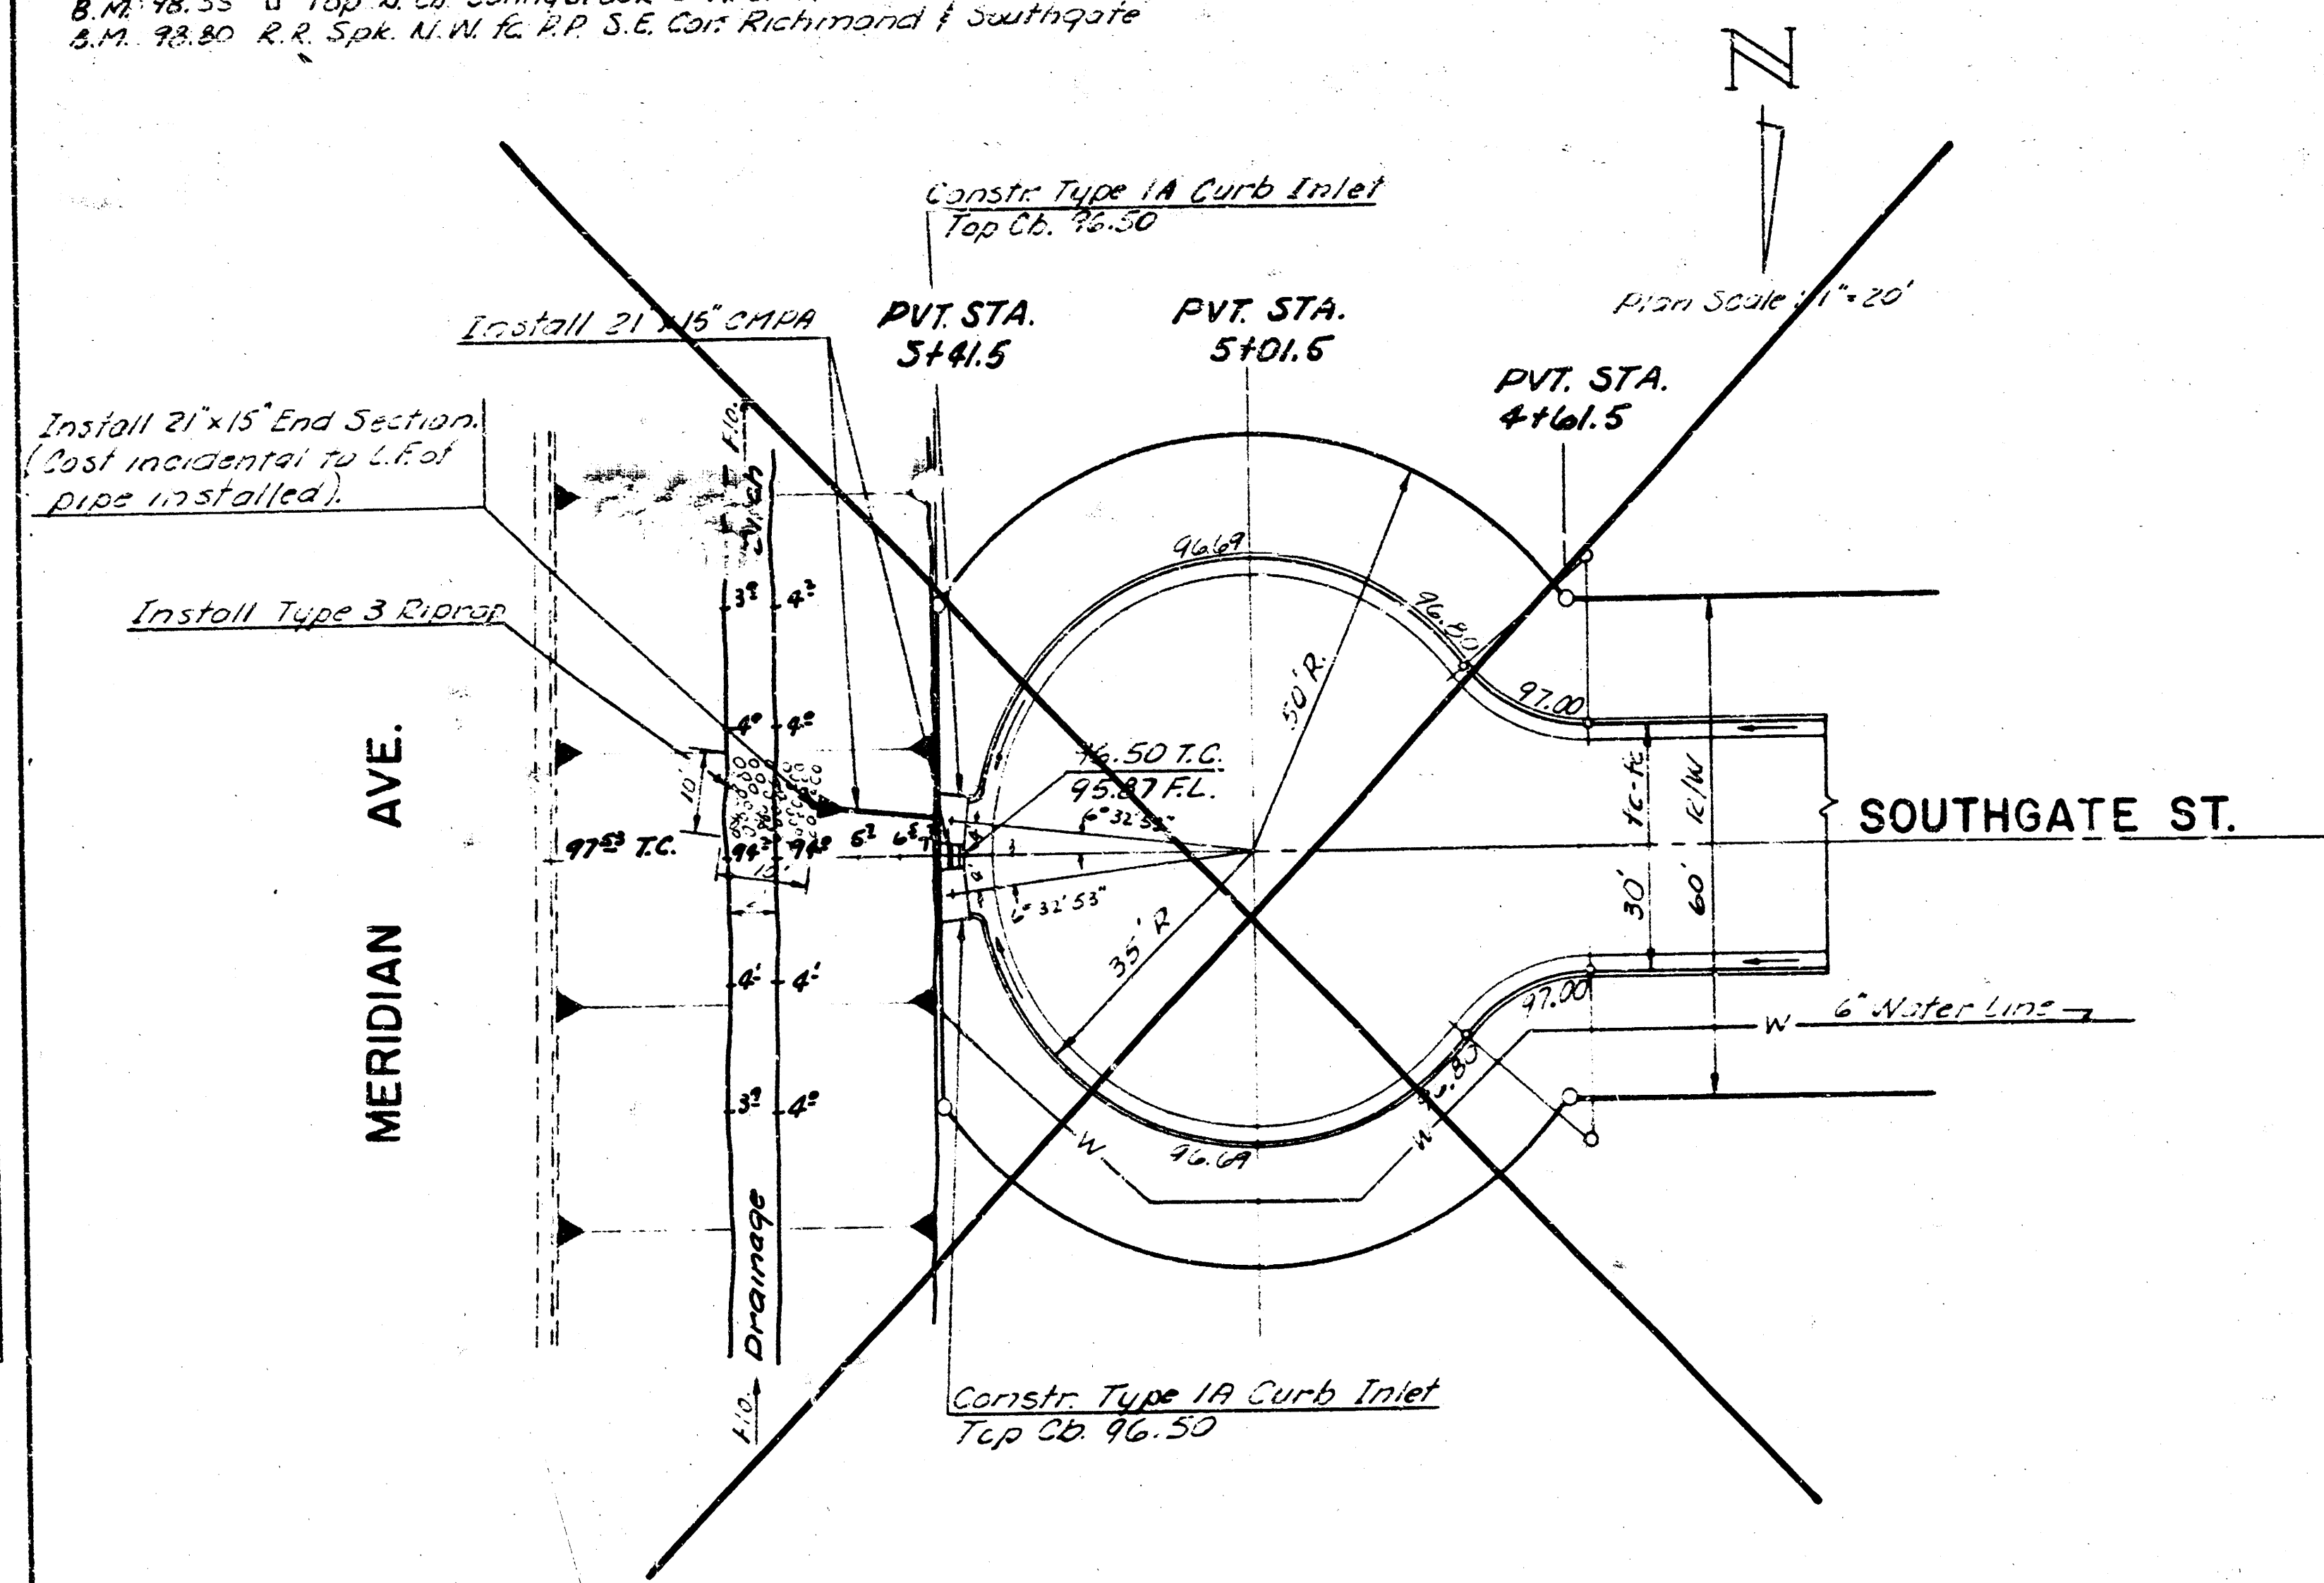

Profile Scale: Horiz. 1" = 20'
 Vert. 1" = 5'

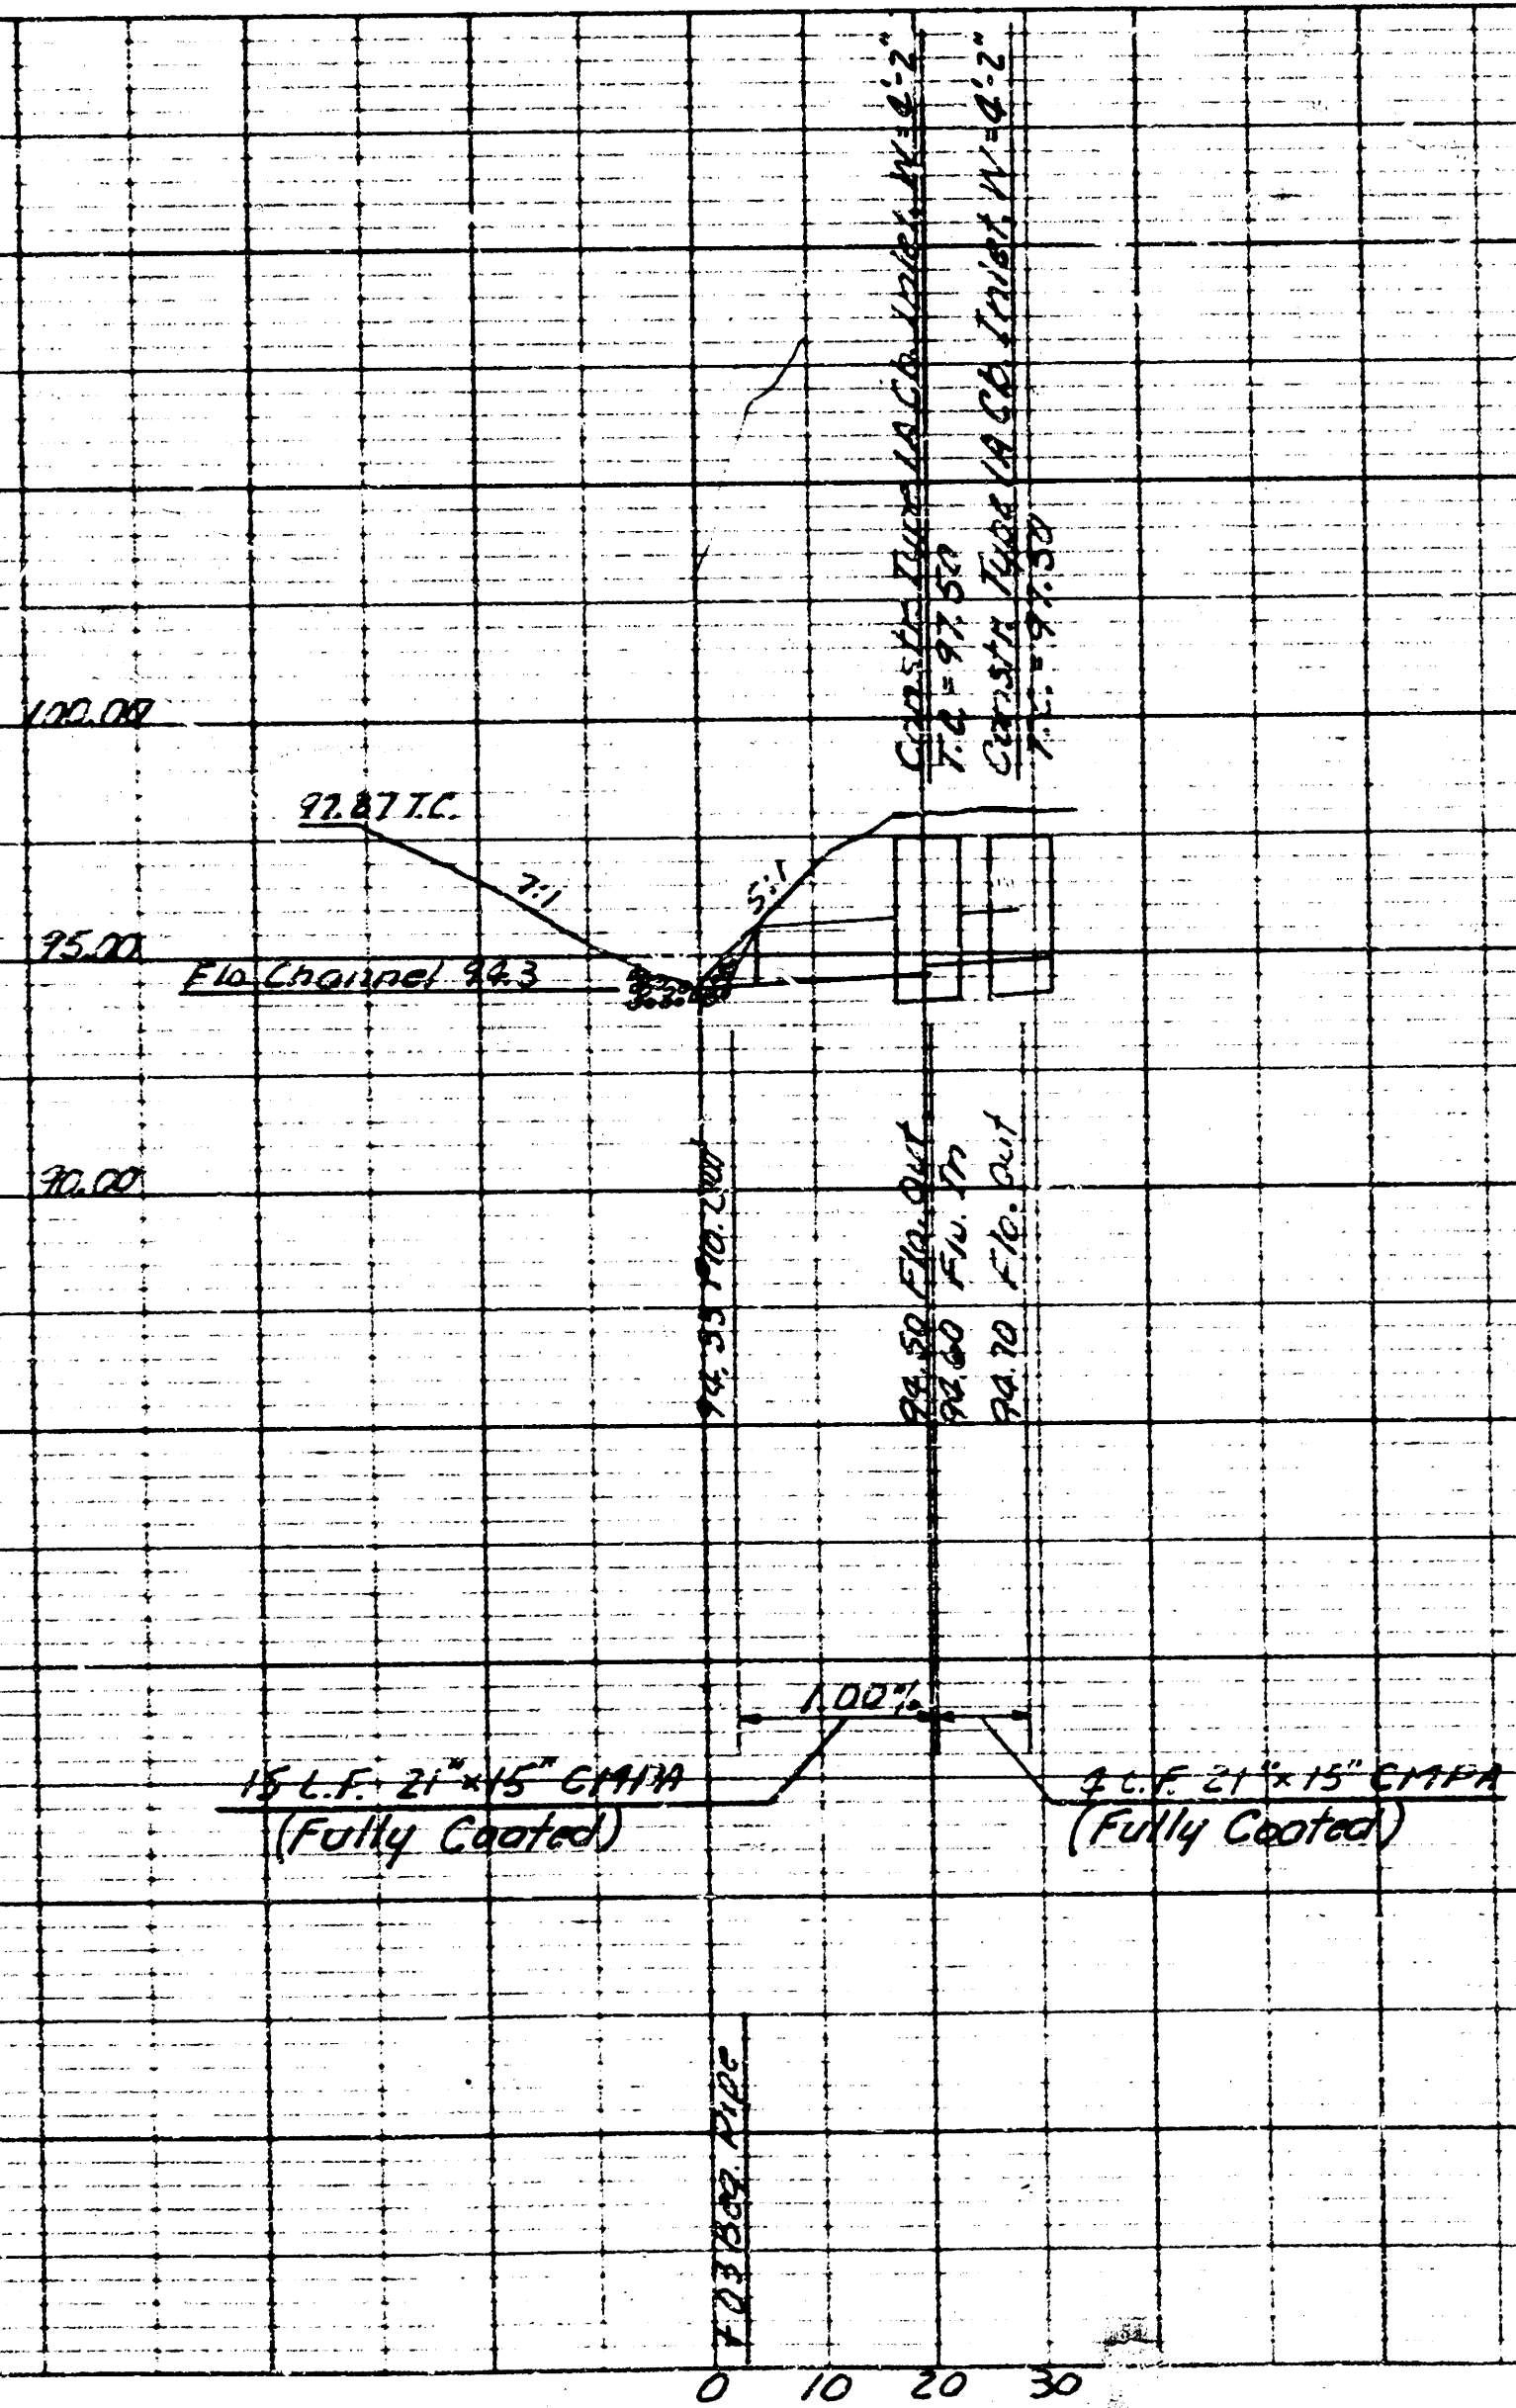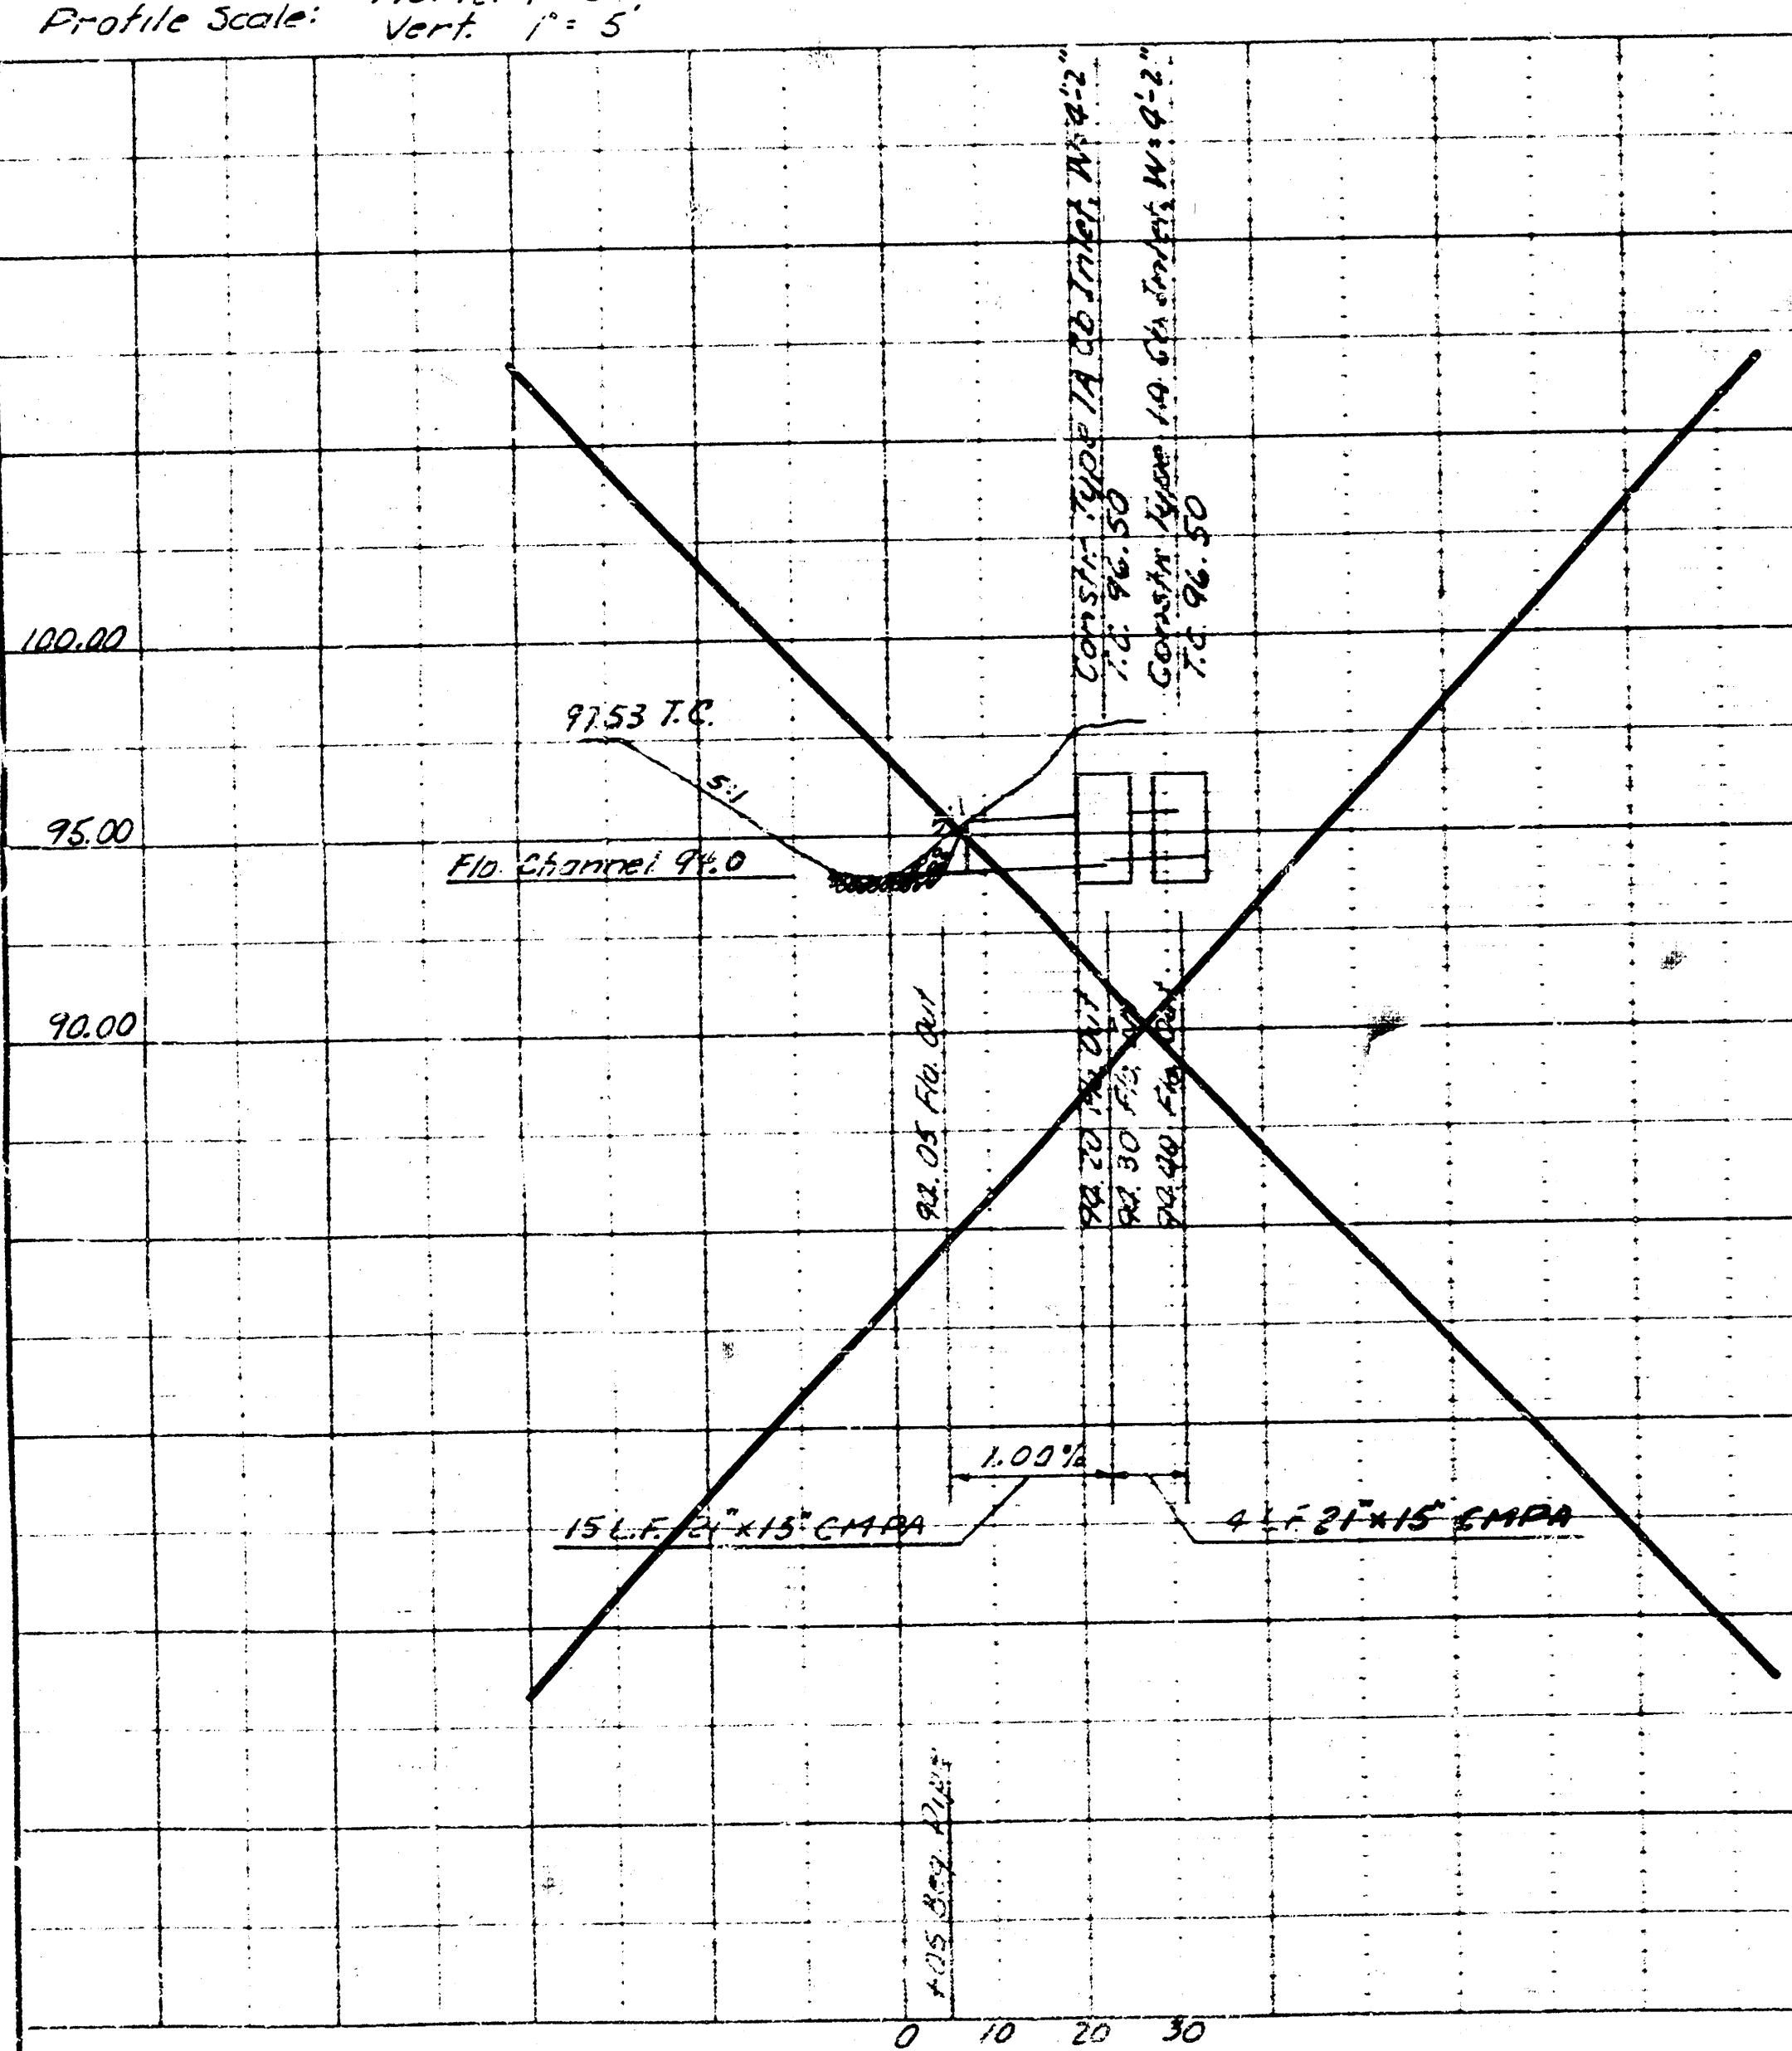

INCIDENTAL DRAINAGE
 IN CONNECTION WITH
 SUNNYBROOK LANE
 CITY OF WICHITA, KANSAS
 R.W. LINN CITY ENGINEER
 DATE
 PROJ. NO. 472 76 245 80841 000 000 002 1/2

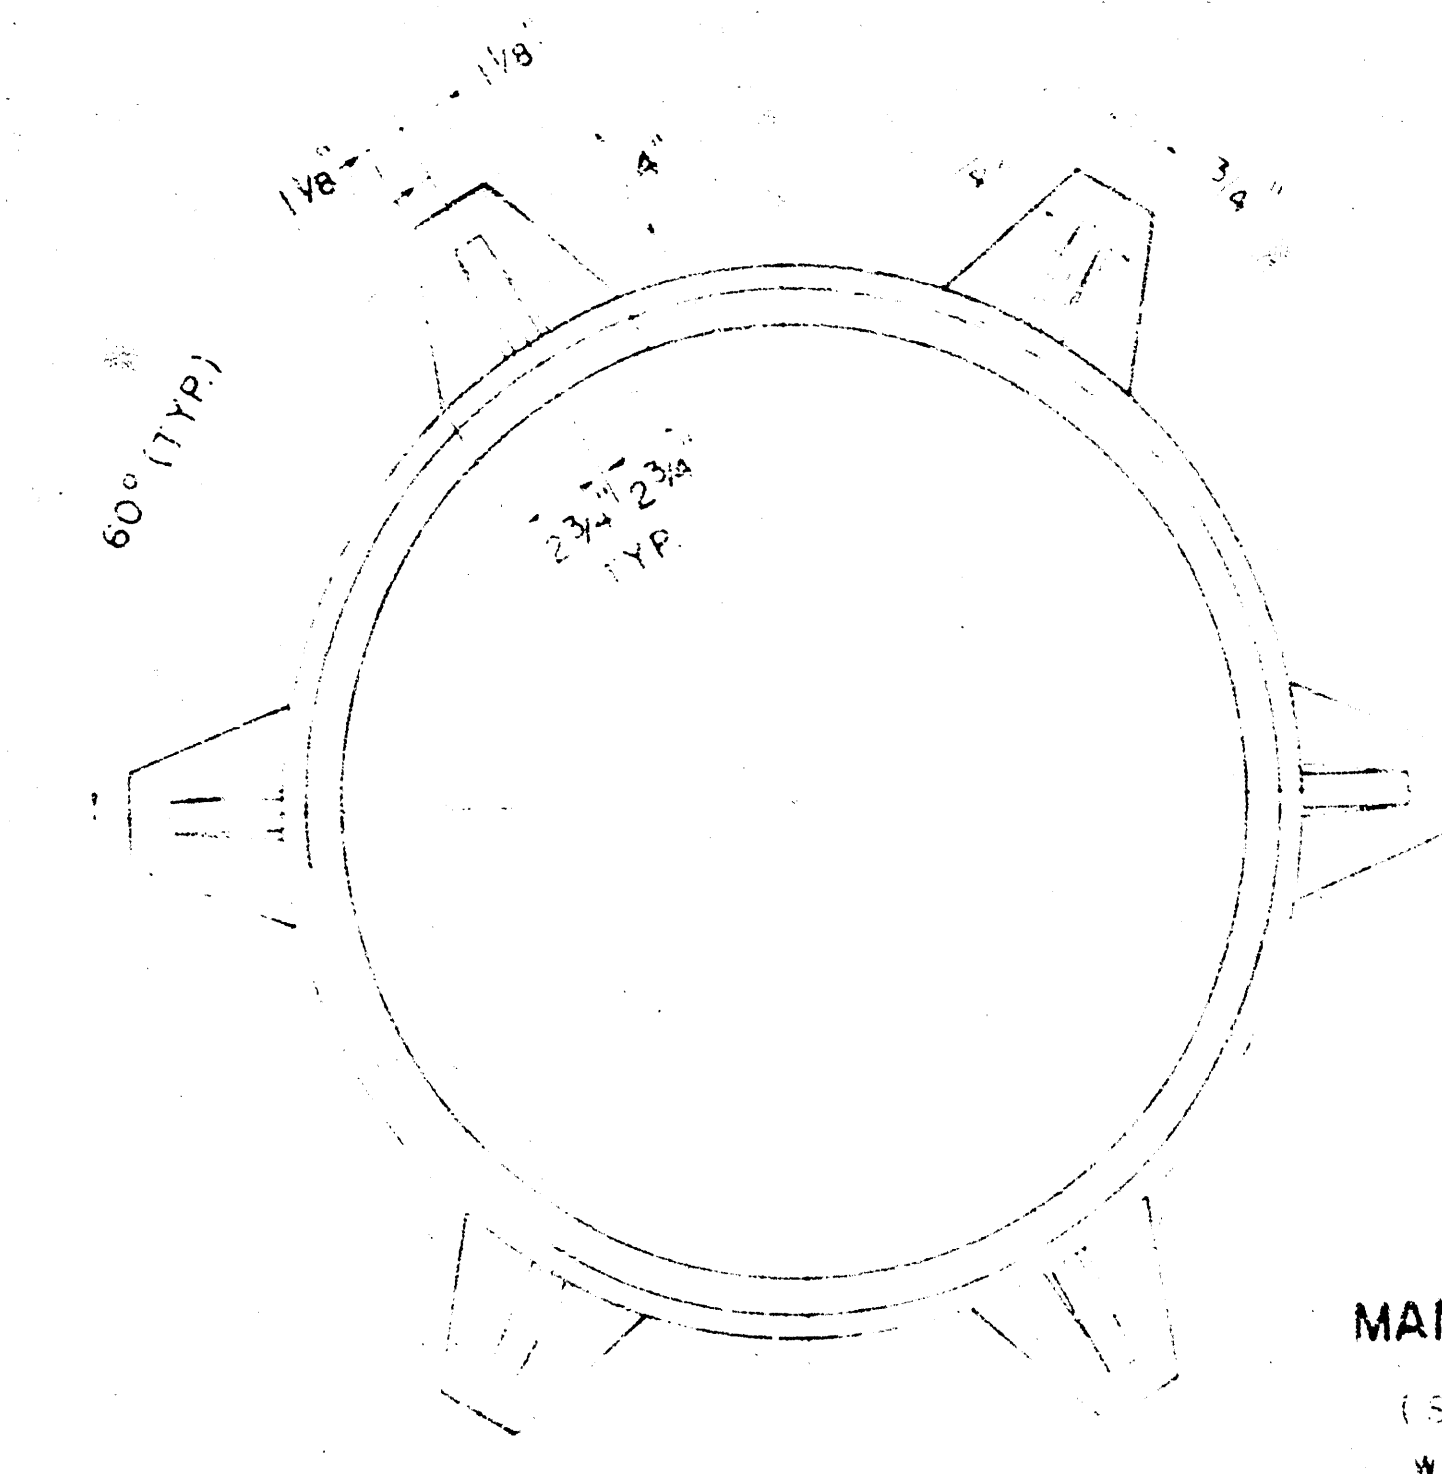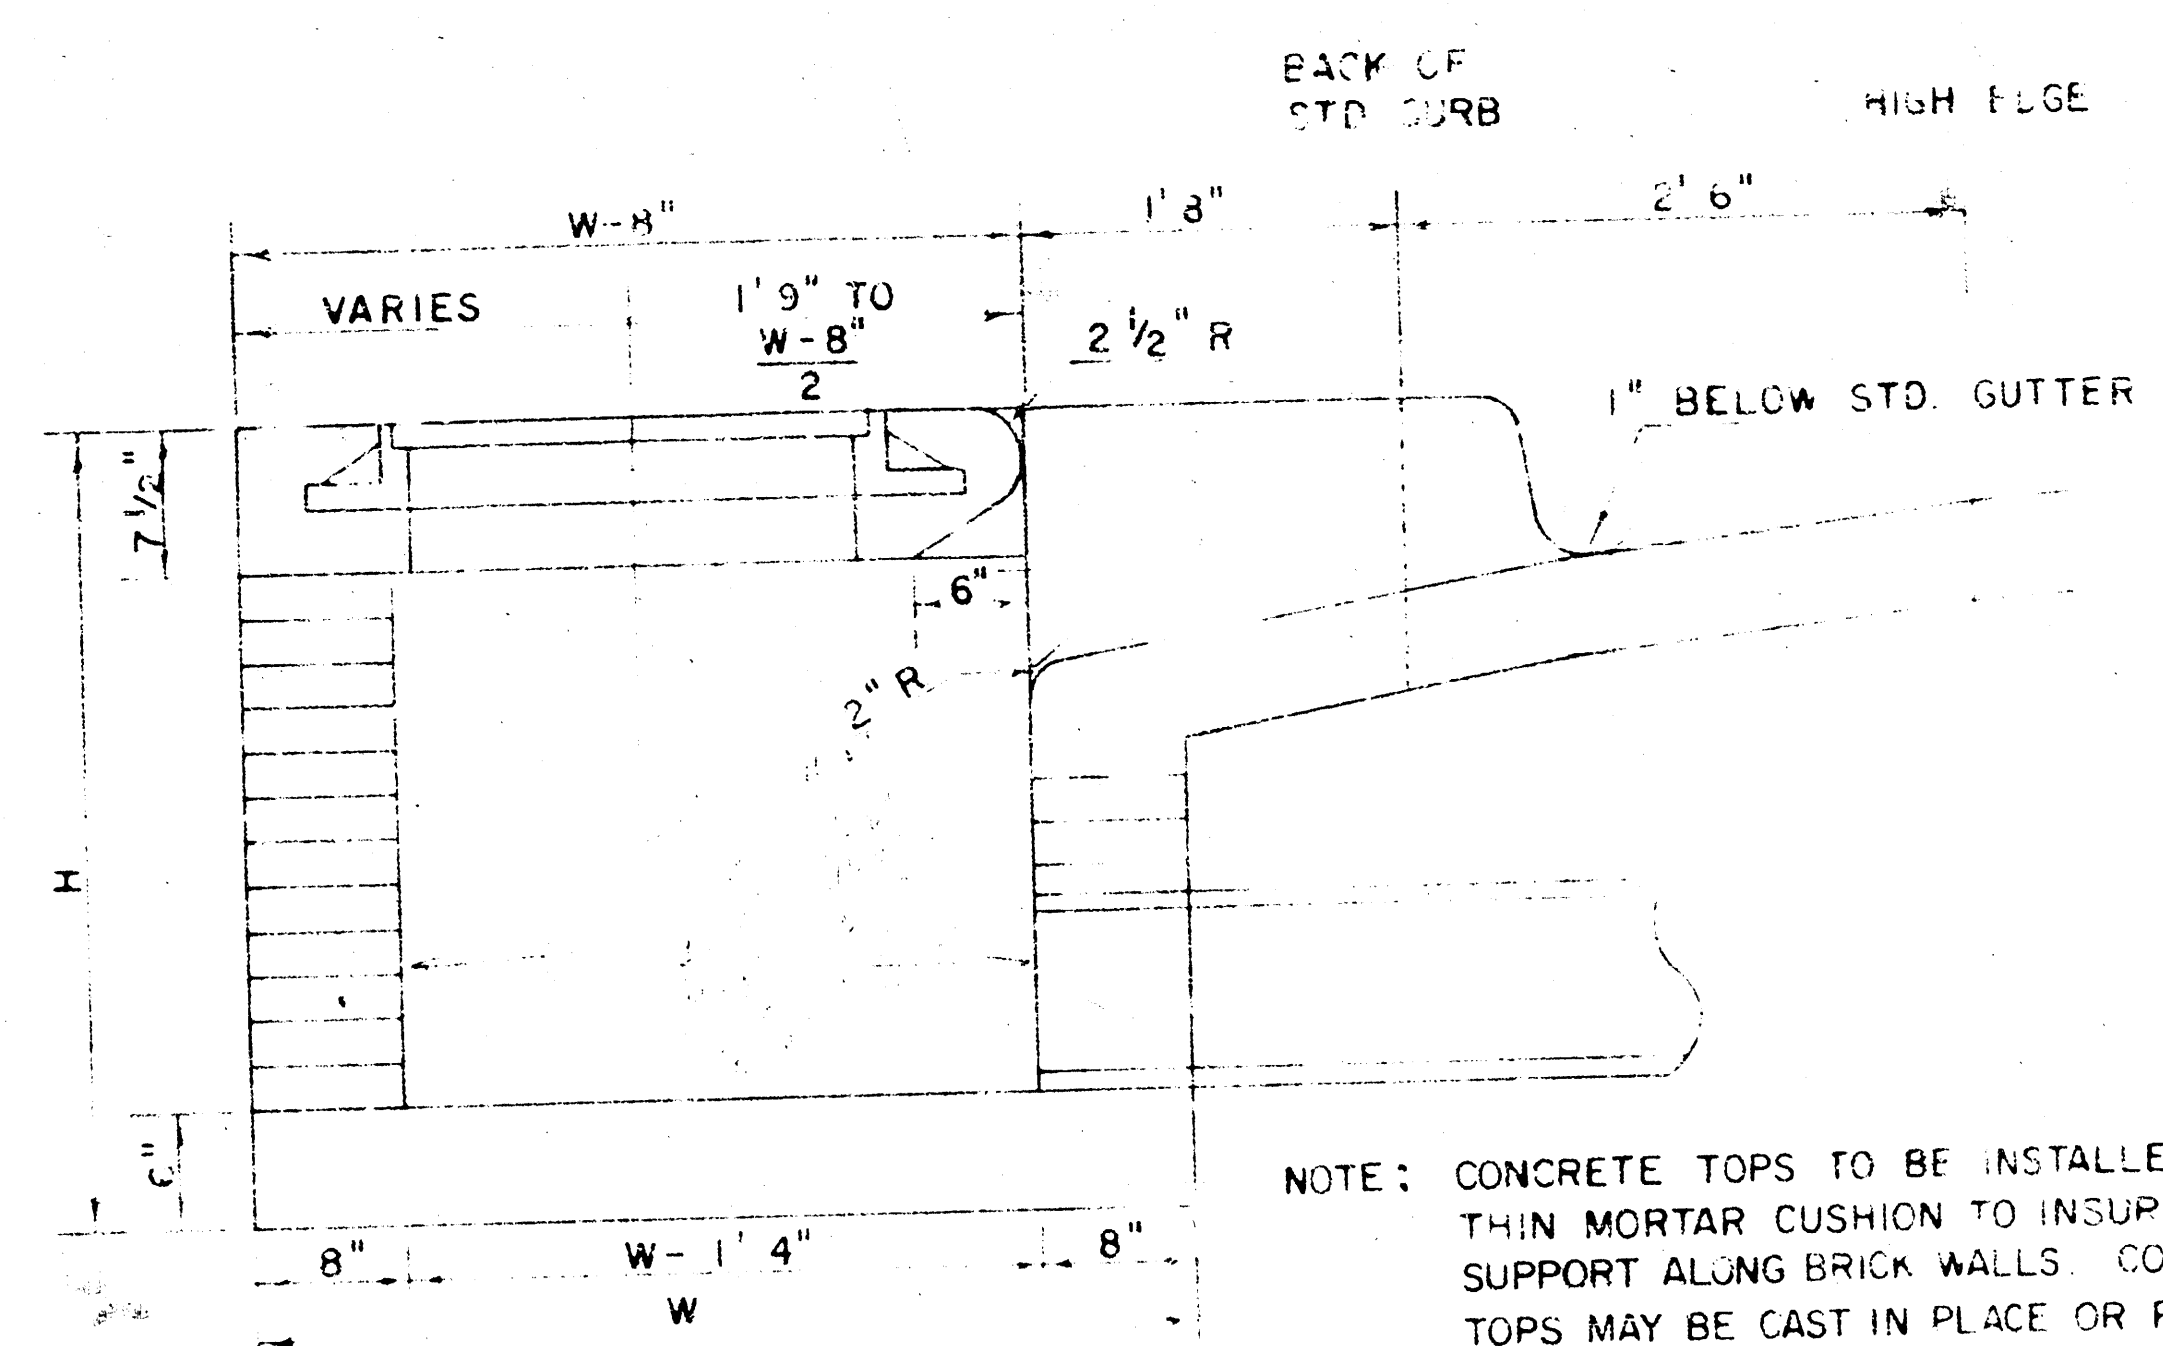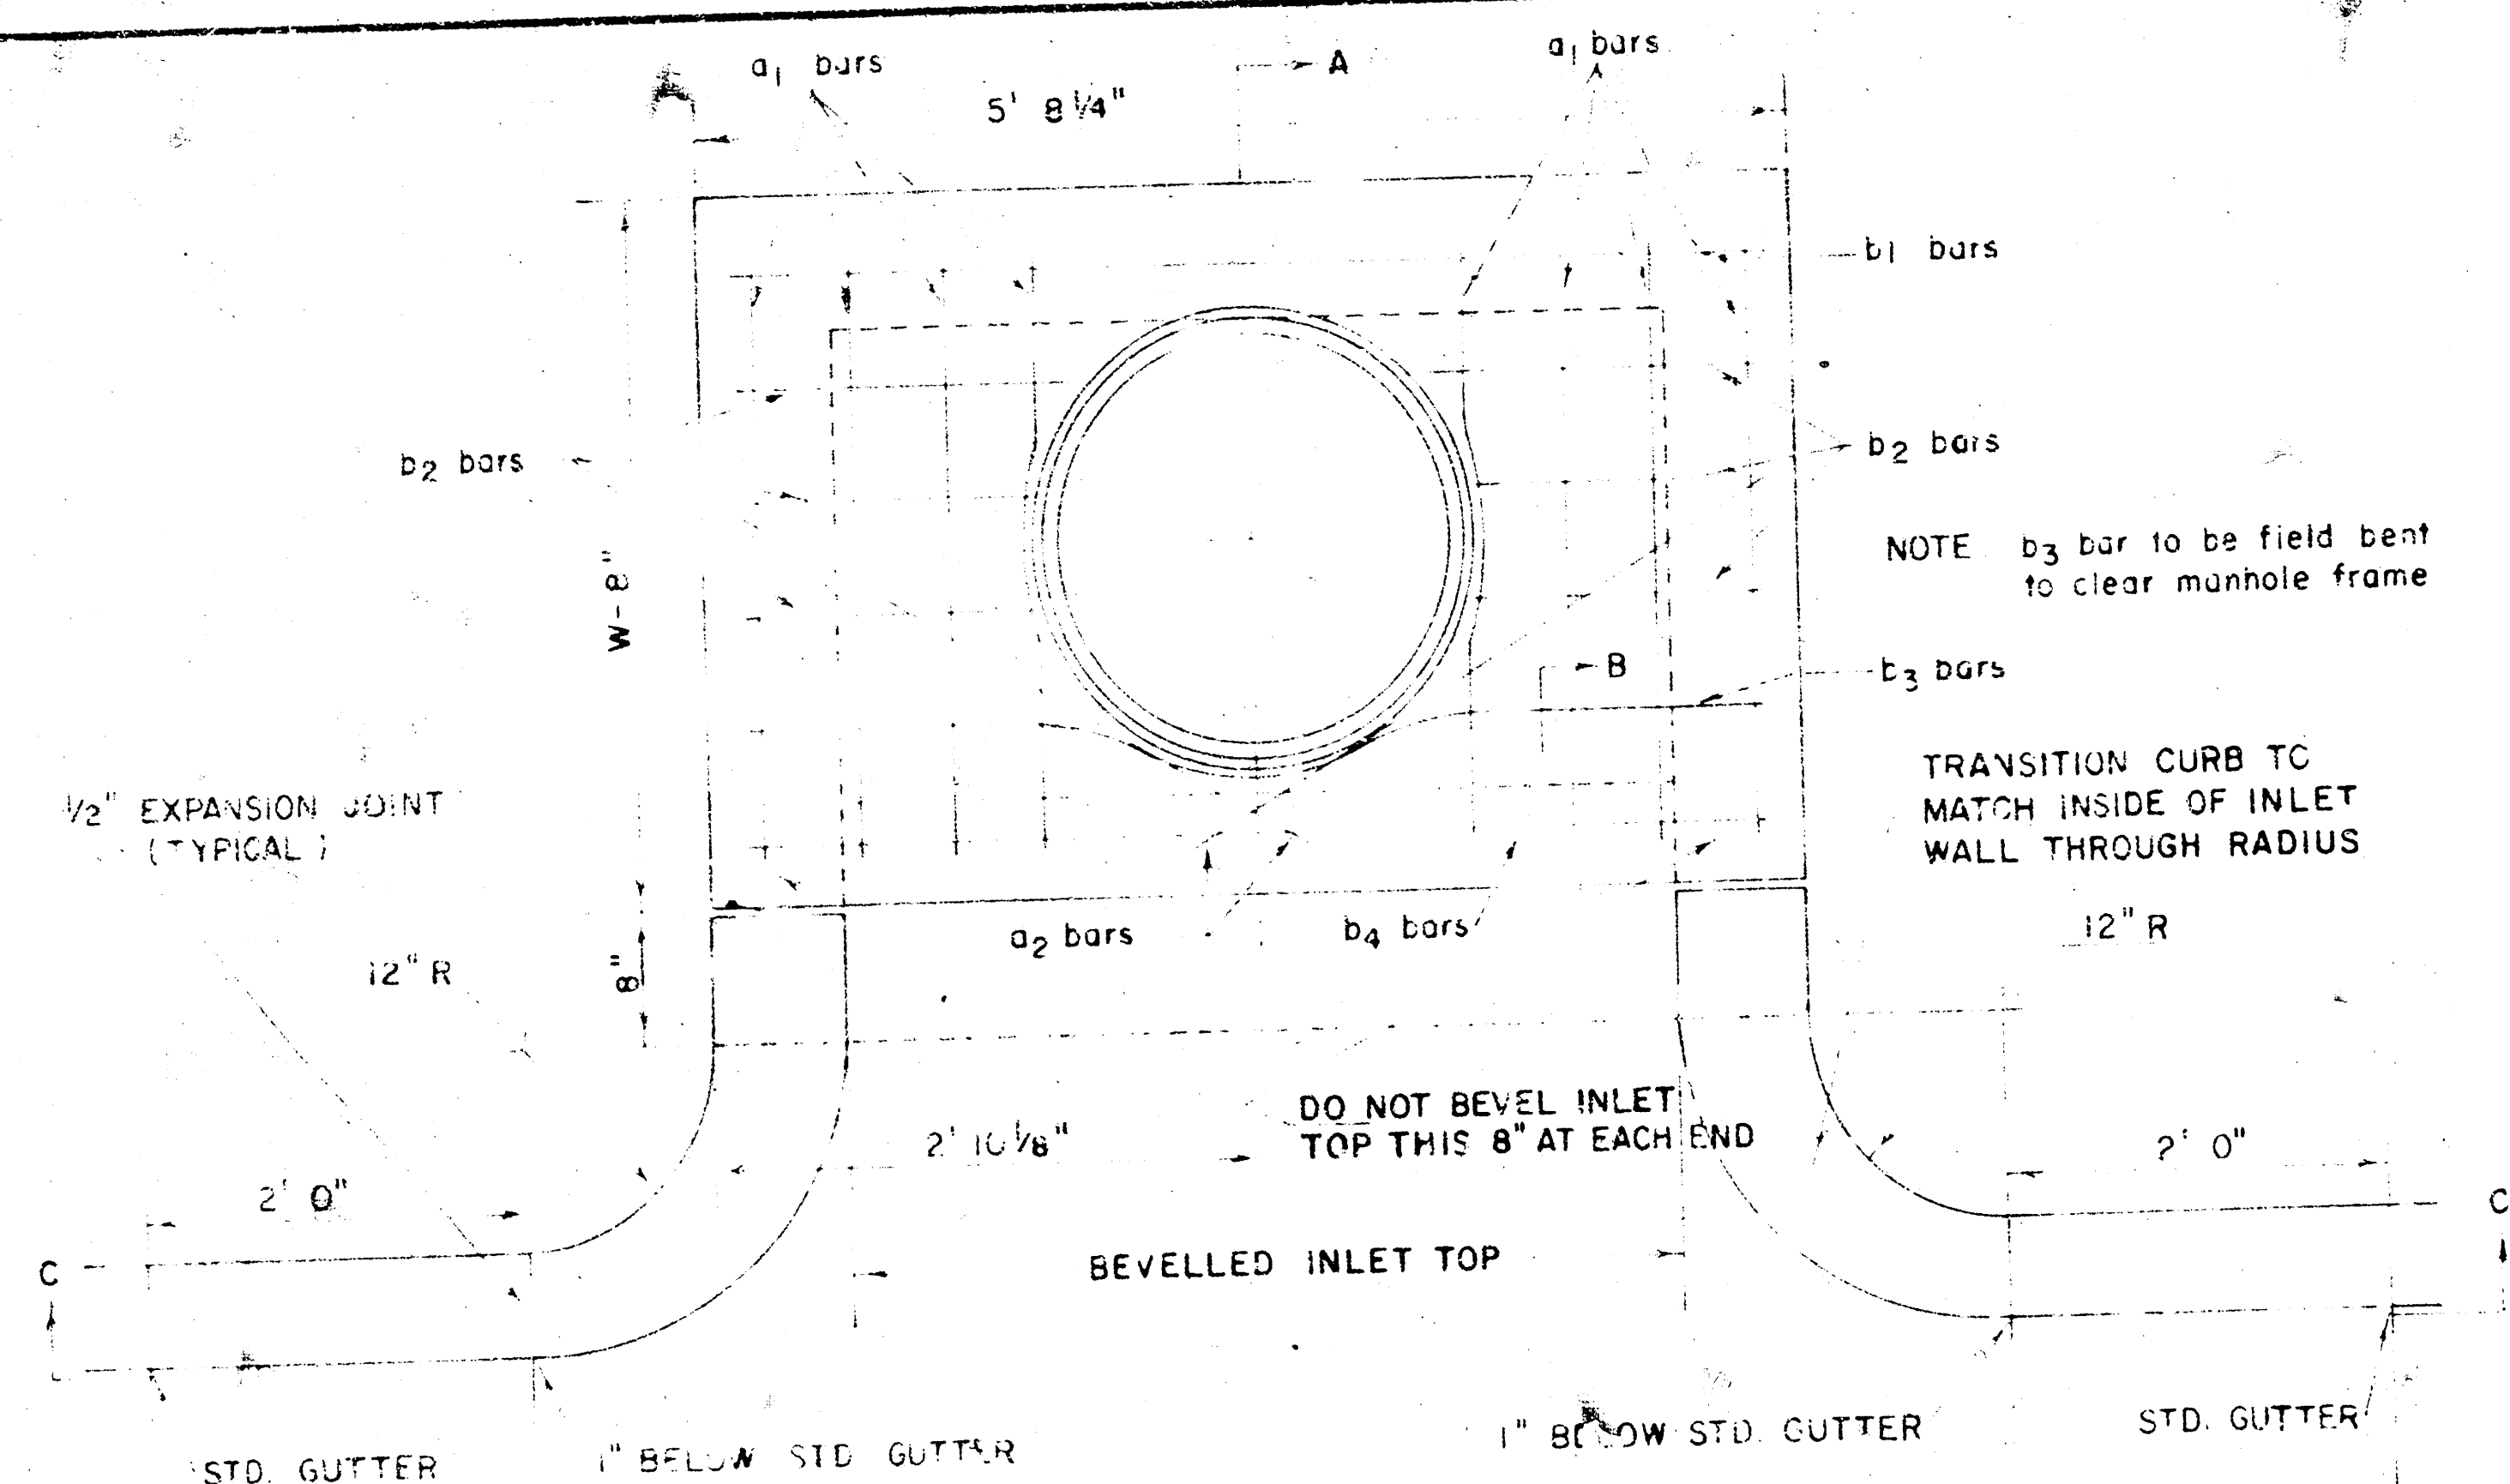

STEEL SCHEDULE





BAR NUMBER	SIZE	W-4'2"	W-5'0"	W-5'6"	W-6'0"	W-6'6"	W-7'0"	W-7'6"	W-8'0"	WT. LBS.

* NOTE: a2 BARS TO BE PLACED APPROX. 2" BELOW TOP OF INLET COVER

STANDARD CURB INLET PRECAST TOPS

W	PRE-CAST TOP SIZE	PIPE SIZE	CU. YD. CONC.
4' 2"	36" x 5' 8 1/4" x 7 1/2"	21" & SMALLER	0.46 *
5' 0"	44" x 5' 8 1/4" x 7 1/2"	24" & 30"	0.57 *
6' 0"	54" x 5' 8 1/4" x 7 1/2"	36" & 42"	0.71 *
7' 0"	64" x 5' 8 1/4" x 7 1/2"	48" & 54"	0.84 *
8' 0"	74" x 5' 8 1/4" x 7 1/2"	60" & 66"	0.97 *

* GROSS VOLUME

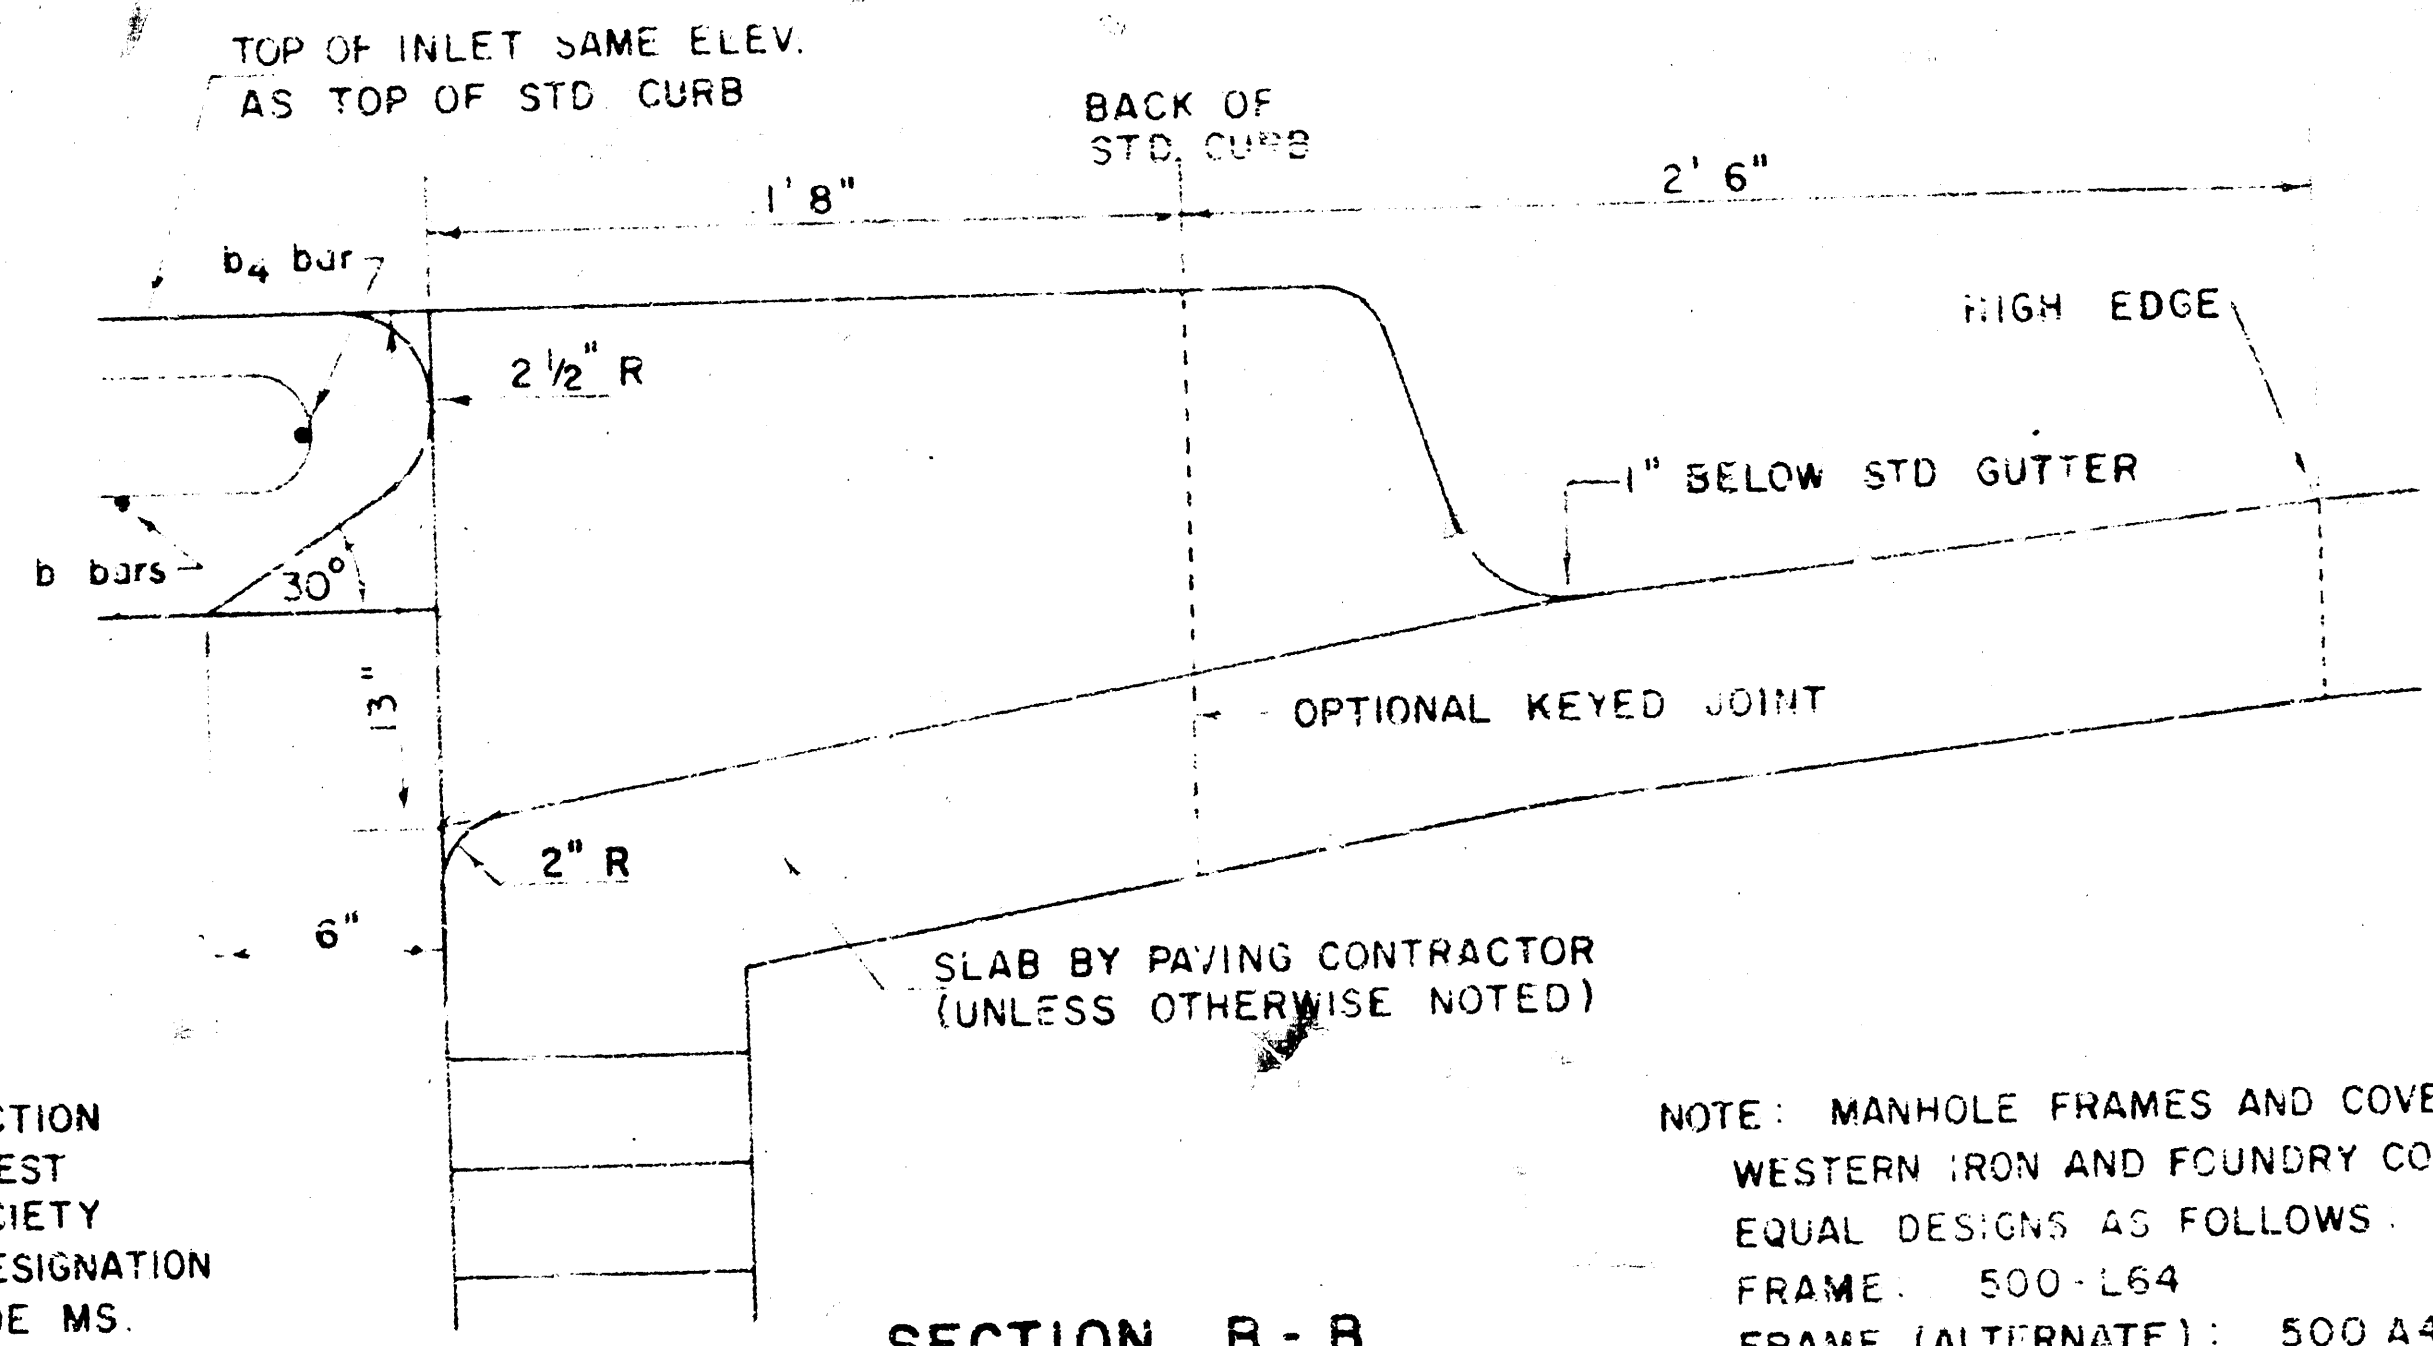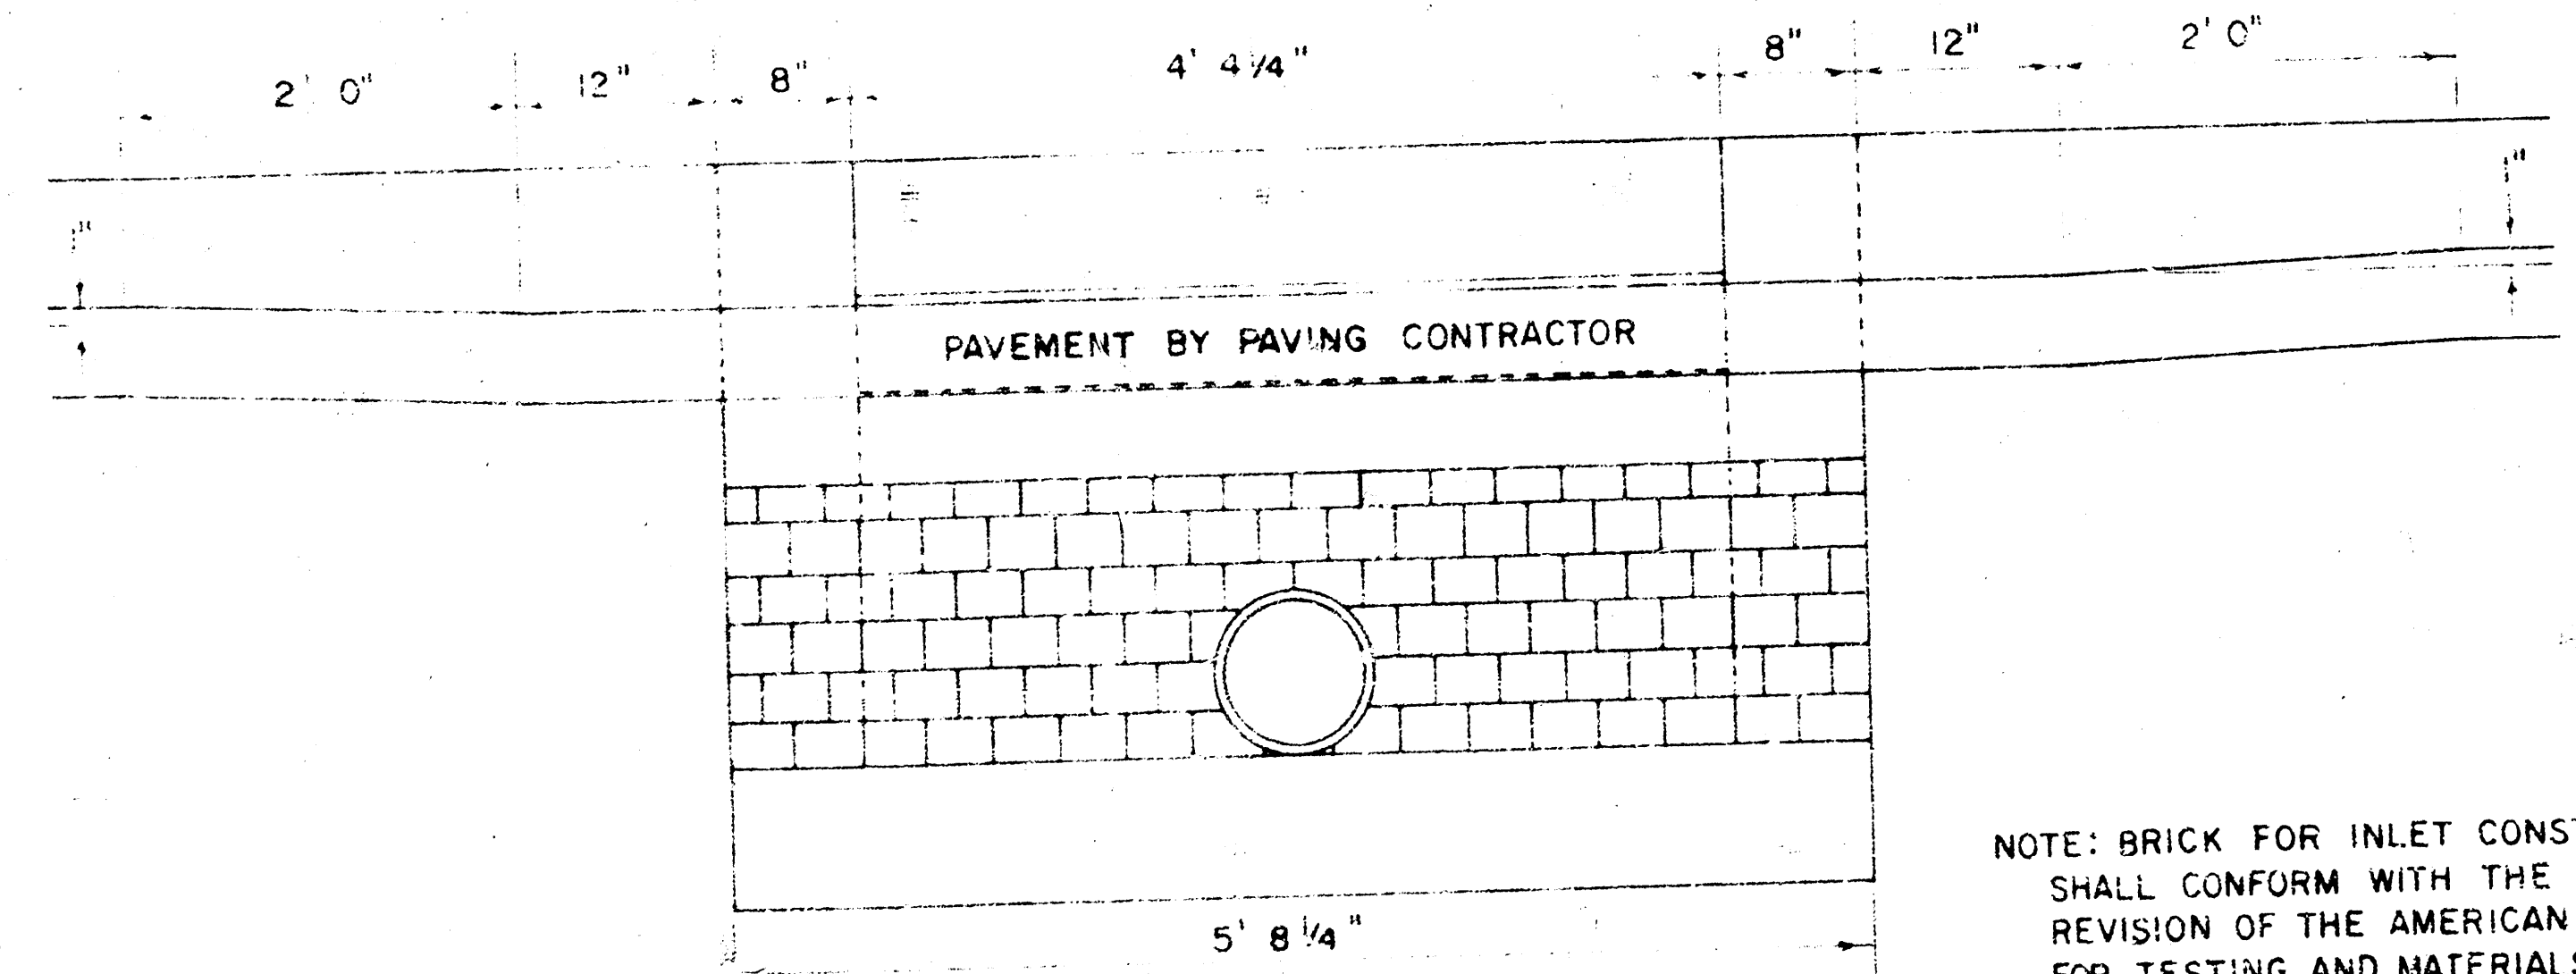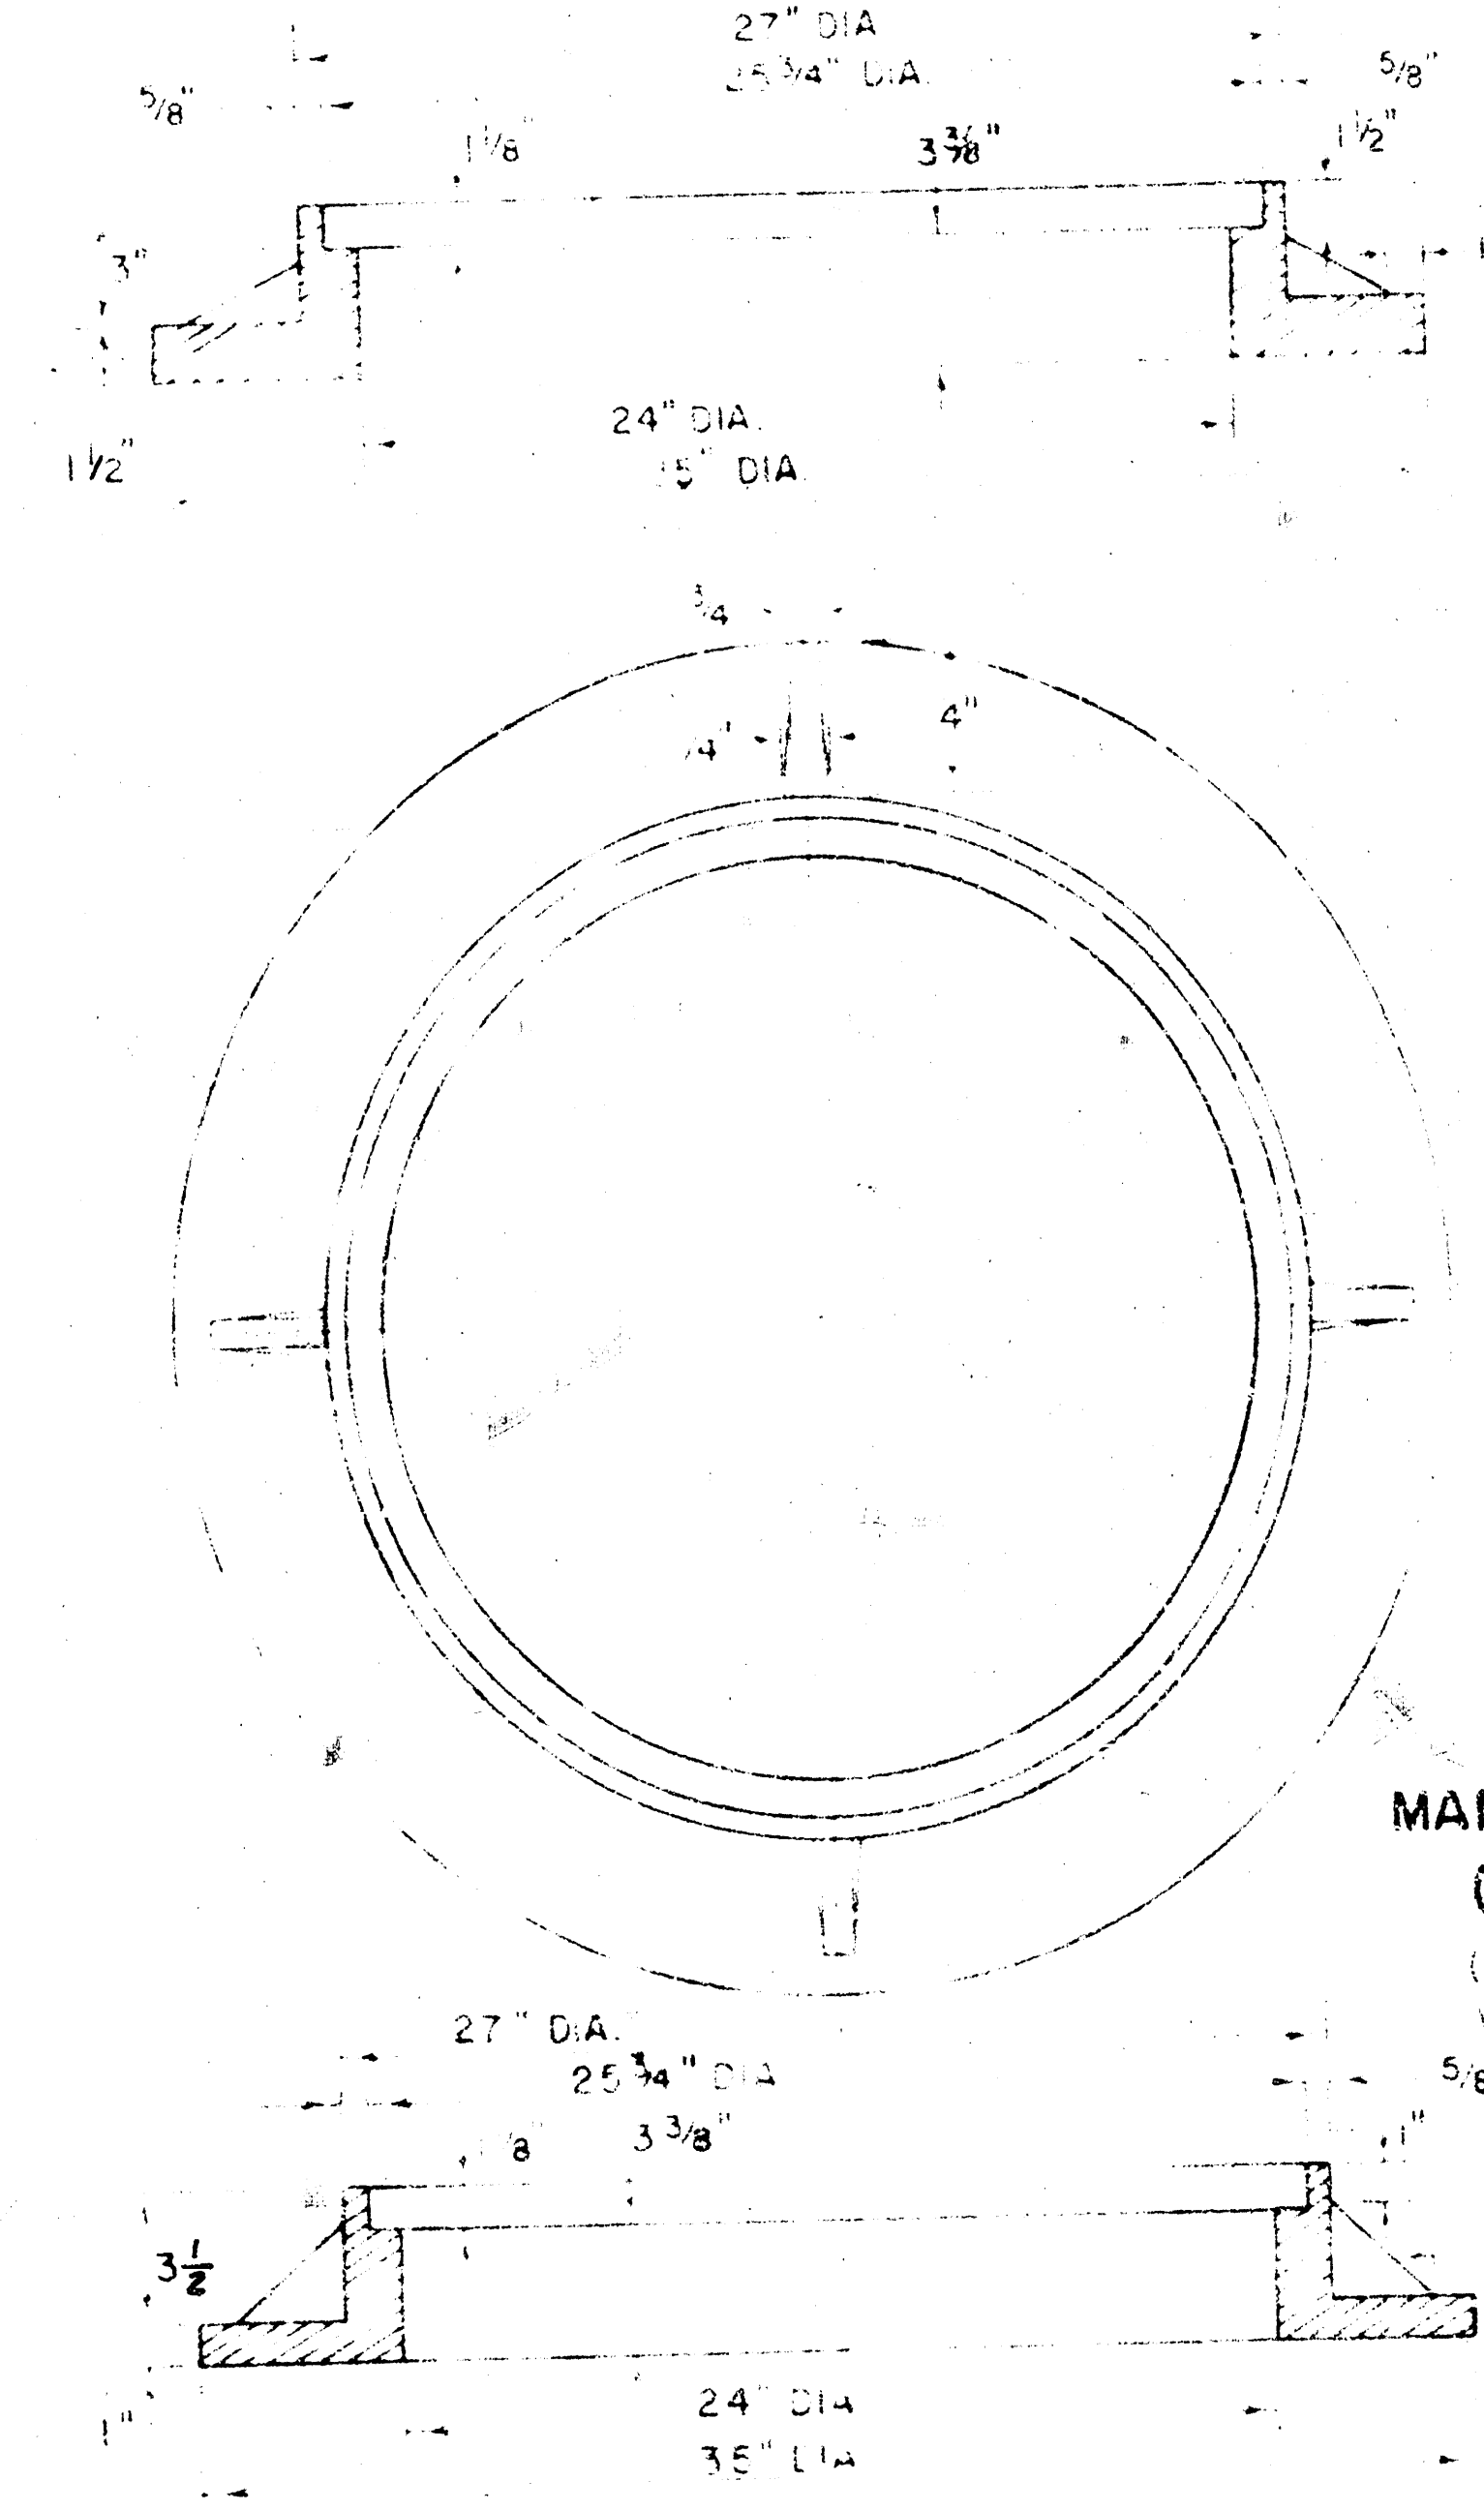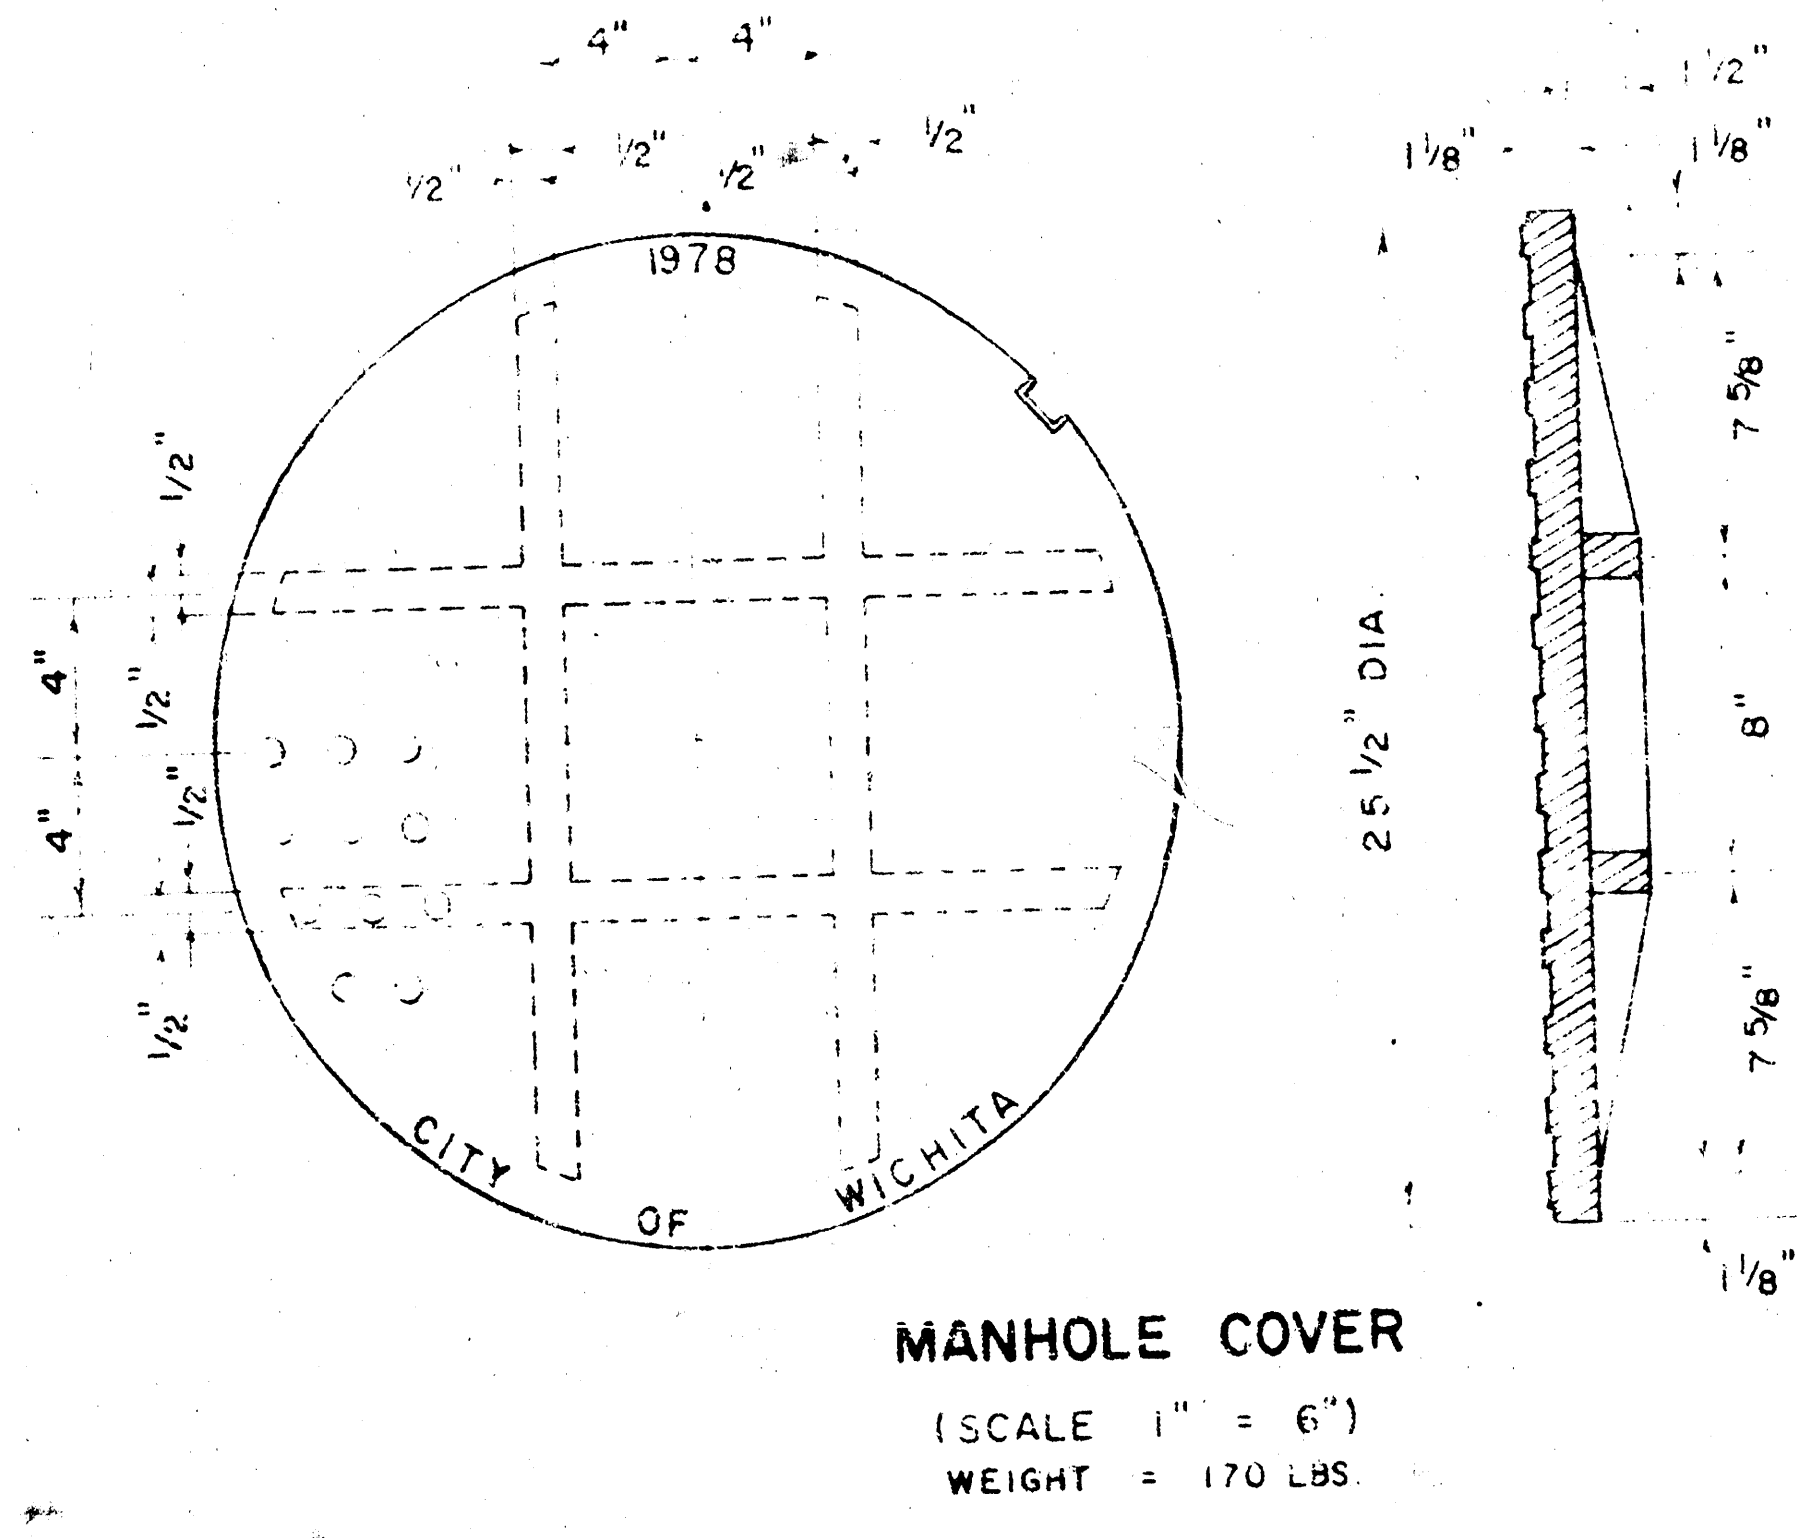

DETAIL STANDARD TYPE IA CURB INLET
CITY OF WICHITA, KANSAS
R. W. LINN - CITY ENGINEER
OCTOBER 1978