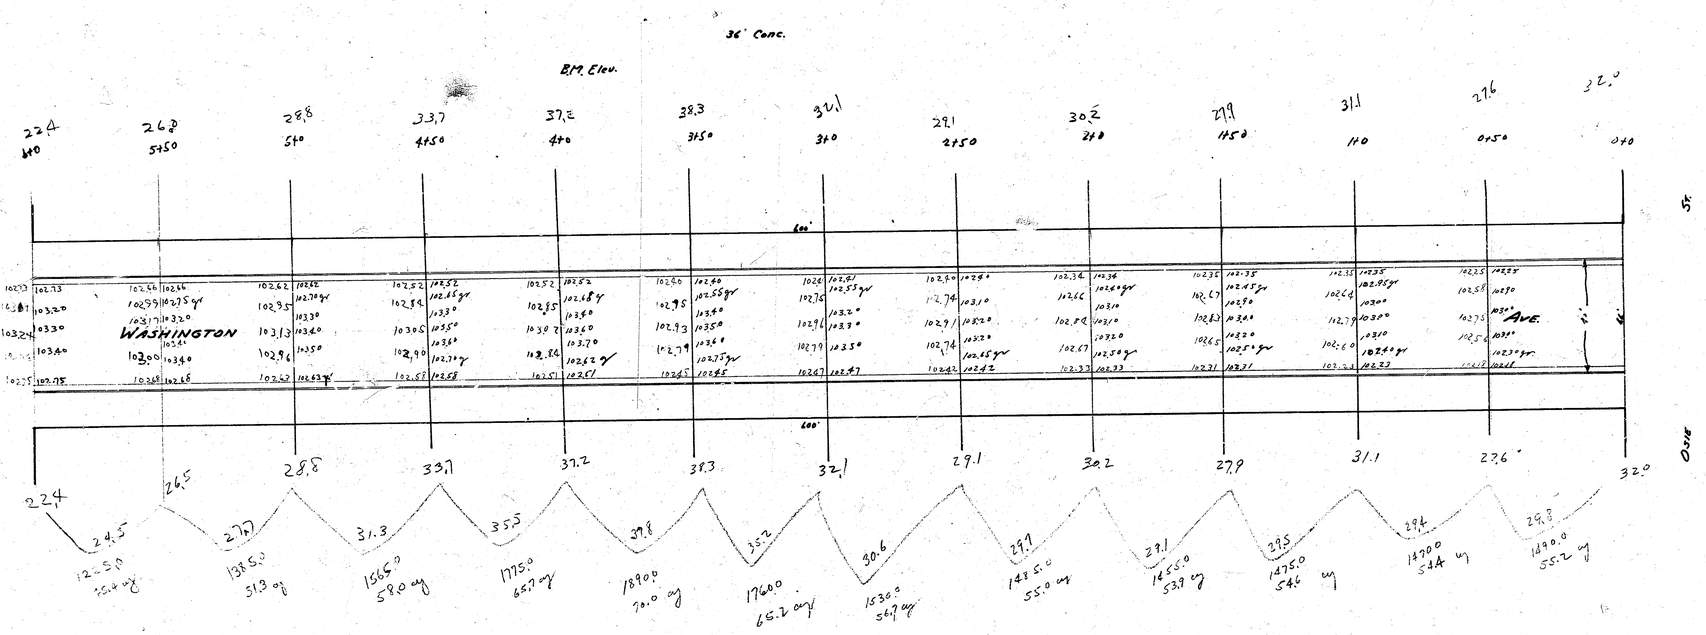

Prog. 685.4 + 68.5 = 753.9 mapped