



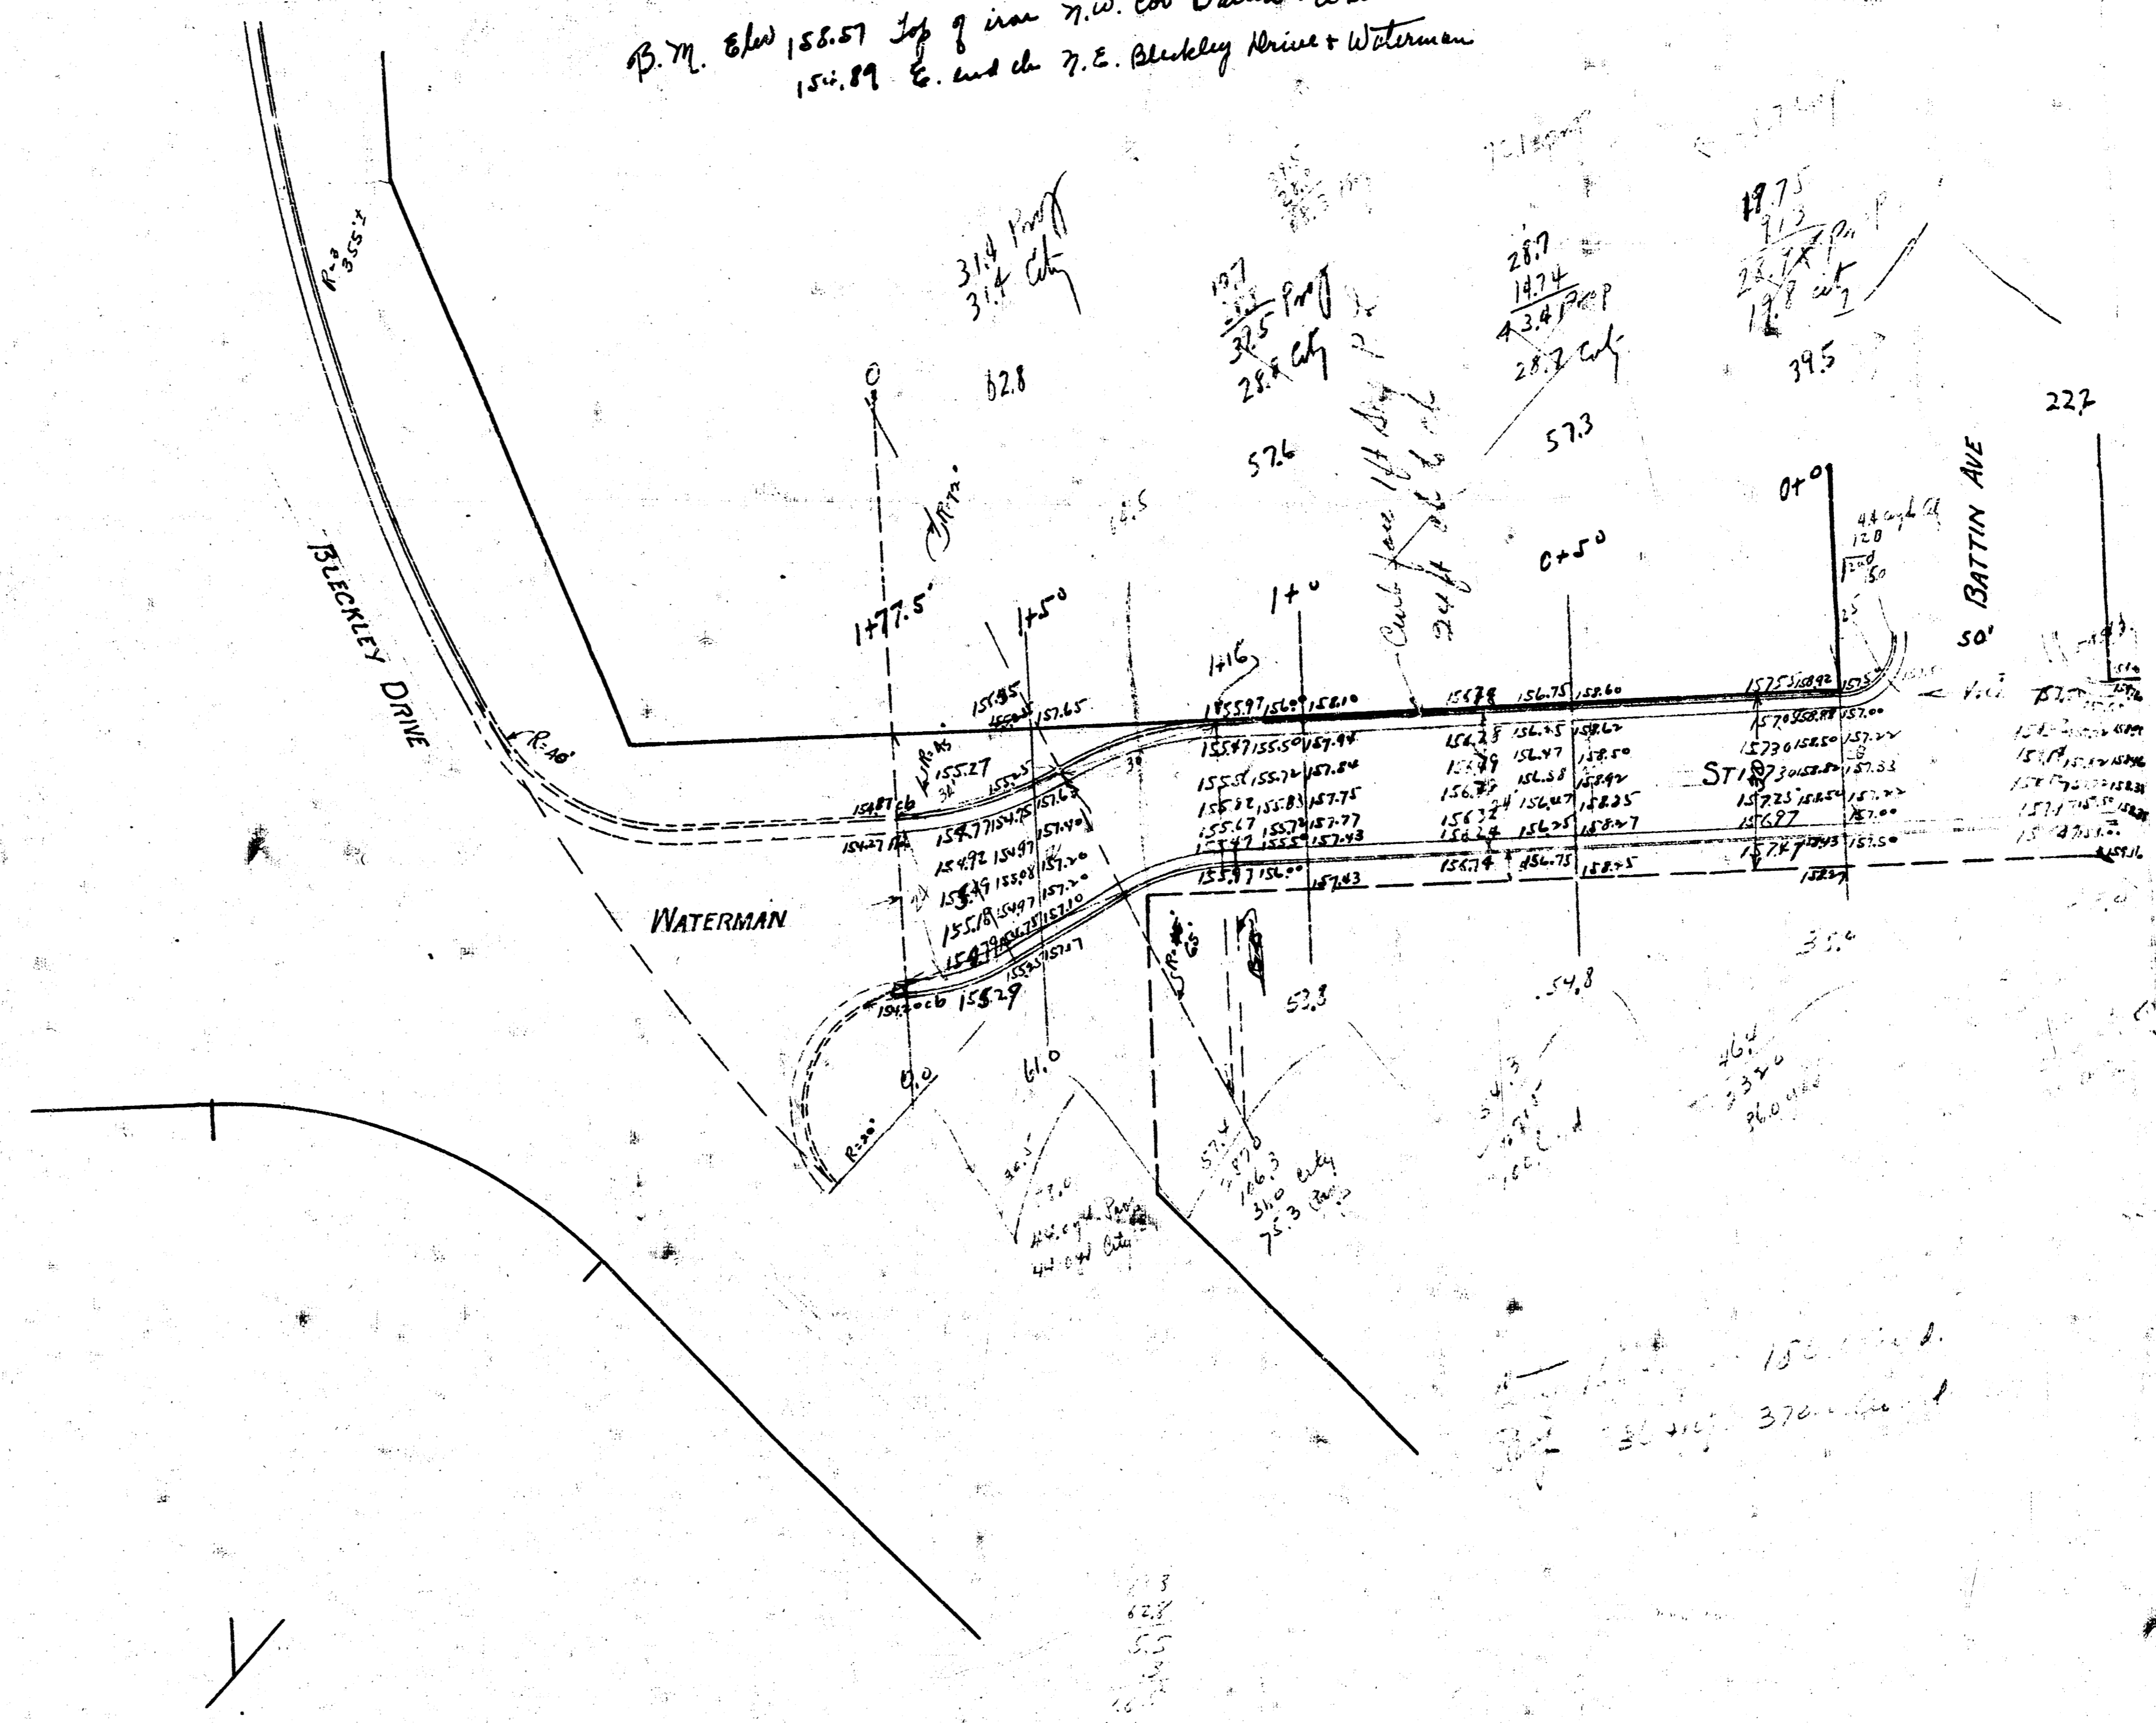

150.89
370.00