Waterman – W.L. Minnesota

36-2-40
Concrete

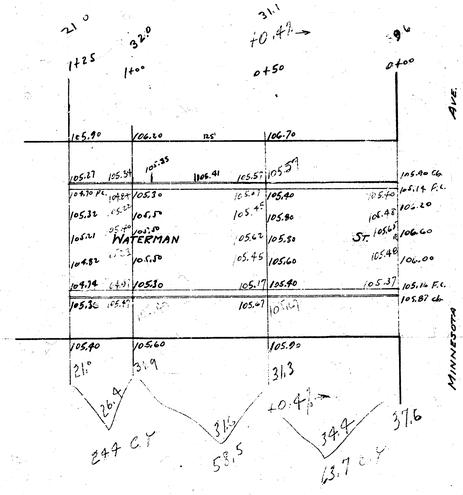

Bal. 176.5
Pay 15
161.2