
Waterman – W.L. Minnesota

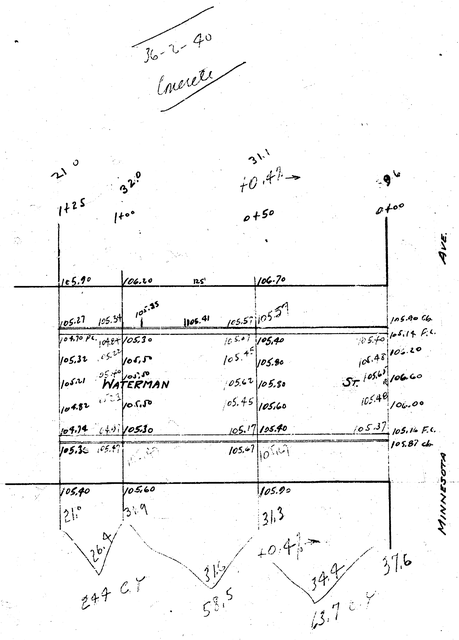

1765
105
1670