

H-7


B.M. 115.15 NW Cor. Conc Porch 4 Plex SE Cor. Rumsey & Kansas

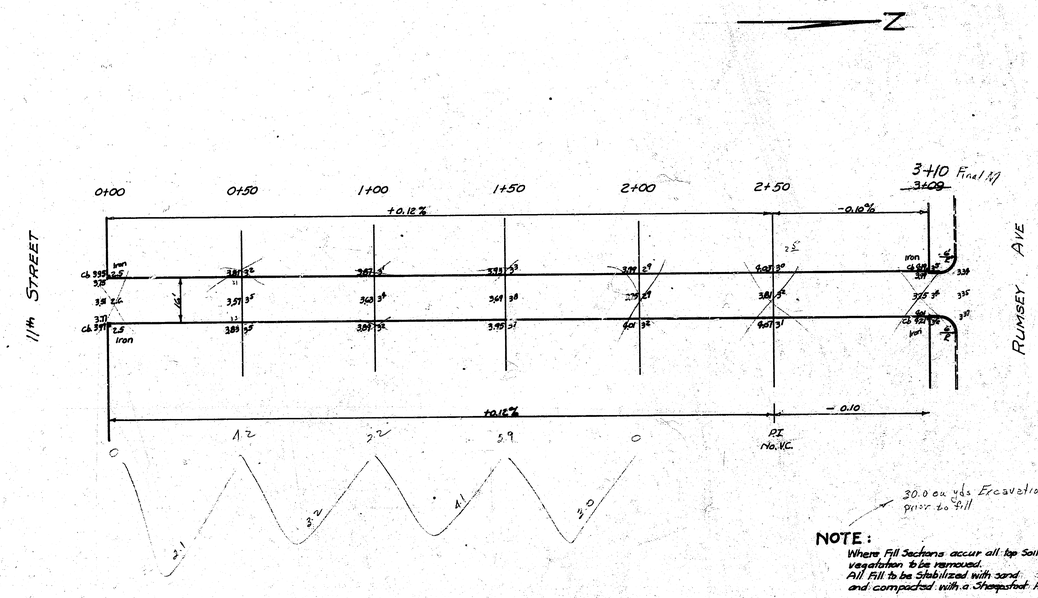

NOTE:
Where Fill Sections occur all top Soil and vegetation to be removed.
All Fill to be Stabilized with sand and compacted with a Sheepsfoot Roller

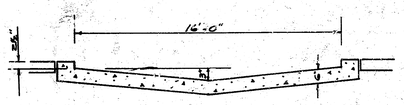

Section on Property Line
No Scale

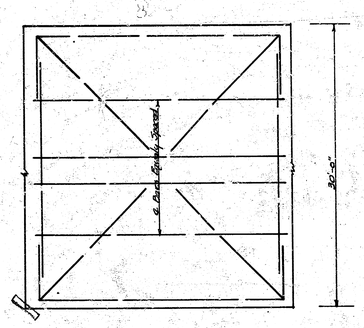

Steel Pattern

WELLS PLACE
N.L. 11th to SL. RUMSEY
16'-6" Conc.
City of WICHITA, KANSAS
L.K. White City Engineer
Nov. 1950 Private Job.

4 7 1 S8