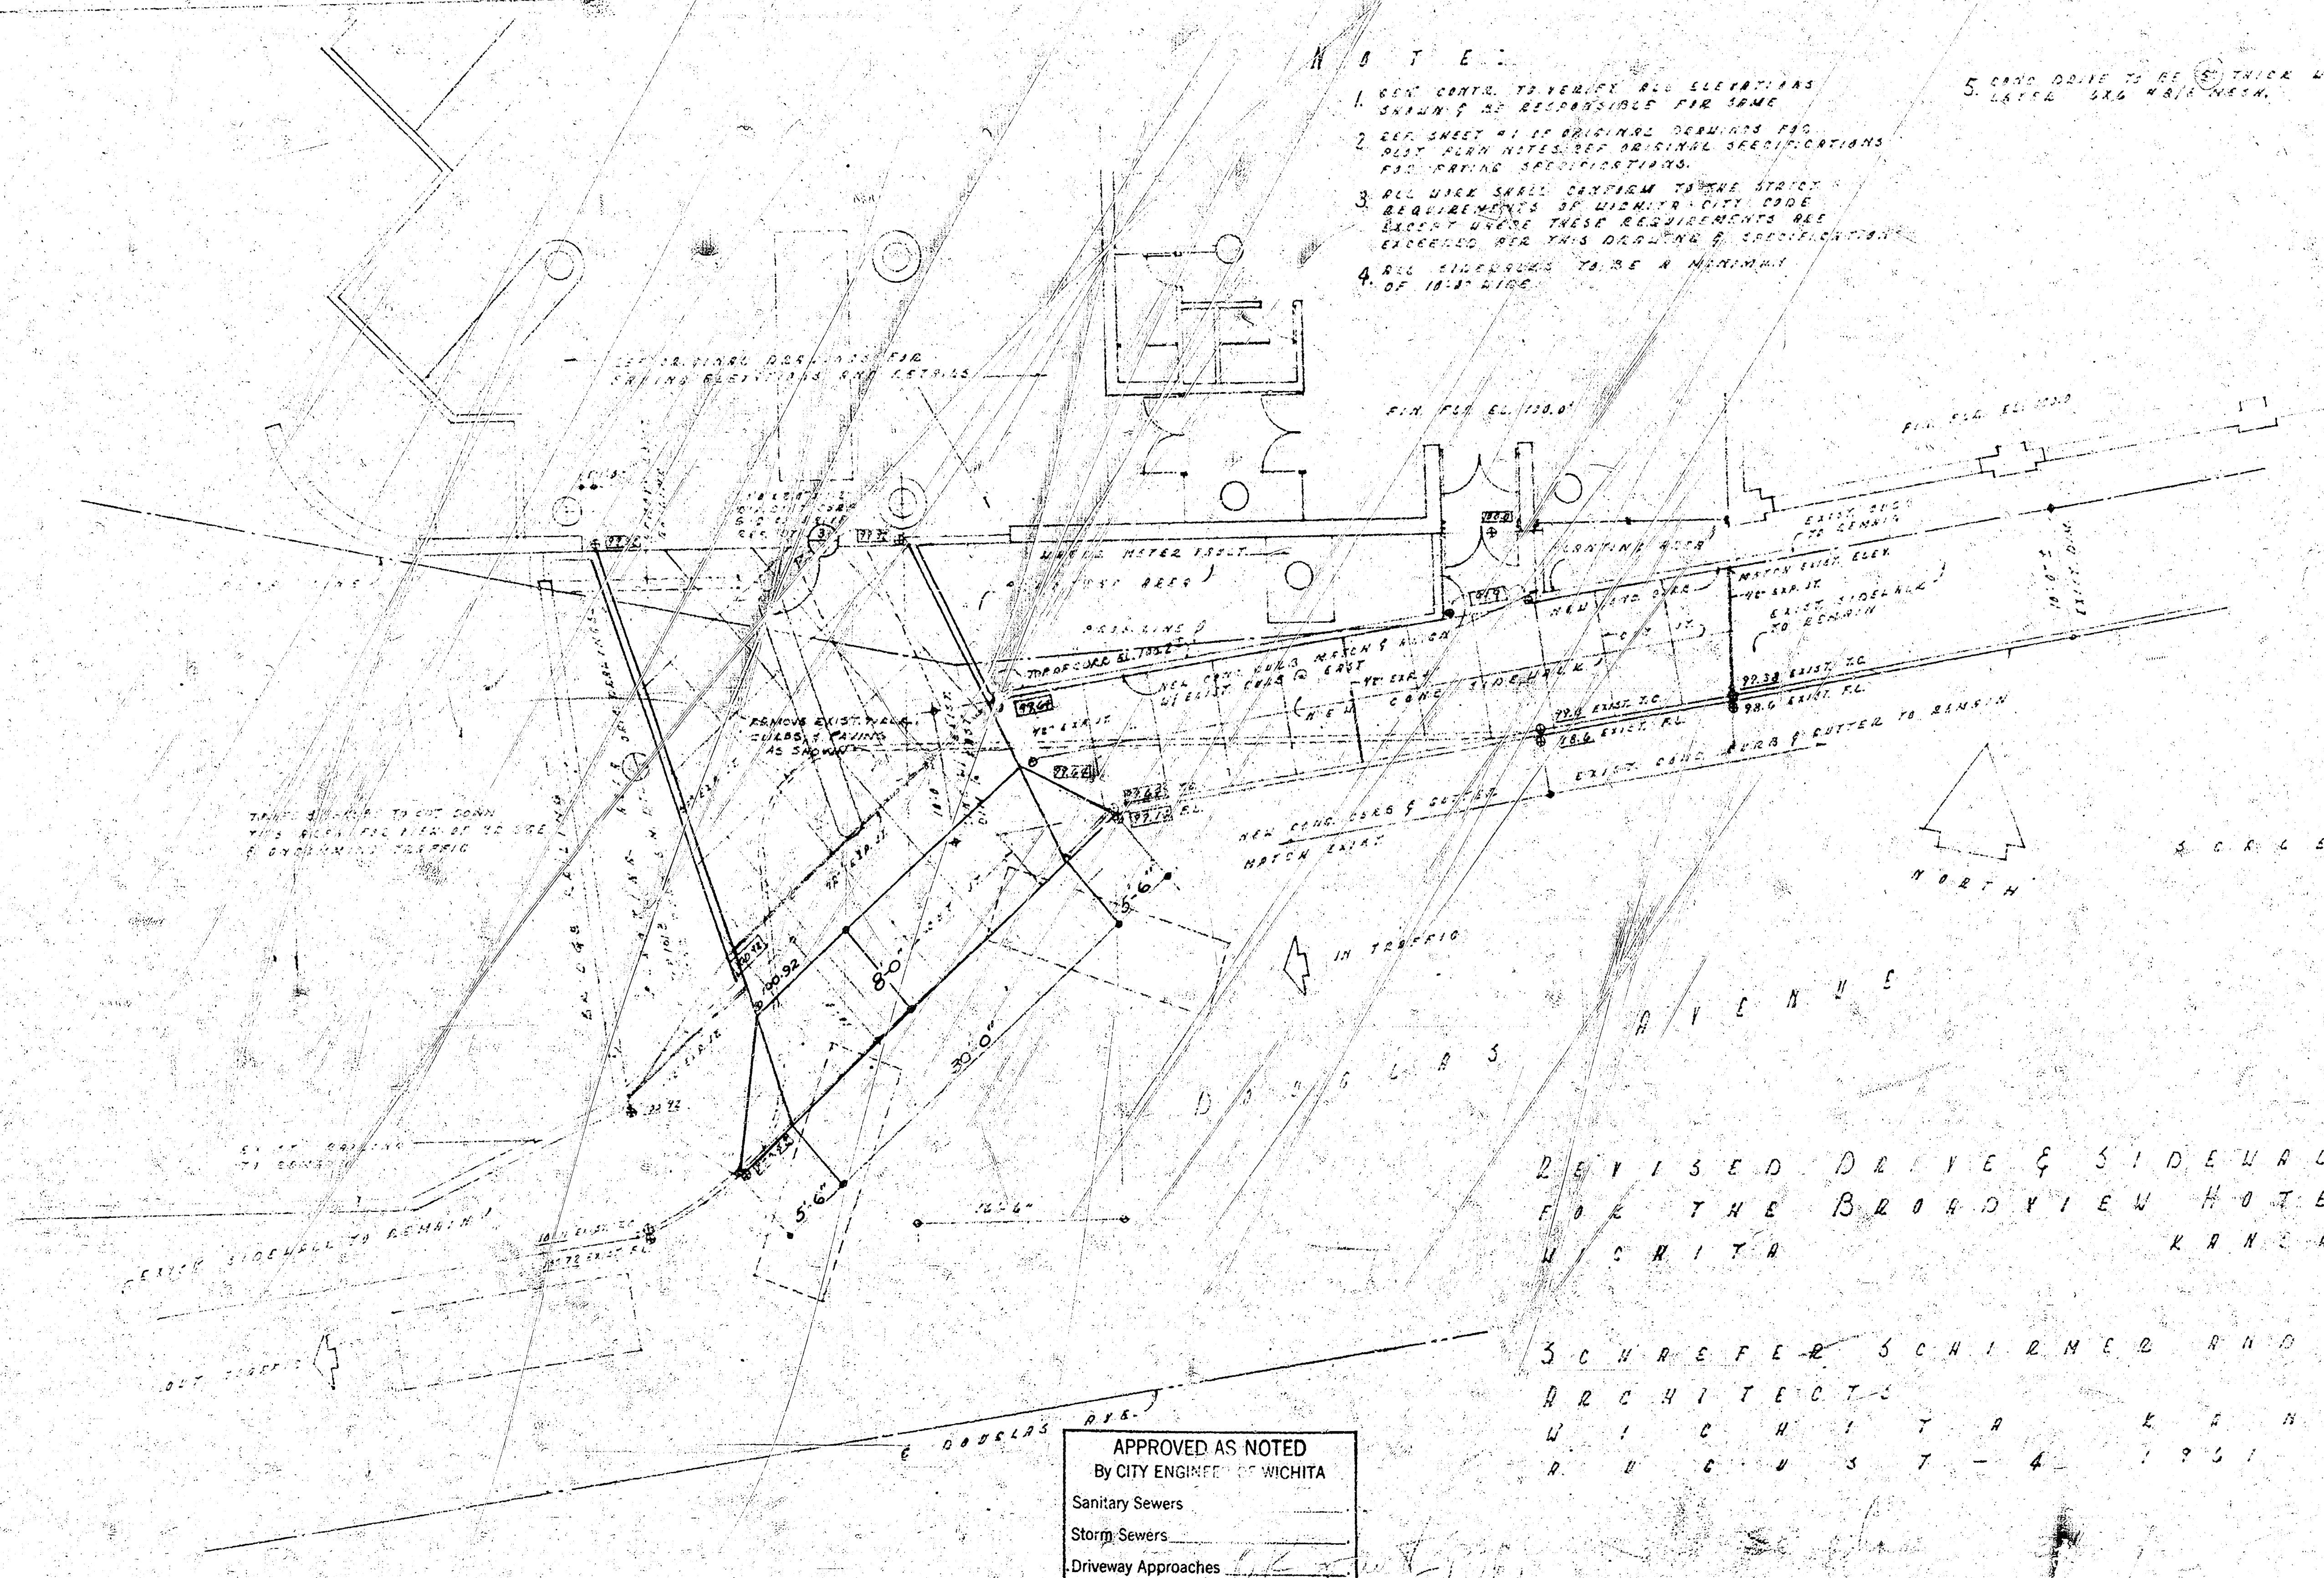
FIN. FLR. EL. 130.0'
DOUGLAS AVENUE
IN TRAFFIC
NORTH
SCALE 1/8" = 1'-0"
EXIST. SIDEWALK TO REMAIN
E. DOUGLAS AVE.

NOTE:

1. GEN. CONTR. TO VERIFY ALL ELEVATIONS SHOWN & BE RESPONSIBLE FOR SAME
2. REF. SHEET #1 OF ORIGINAL DRAWINGS FOR PLOT PLAN NOTES. REF. ORIGINAL SPECIFICATIONS FOR PAVING SPECIFICATIONS.
3. ALL WORK SHALL CONFORM TO THE STRICT REQUIREMENTS OF WICHITA CITY CODE EXCEPT WHERE THESE REQUIREMENTS ARE EXCEEDED PER THIS DRAWING & SPECIFICATION.
4. ALL SIDEWALKS TO BE A MINIMUM OF 10'-0" WIDE.
5. CONC. DRIVE TO BE 5" THICK WITH ONE LAYER 6X6 WIRE MESH.

REVISED DRIVE & SIDEWALK LAYOUT
FOR THE BROADVIEW HOTEL
WICHITA KANSAS JOB #224

SCHAEFER SCHIRMER AND EFLIN
ARCHITECTS A I A
WICHITA KANSAS
AUGUST 4 1961

APPROVED AS NOTED
By CITY ENGINEER OF WICHITA
Sanitary Sewers
Storm Sewers
Driveway Approaches
8/7/61