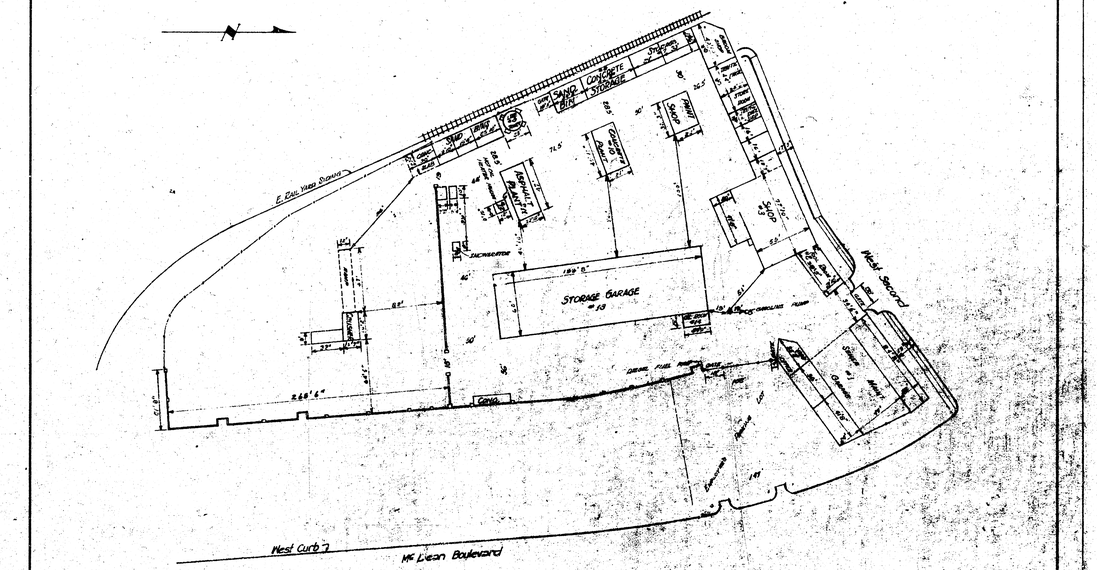


CITY MATERIAL YARD
WICHITA, KANSAS

Survey & Map by J.T. Reeves
JULY, 1948

Scale - 1" = 50'

Revised 3-23-53 LB