


N.E. 1/4 SEC. 26 TWP. 27 R.1.E.

11-55

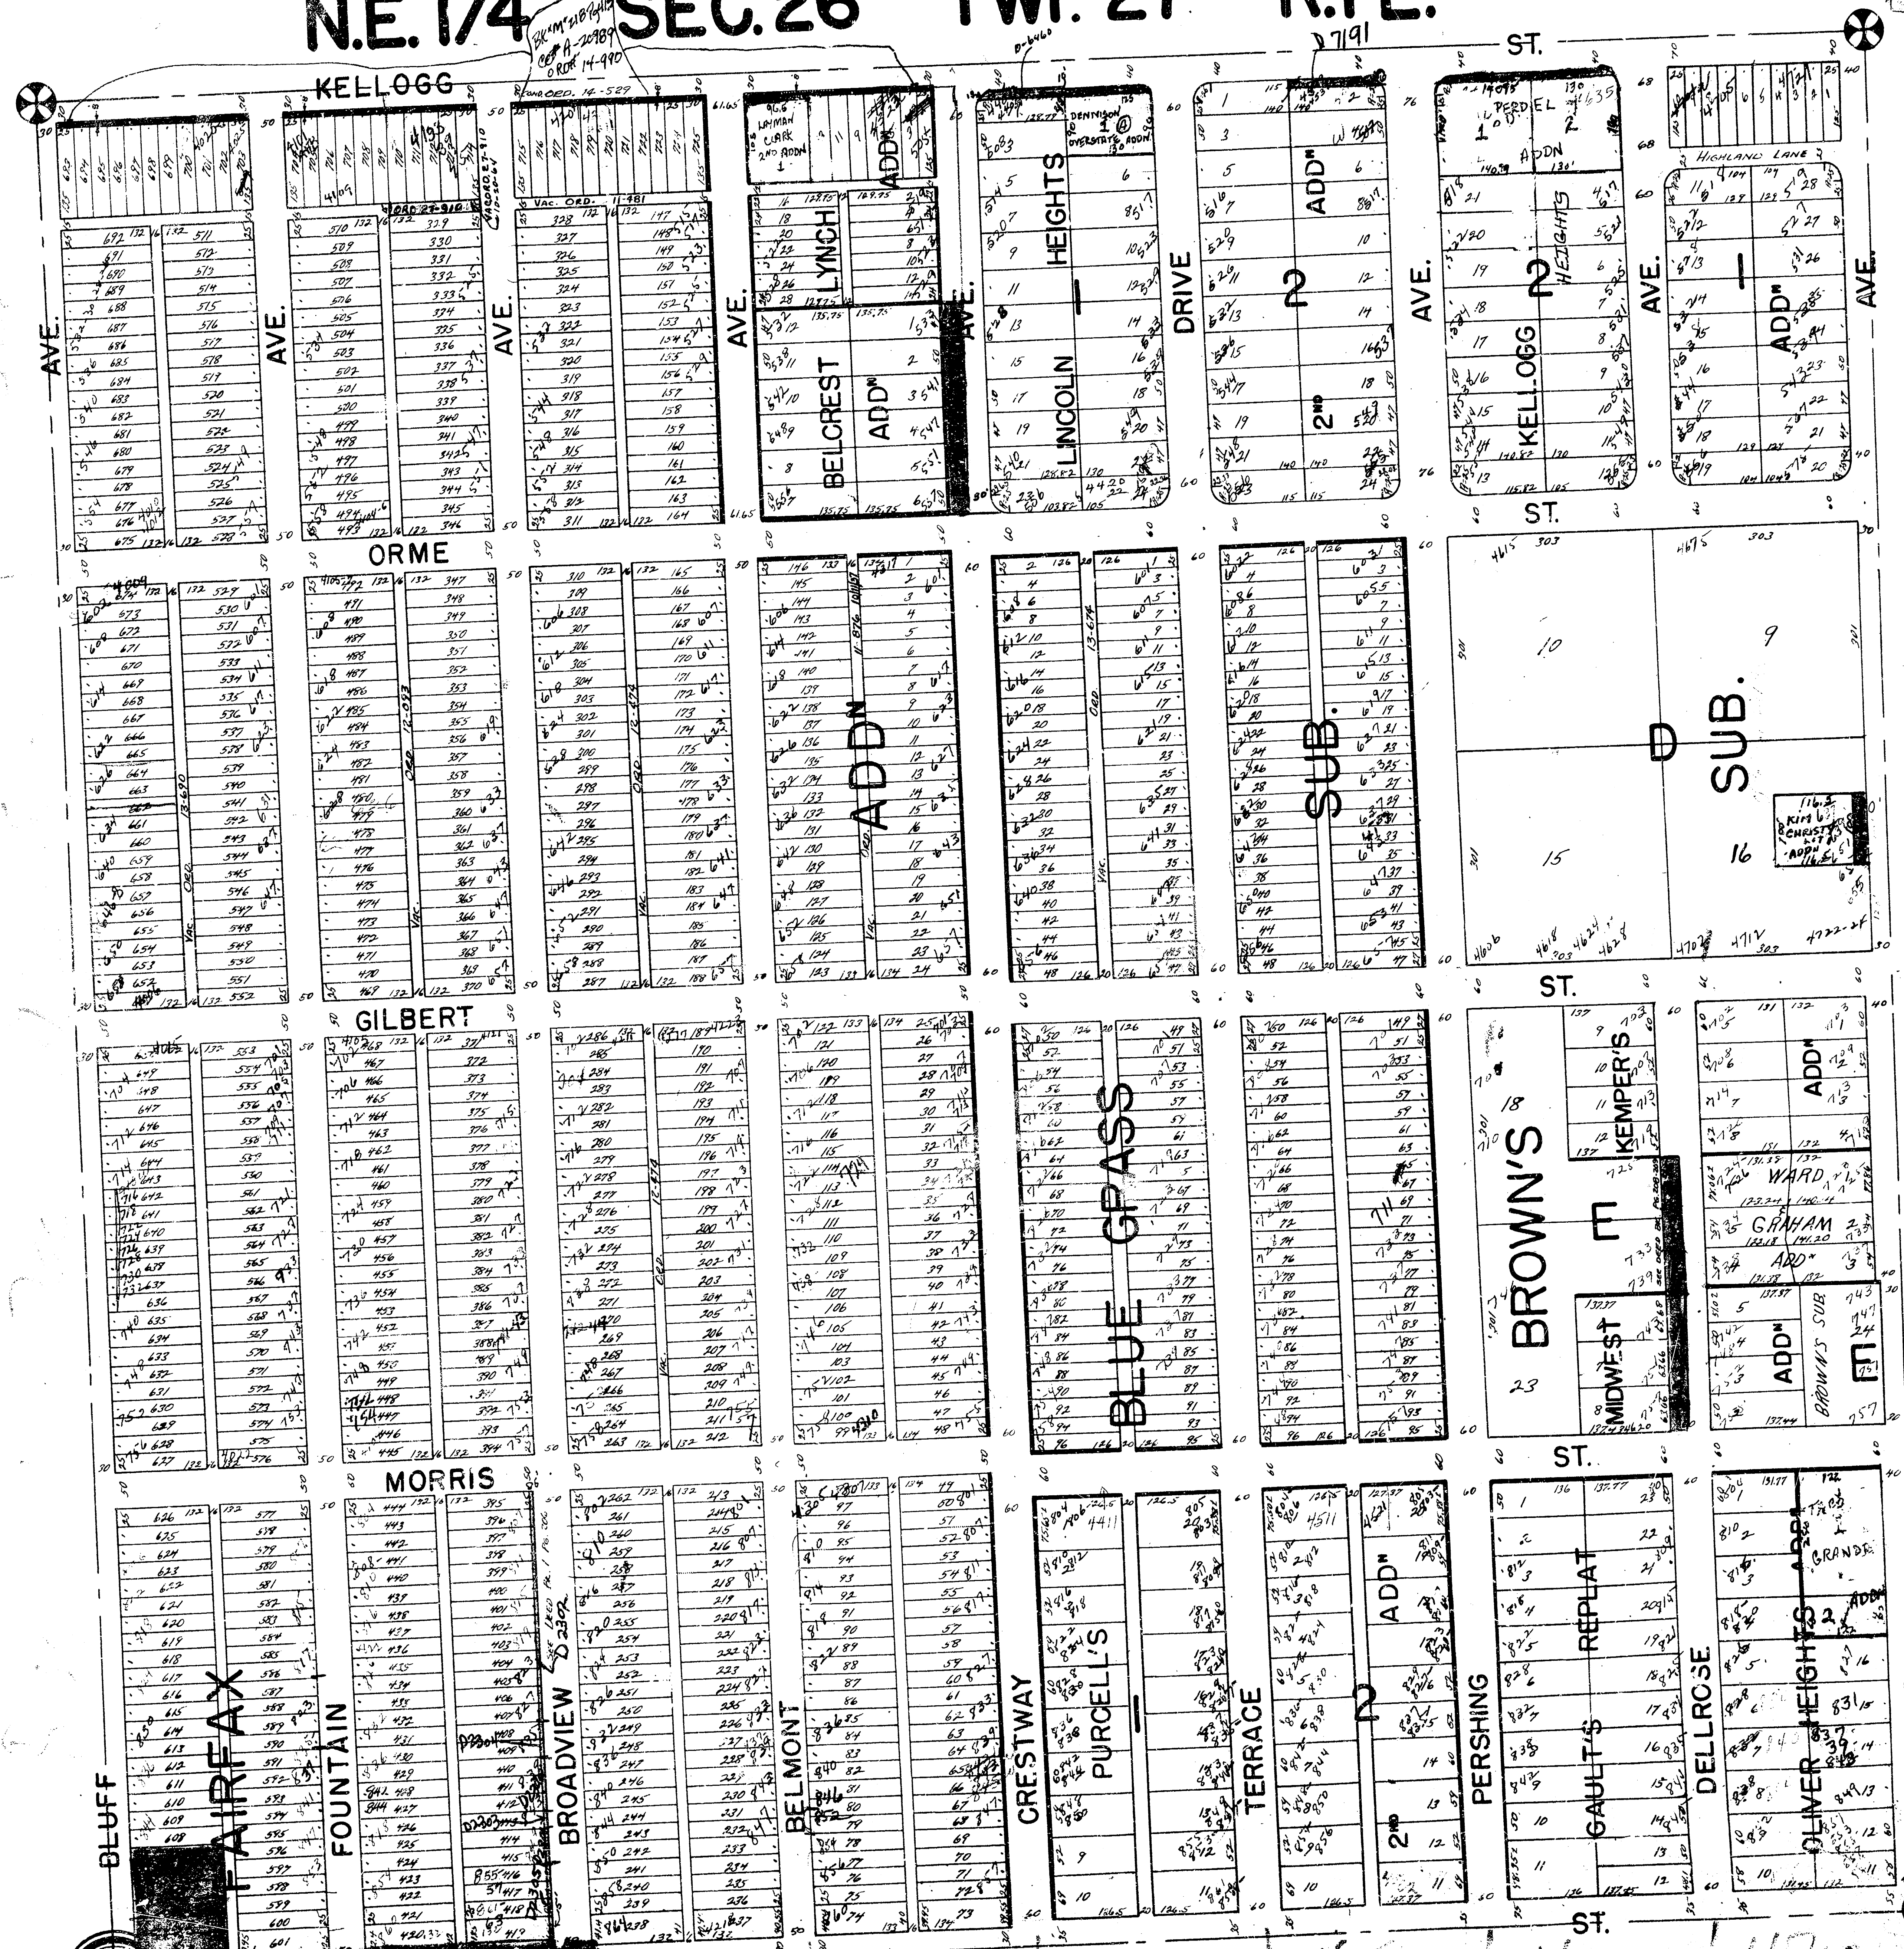

26

4500 4100 4200 4300 4400 4500 4600 4700