


N.E. 1/4 SEC. 35 TWP. 27 S. R. 1 E.

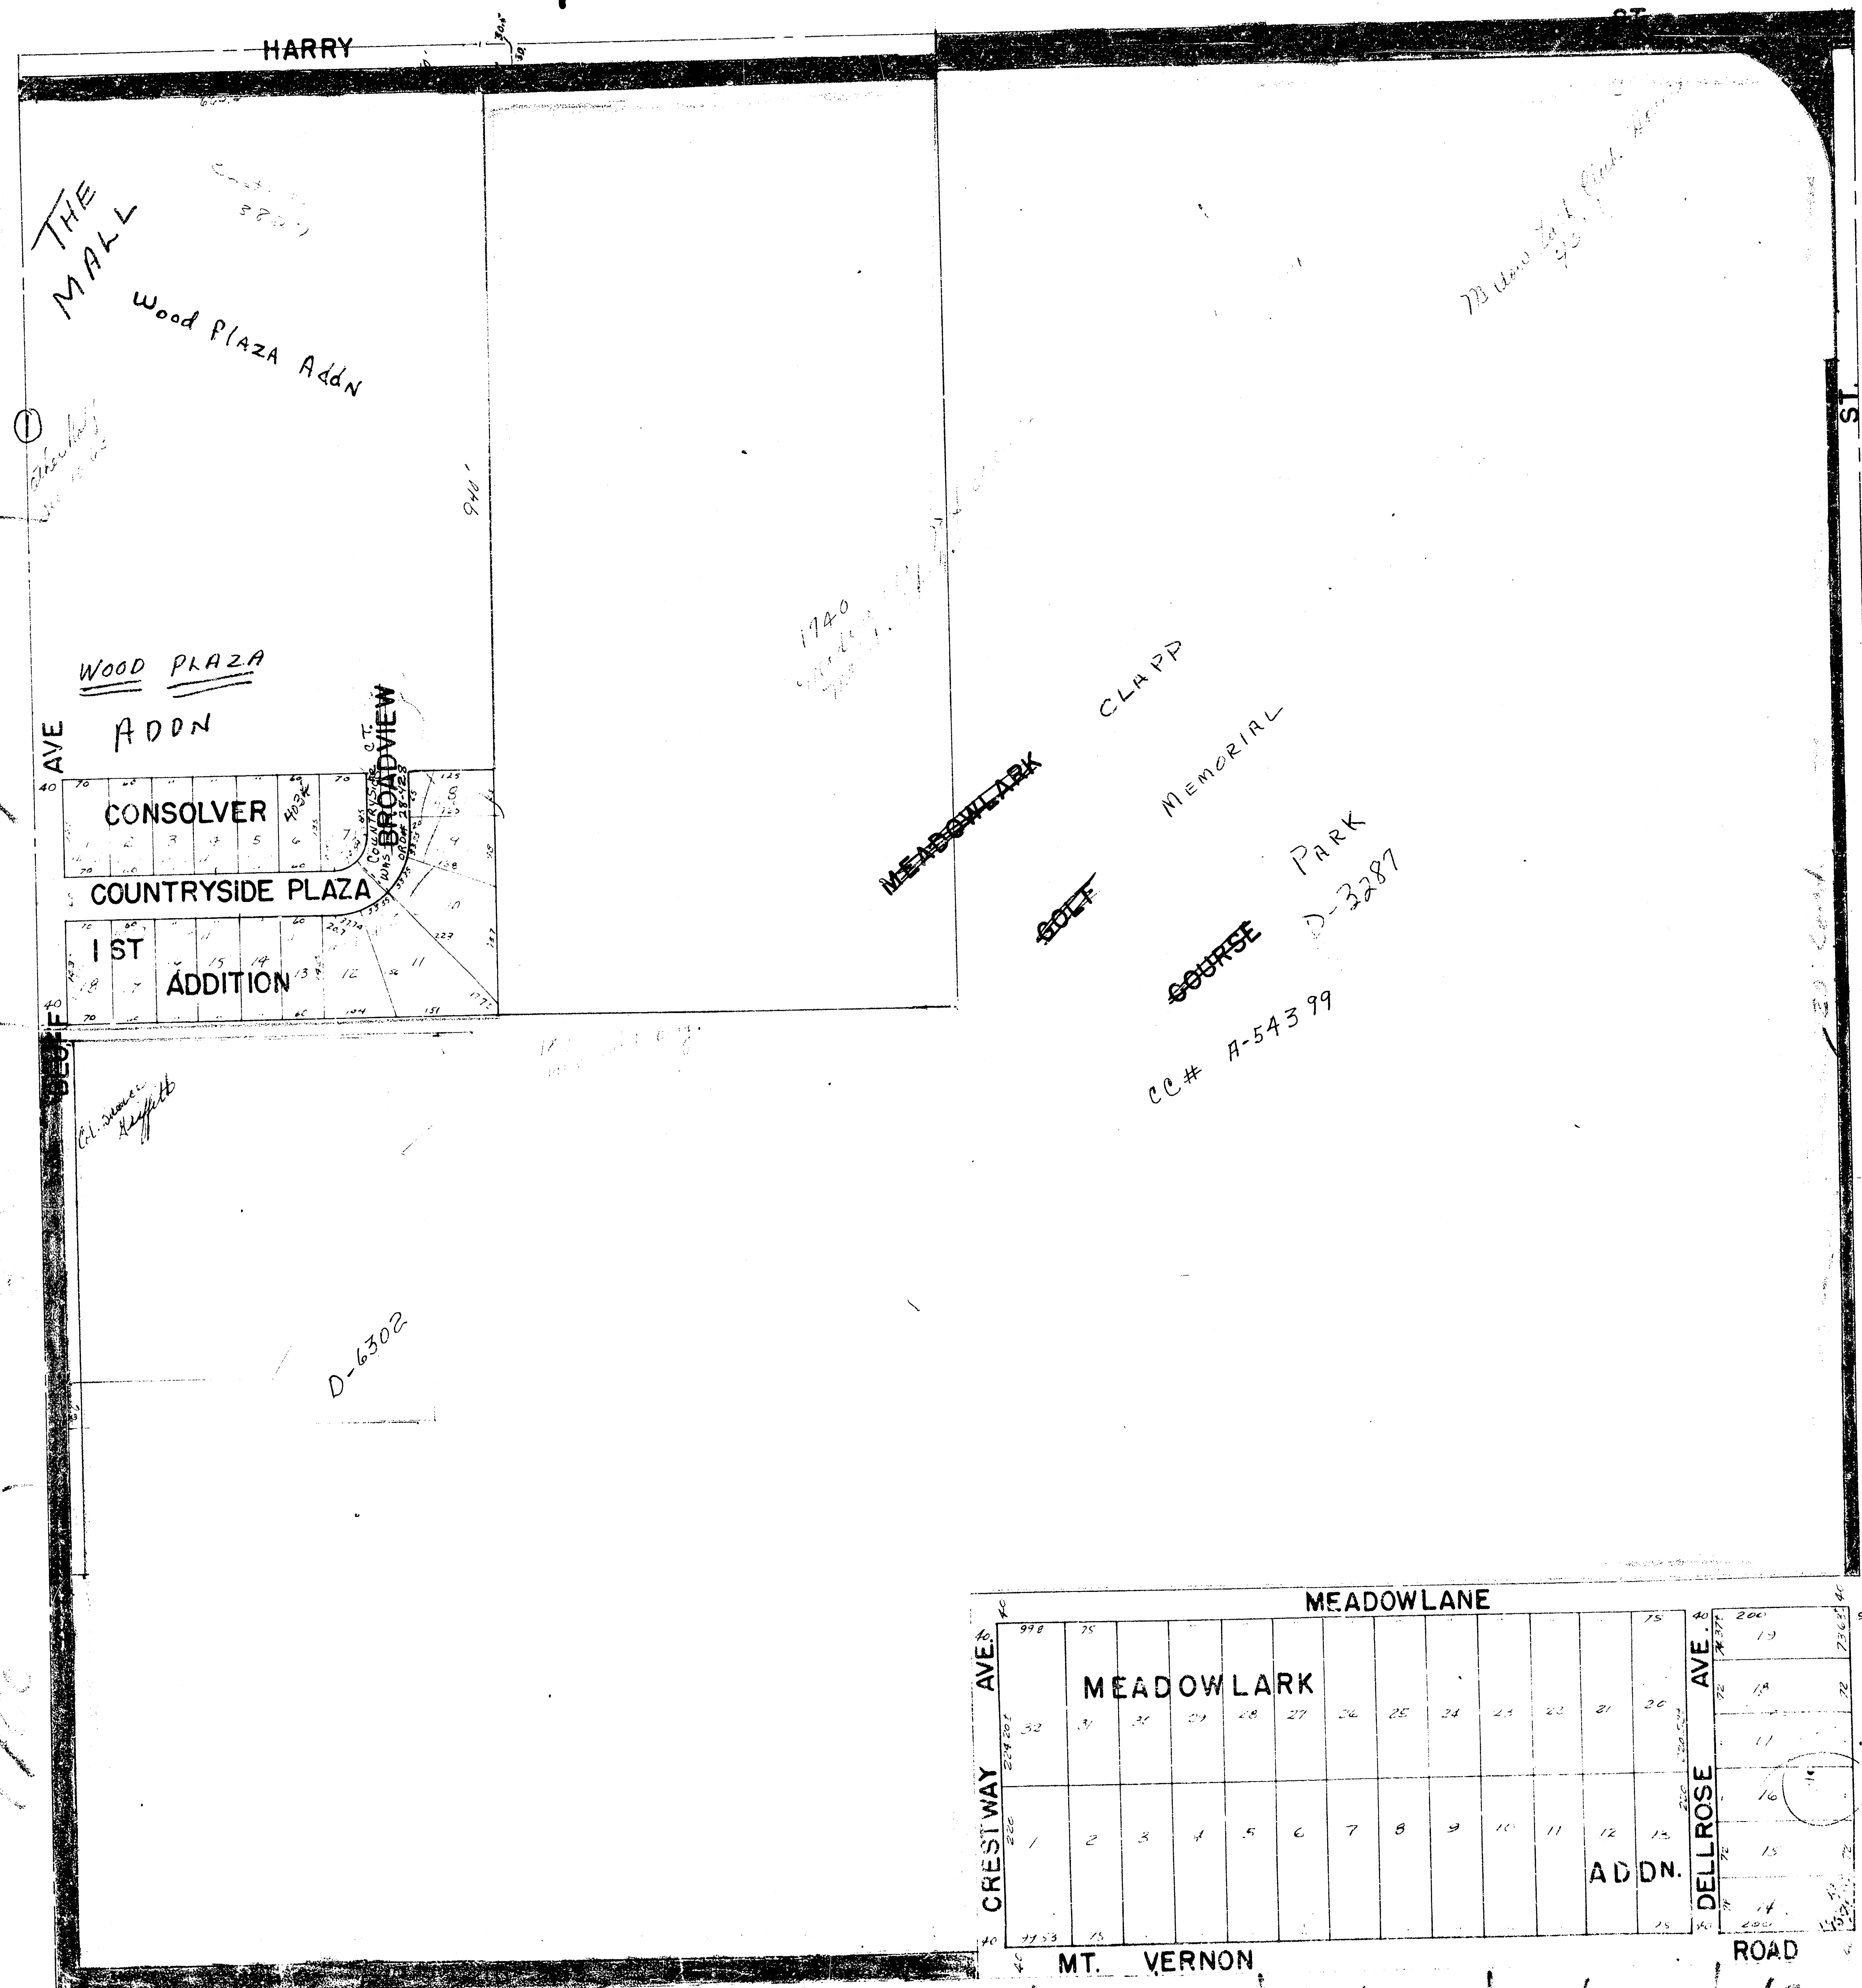

MEADOWLANE													
