


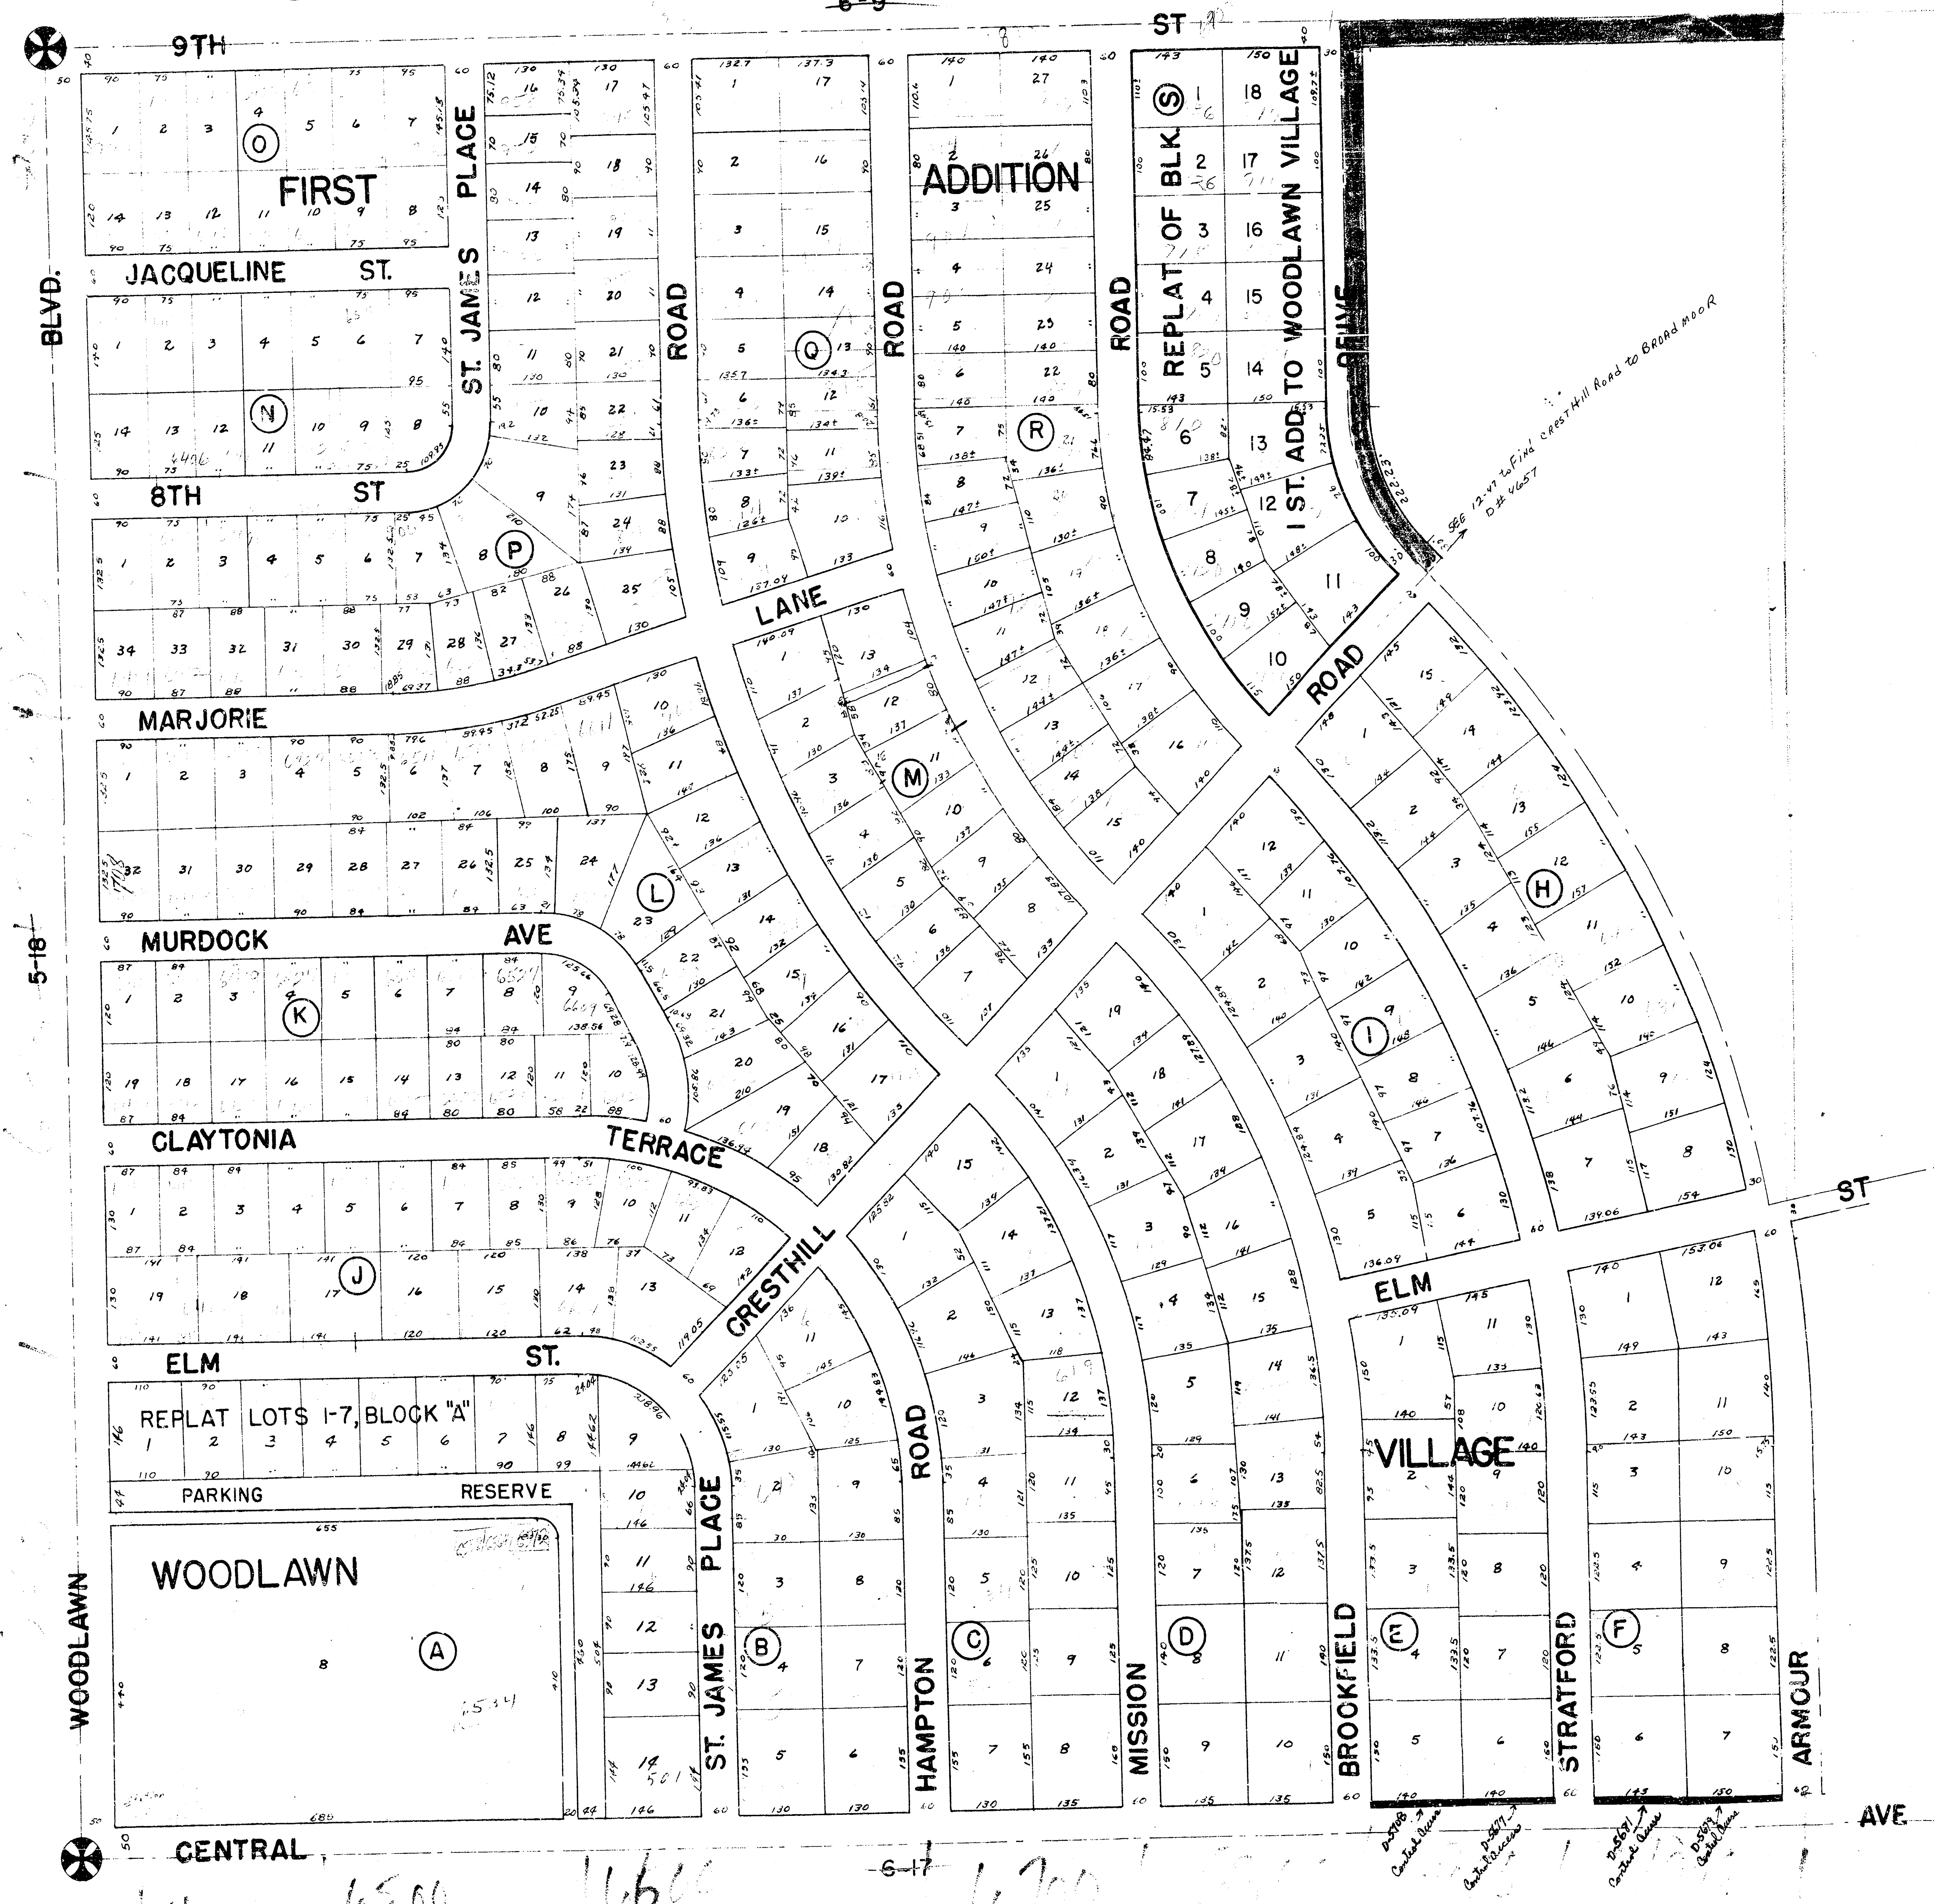

6500 6600 6700