


S.W. 1/4, SEC. 17, TWP. 27 S., R. 2 E.

6-15
12-48

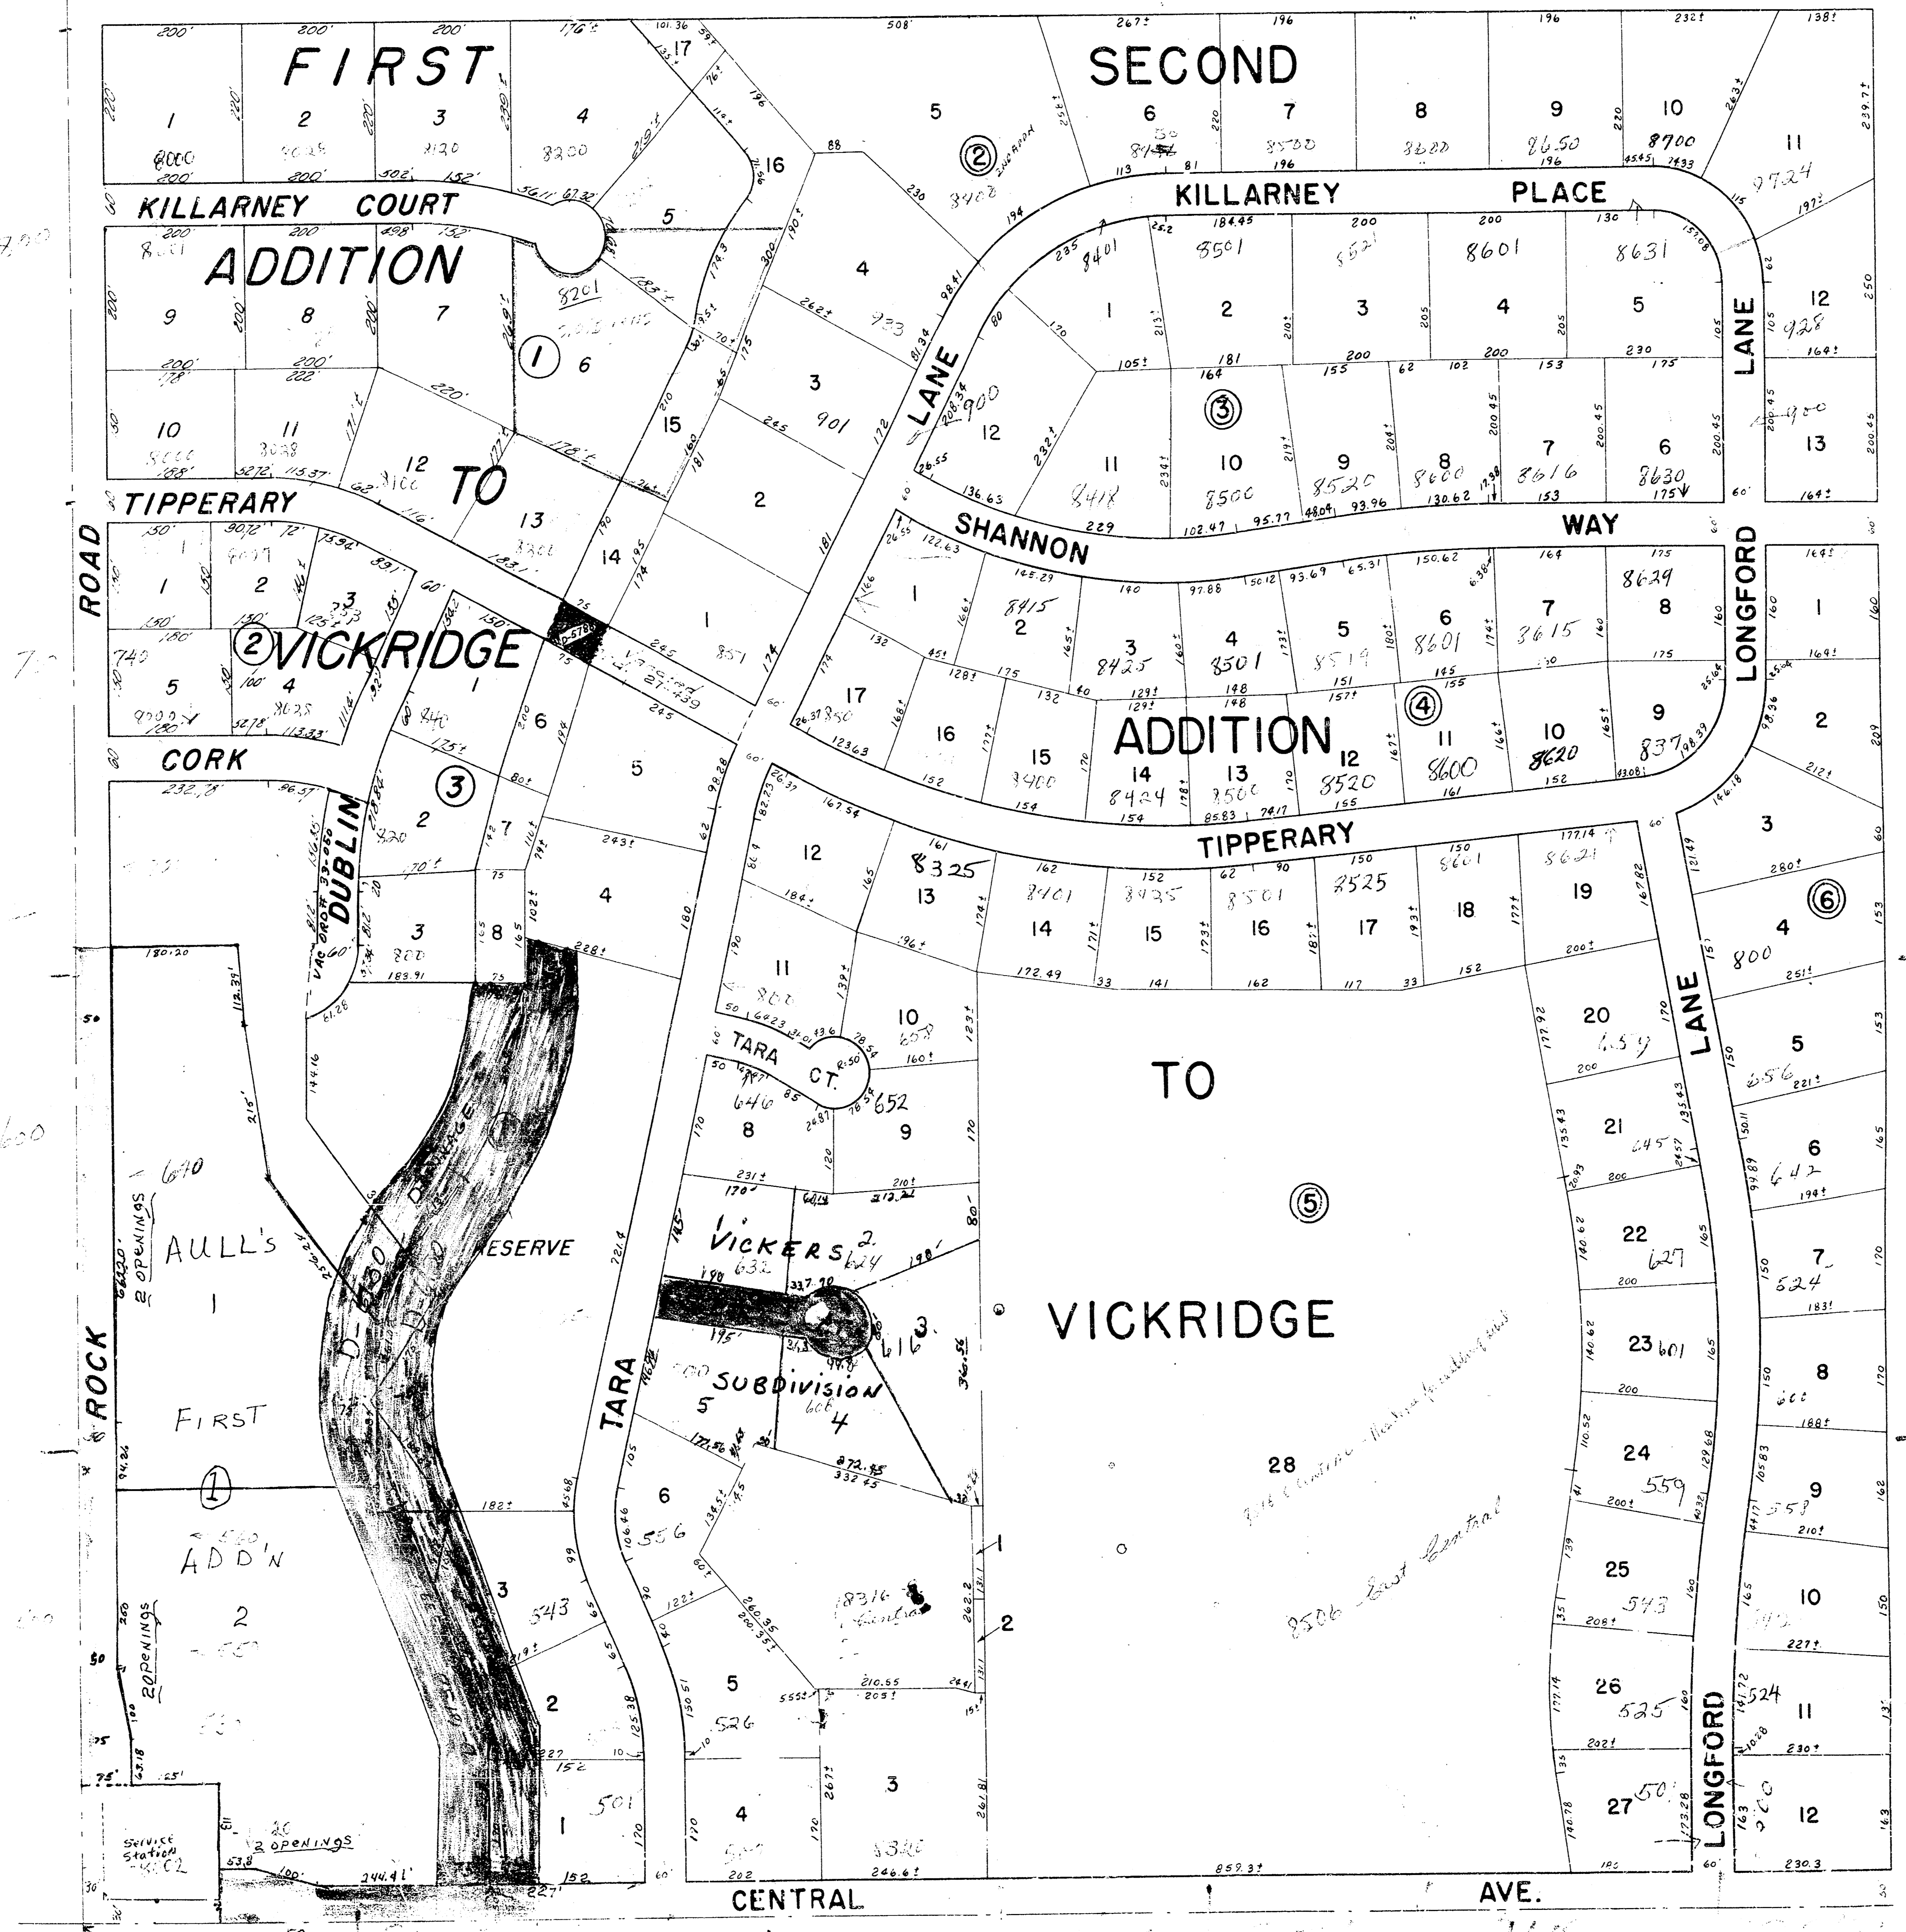

700

700

600

500

500

