12-59 ~~3-30~~

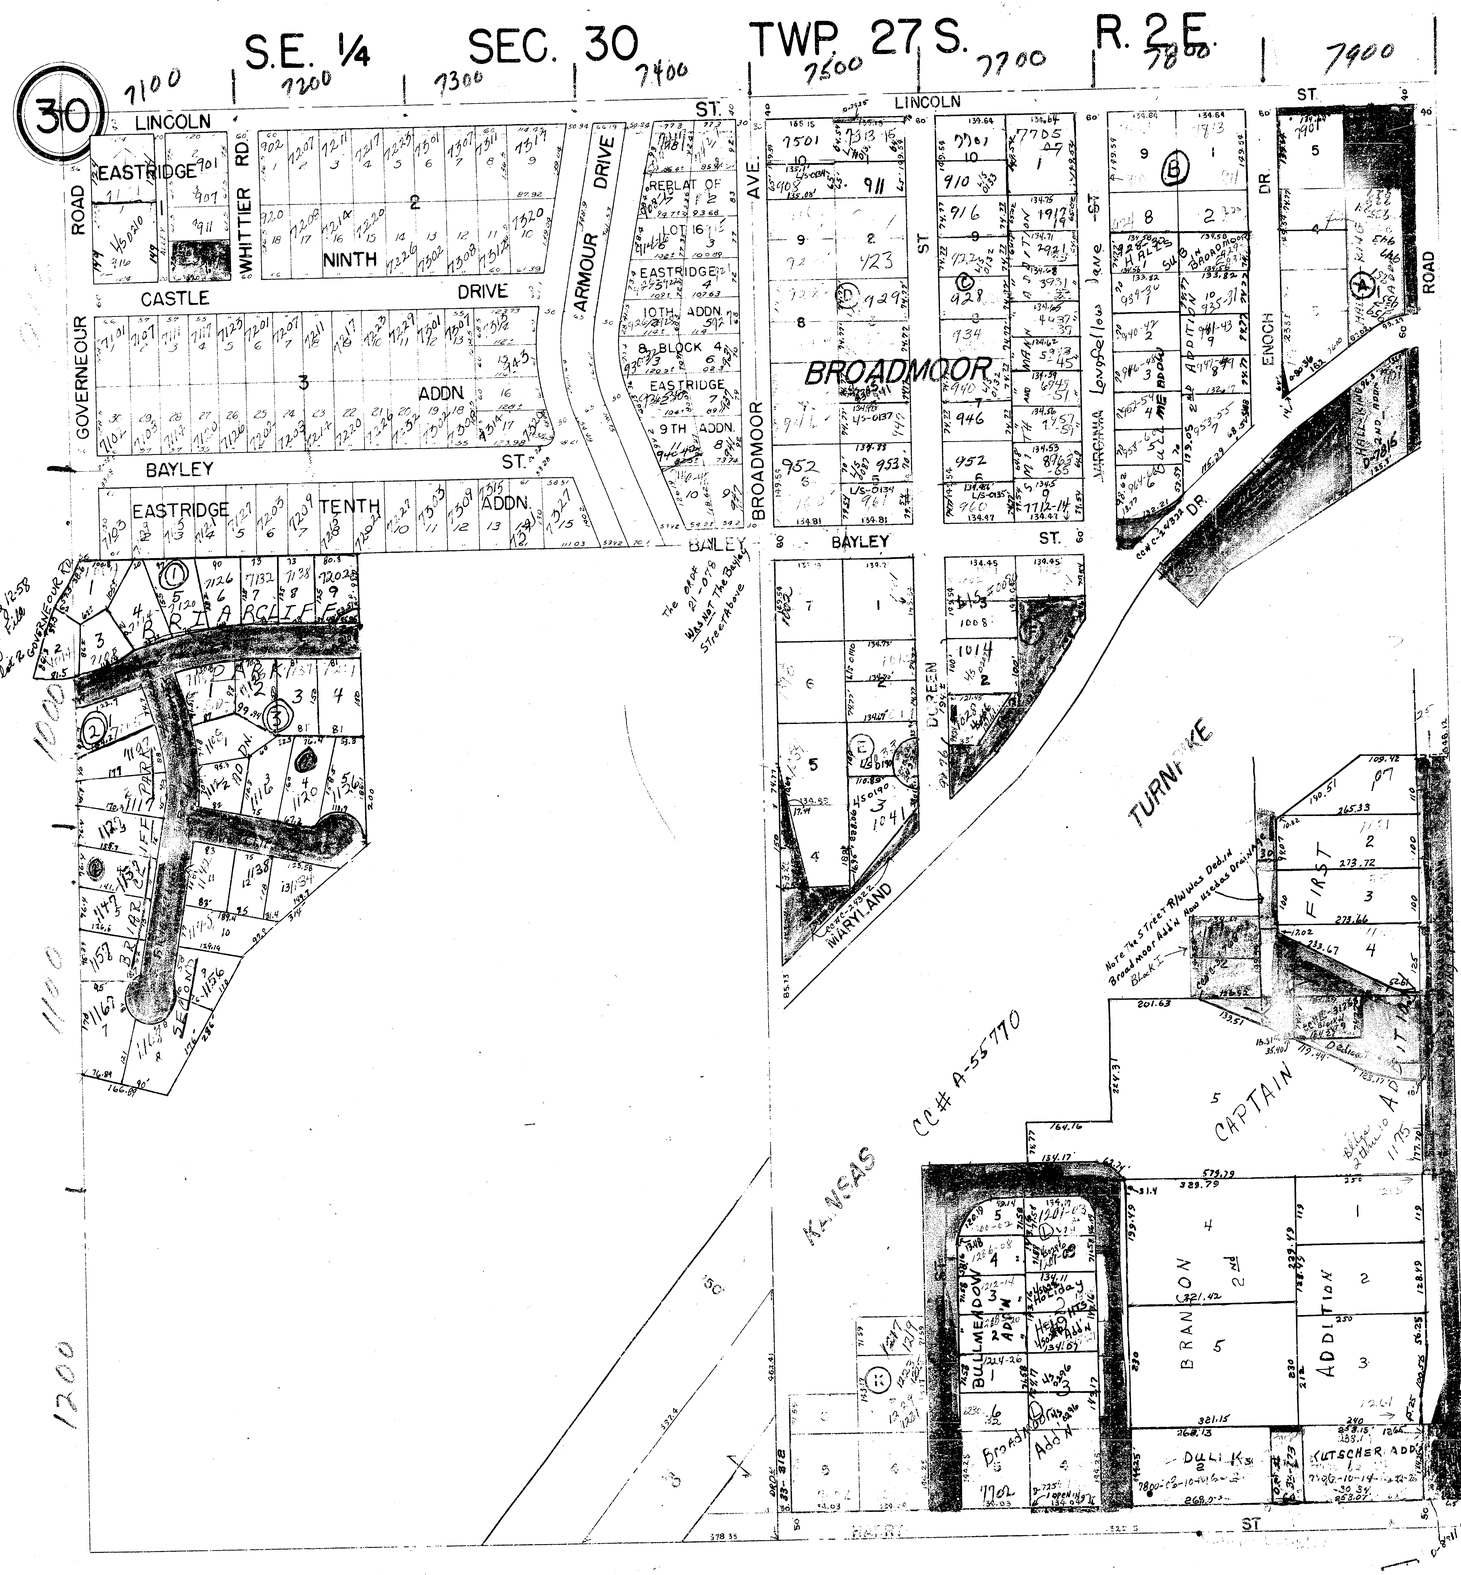
S.E. 1/4 SEC. 30 TWP. 27 S. R. 2 E.
30
7100
7200
7300
7400
7500
7700
7800
7900
LINCOLN ST.
EASTRIDGE
WHITTIER RD
NINTH
CASTLE DRIVE
GOVERNEOUR ROAD
ADDN
BAYLEY ST.
EASTRIDGE TENTH ADDN.
ARMOUR DRIVE
REPLAT OF LOT 16
EASTRIDGE 10TH ADDN.
BLOCK 4
EASTRIDGE 9TH ADDN.
BROADMOOR AVE.
BROADMOOR
VIRGINIA
Lovejoy
Jane ST
ENCH DR.
ROAD
DR.
BAYLEY ST.
DUREEN
MARYLAND
TURNPIKE
FIRST
CAPTAIN
KANSAS
CC# A-55770
BRANSON 2nd ADDITION
BULLMEADOW ADDN
DULIKS
KUTSCHER ADDN
ST