S.W. 1/4 SEC. 10 T W P. 27 R.I.E.

10-40
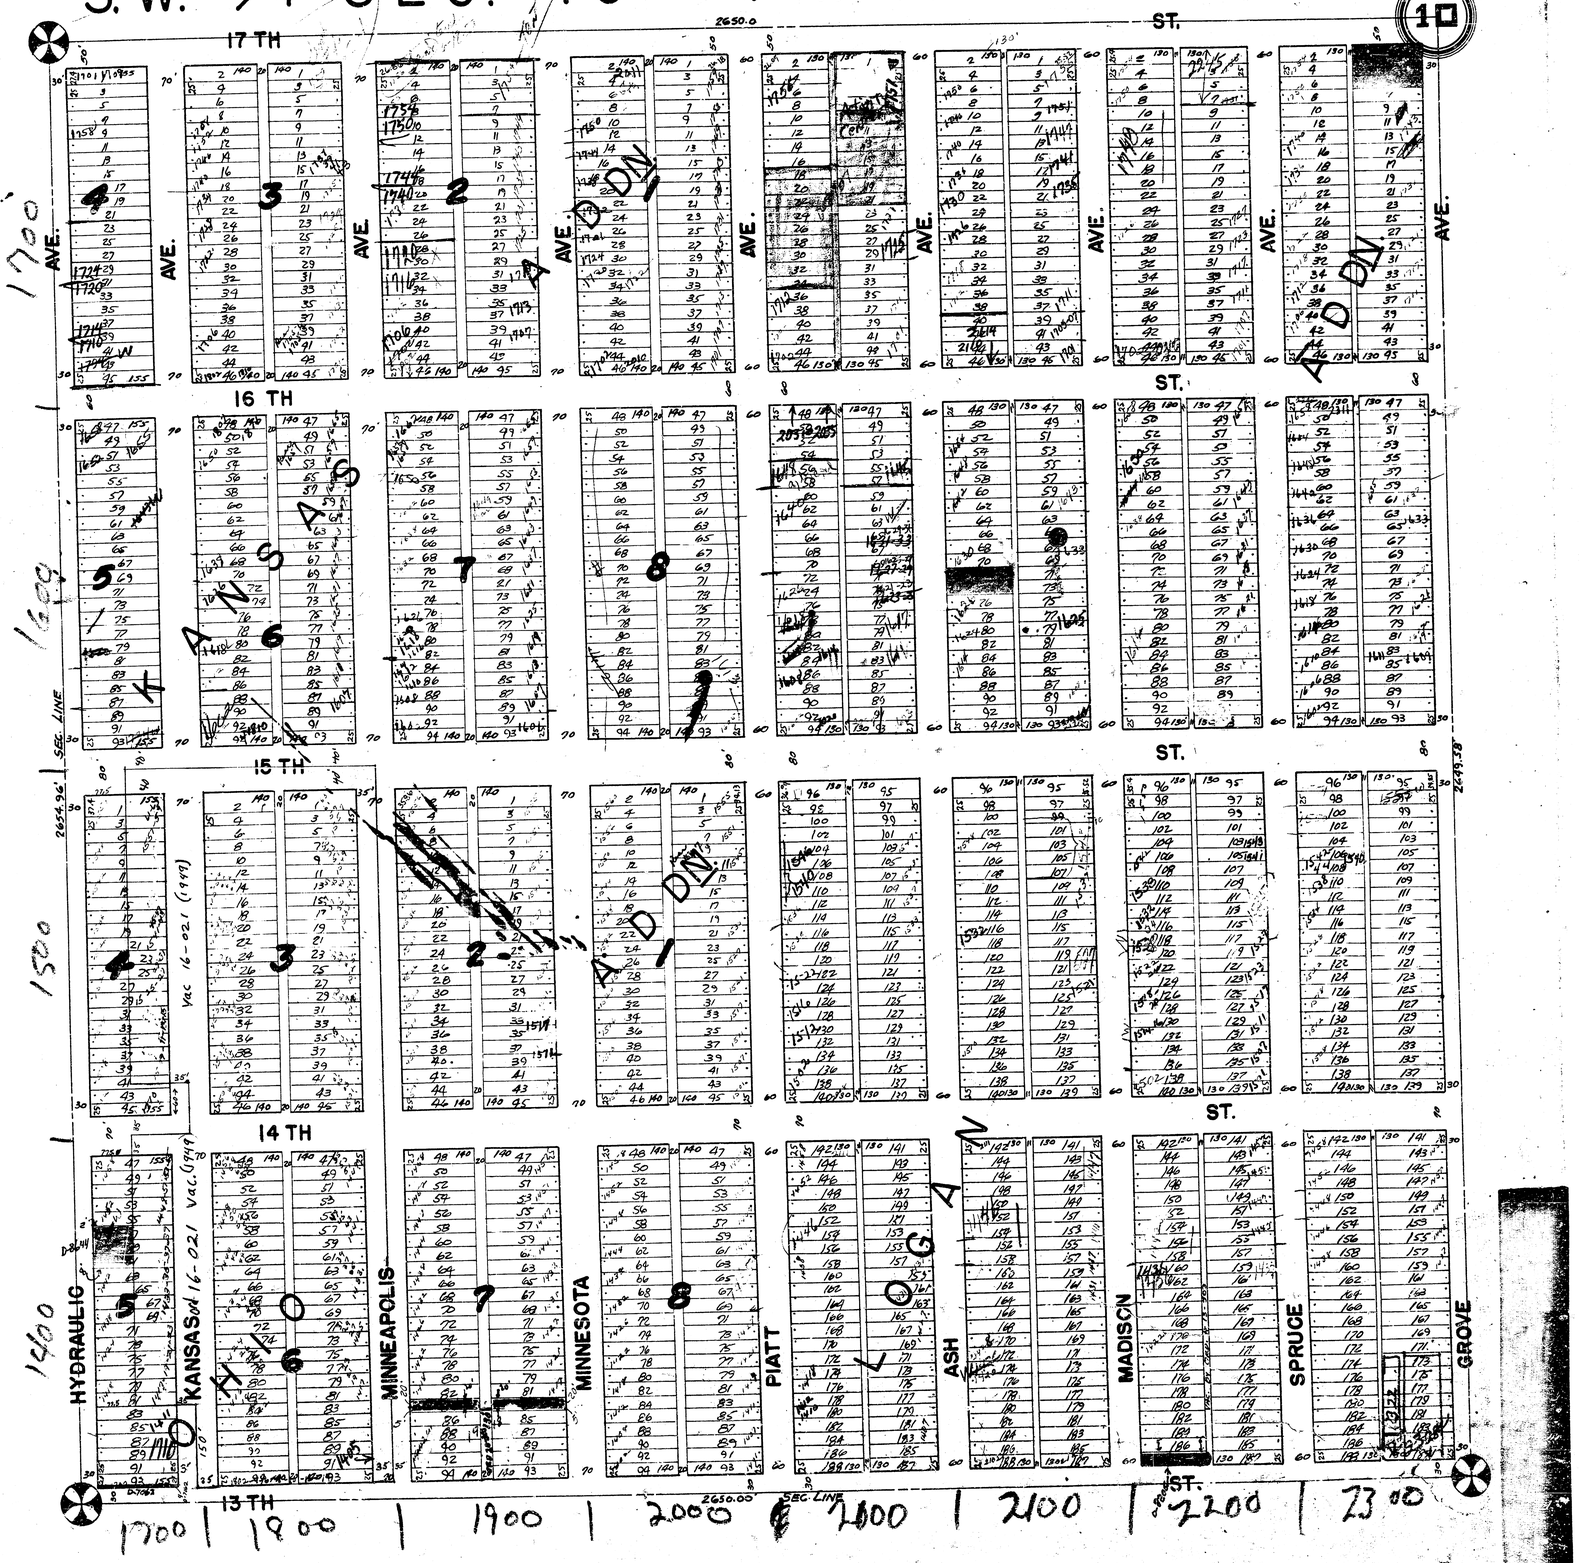
10