


N. W. 1/4 SEC. 15 TWP. 27 R. 1 E.

10-43

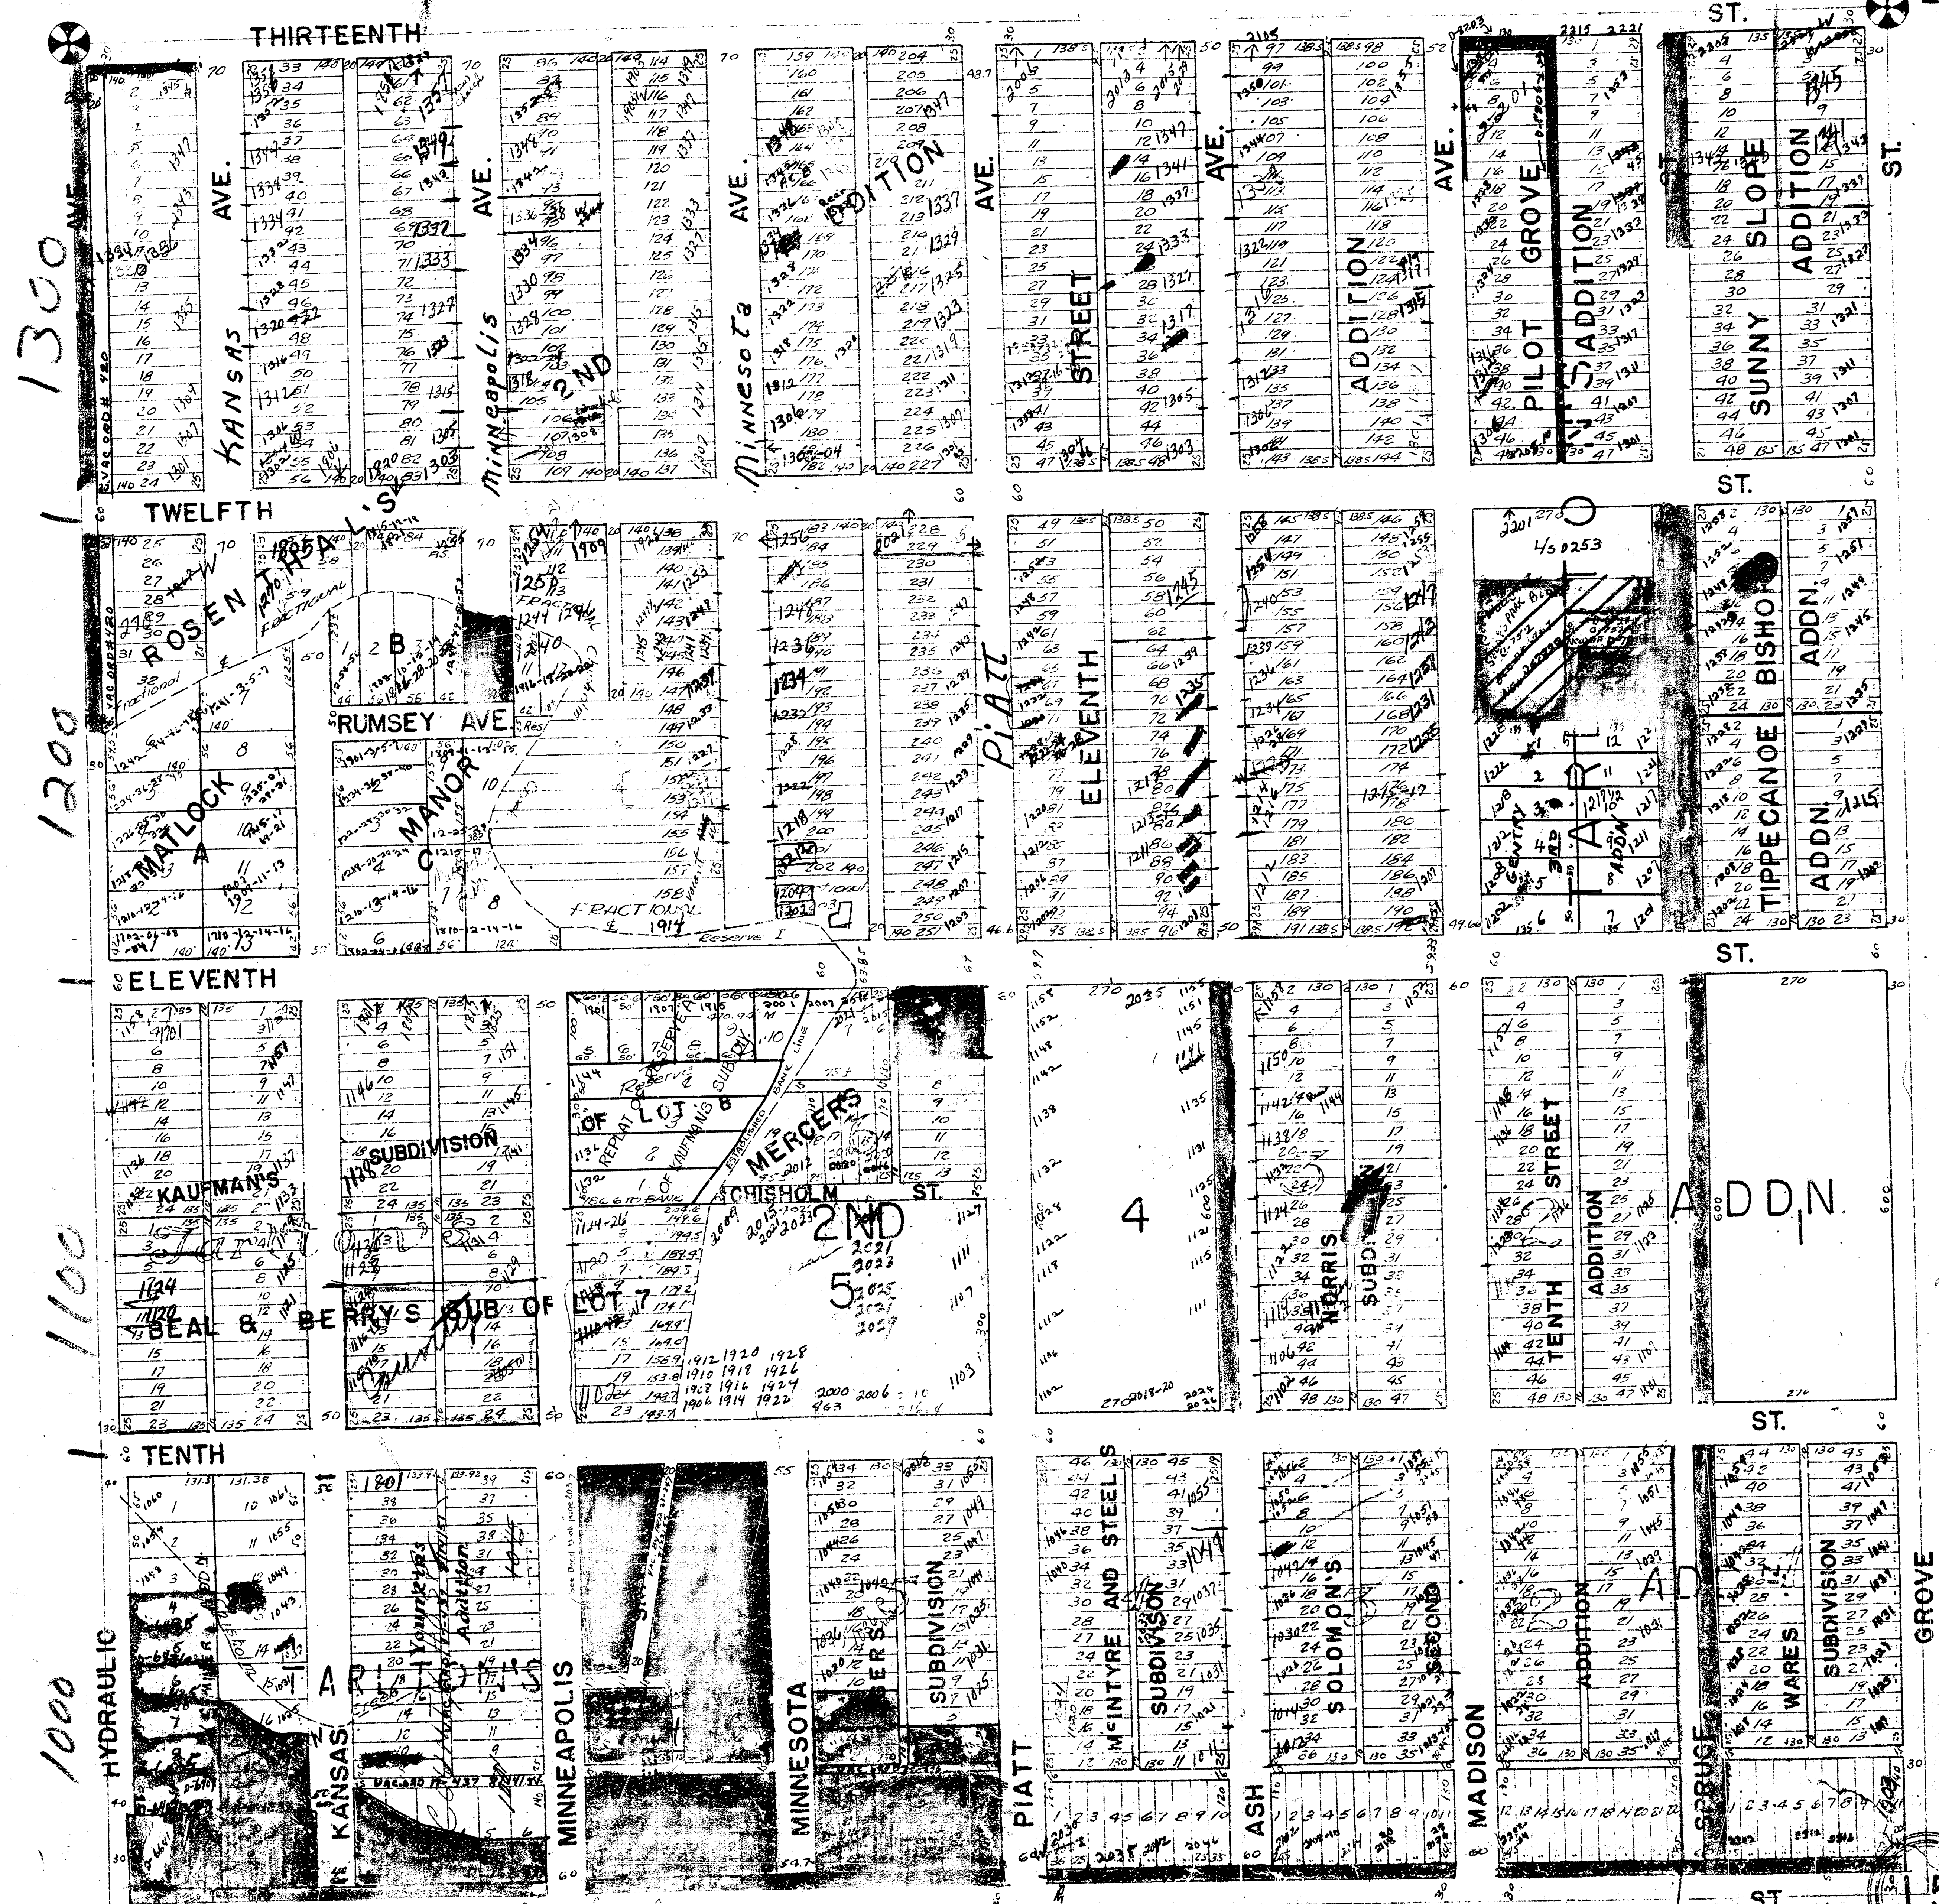

1300
1200
1100
1000

1700 | 1800 | 1900 | 2000 | 2100 | 2200 | 2300

City of
Health Dept.

15