


S.W. 1/4 of SEC. 22 TWP. 27, R.1.E.

10-52

22



DOUGLAS

AVE.

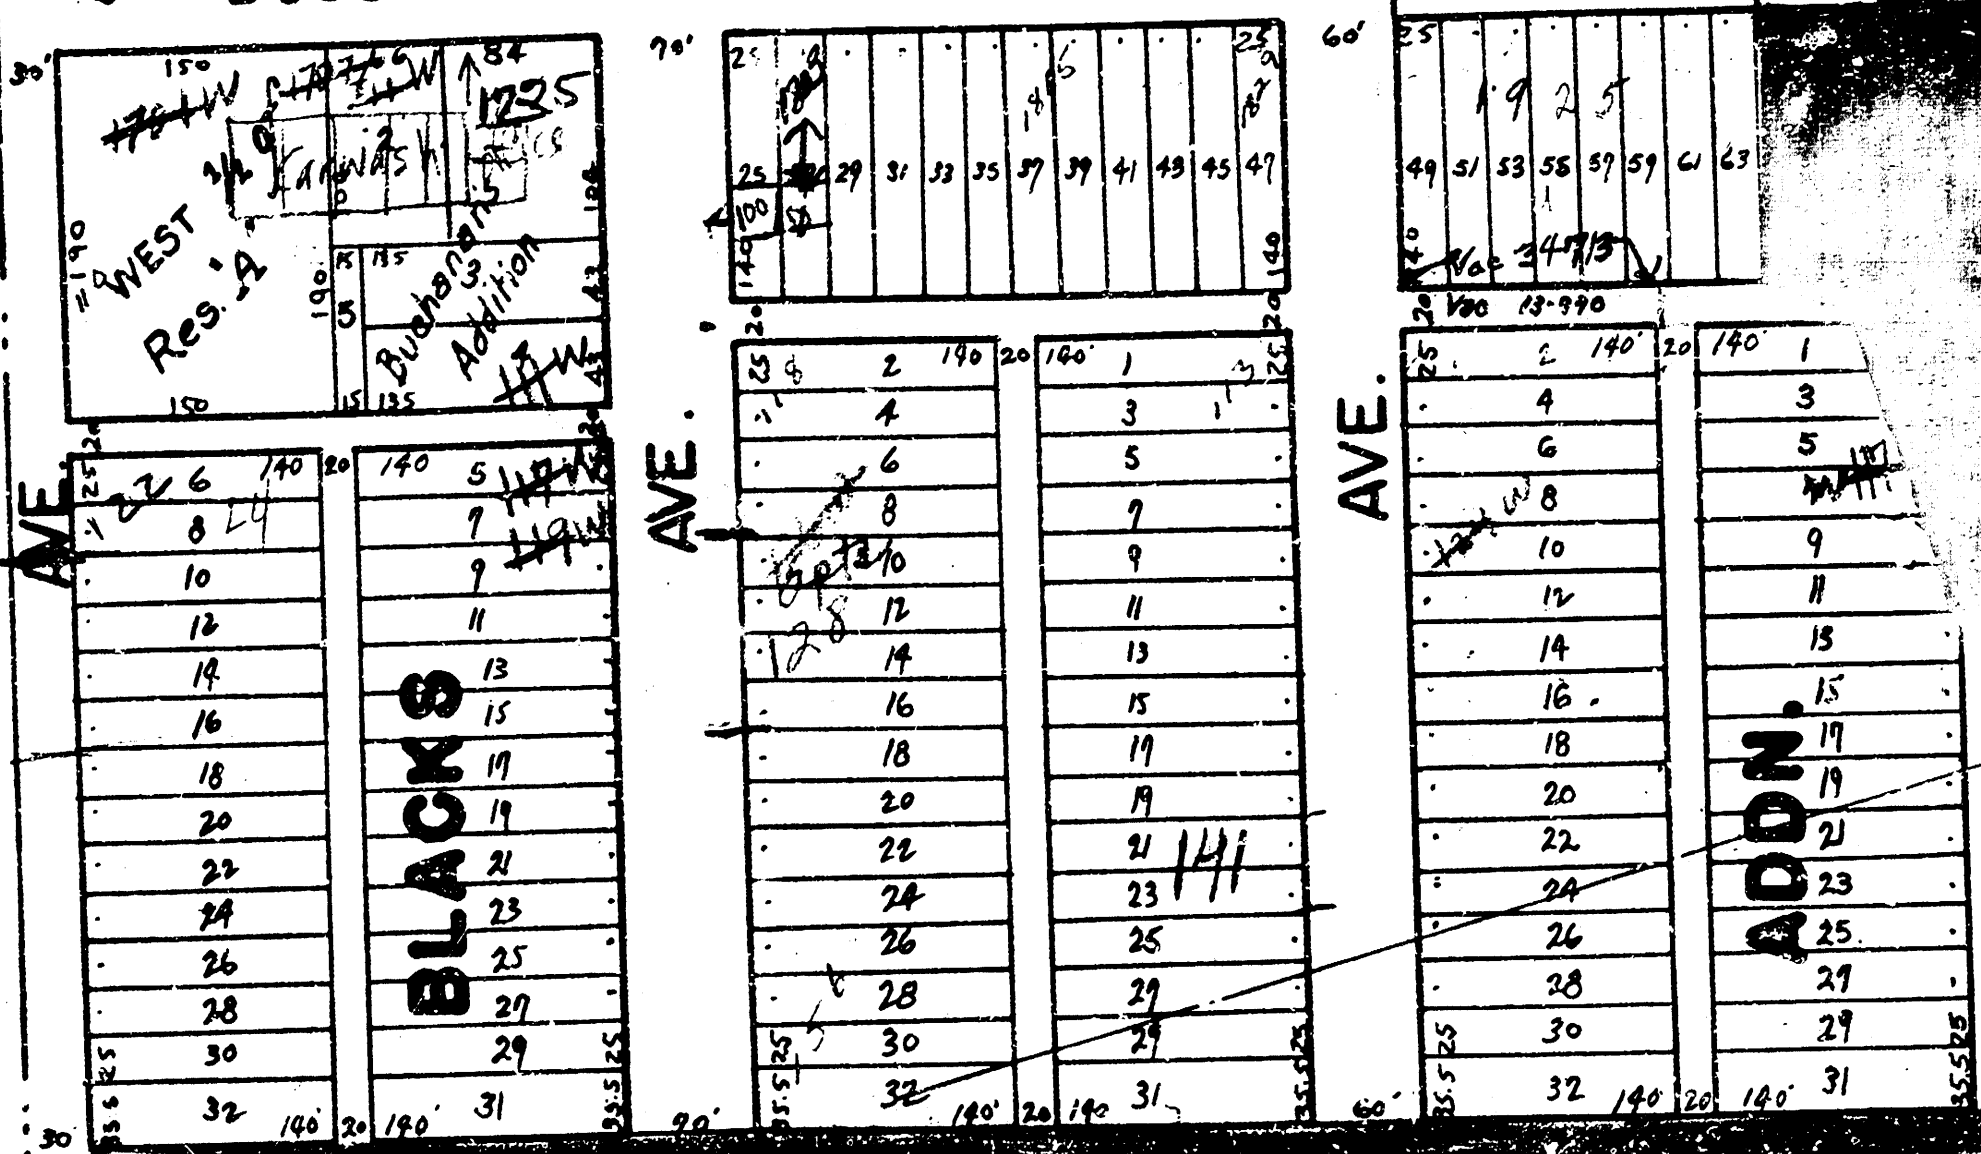

McKNIGHT'S RESERVE

WATERMAN

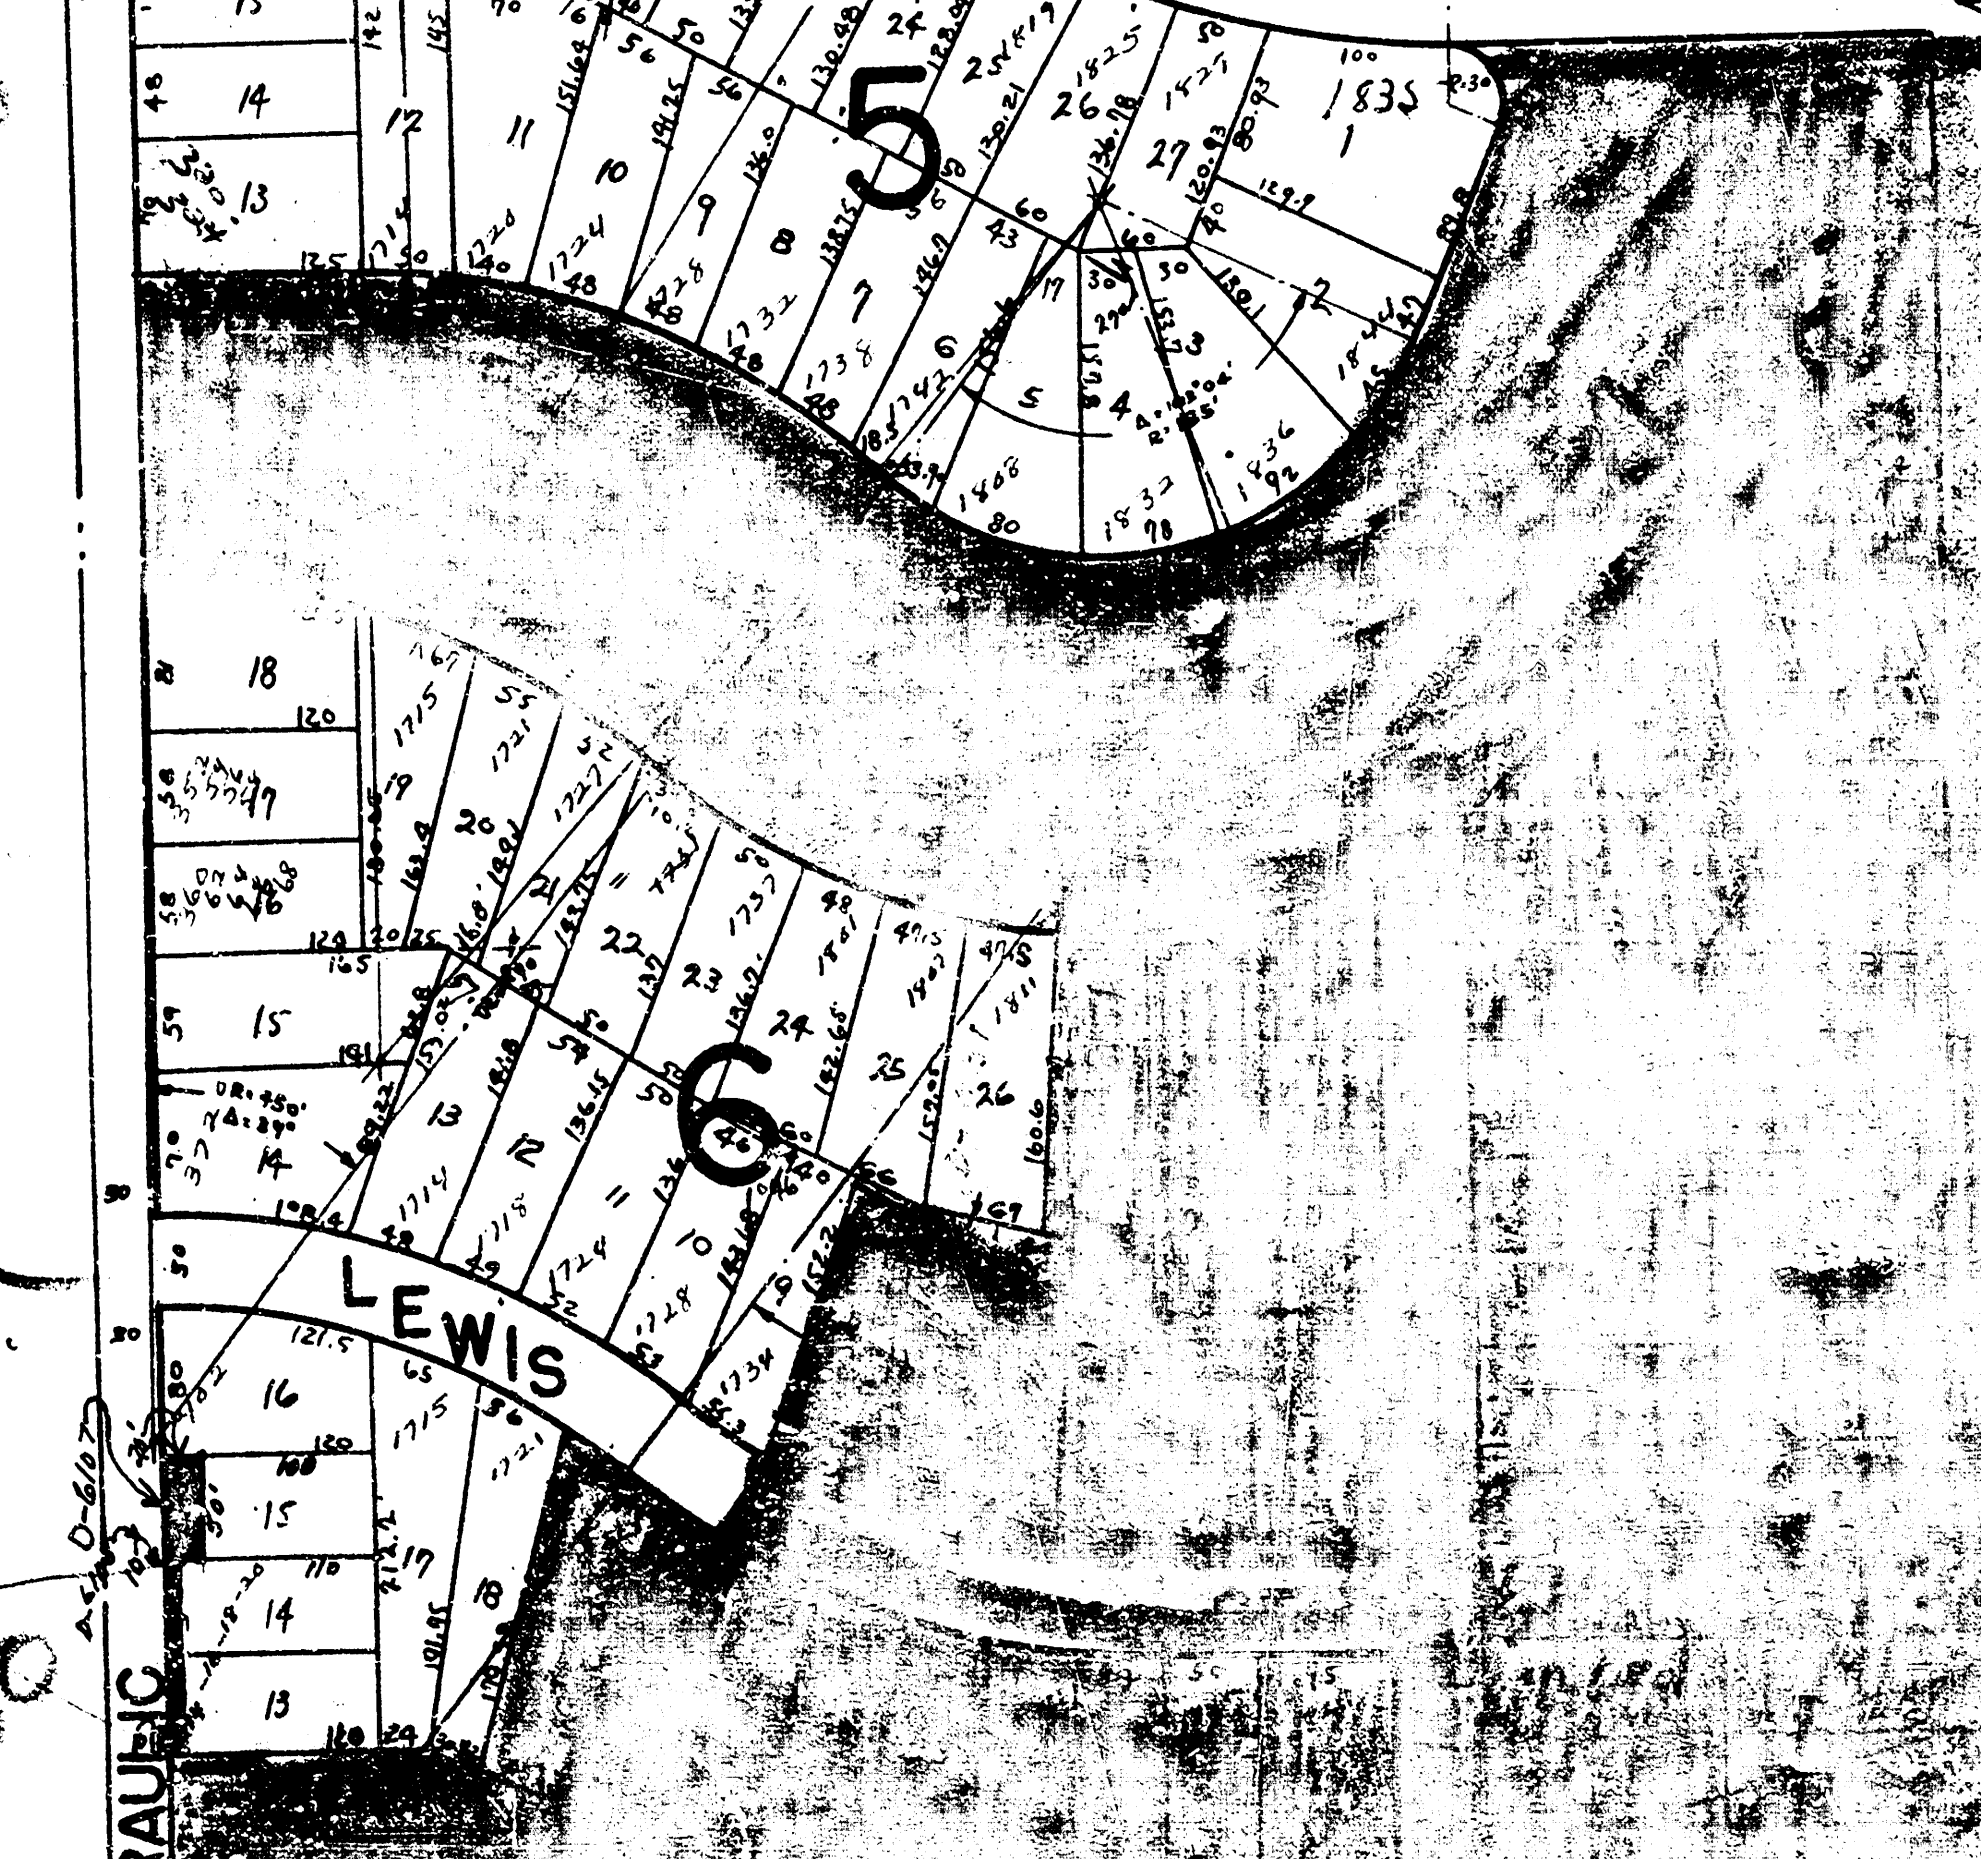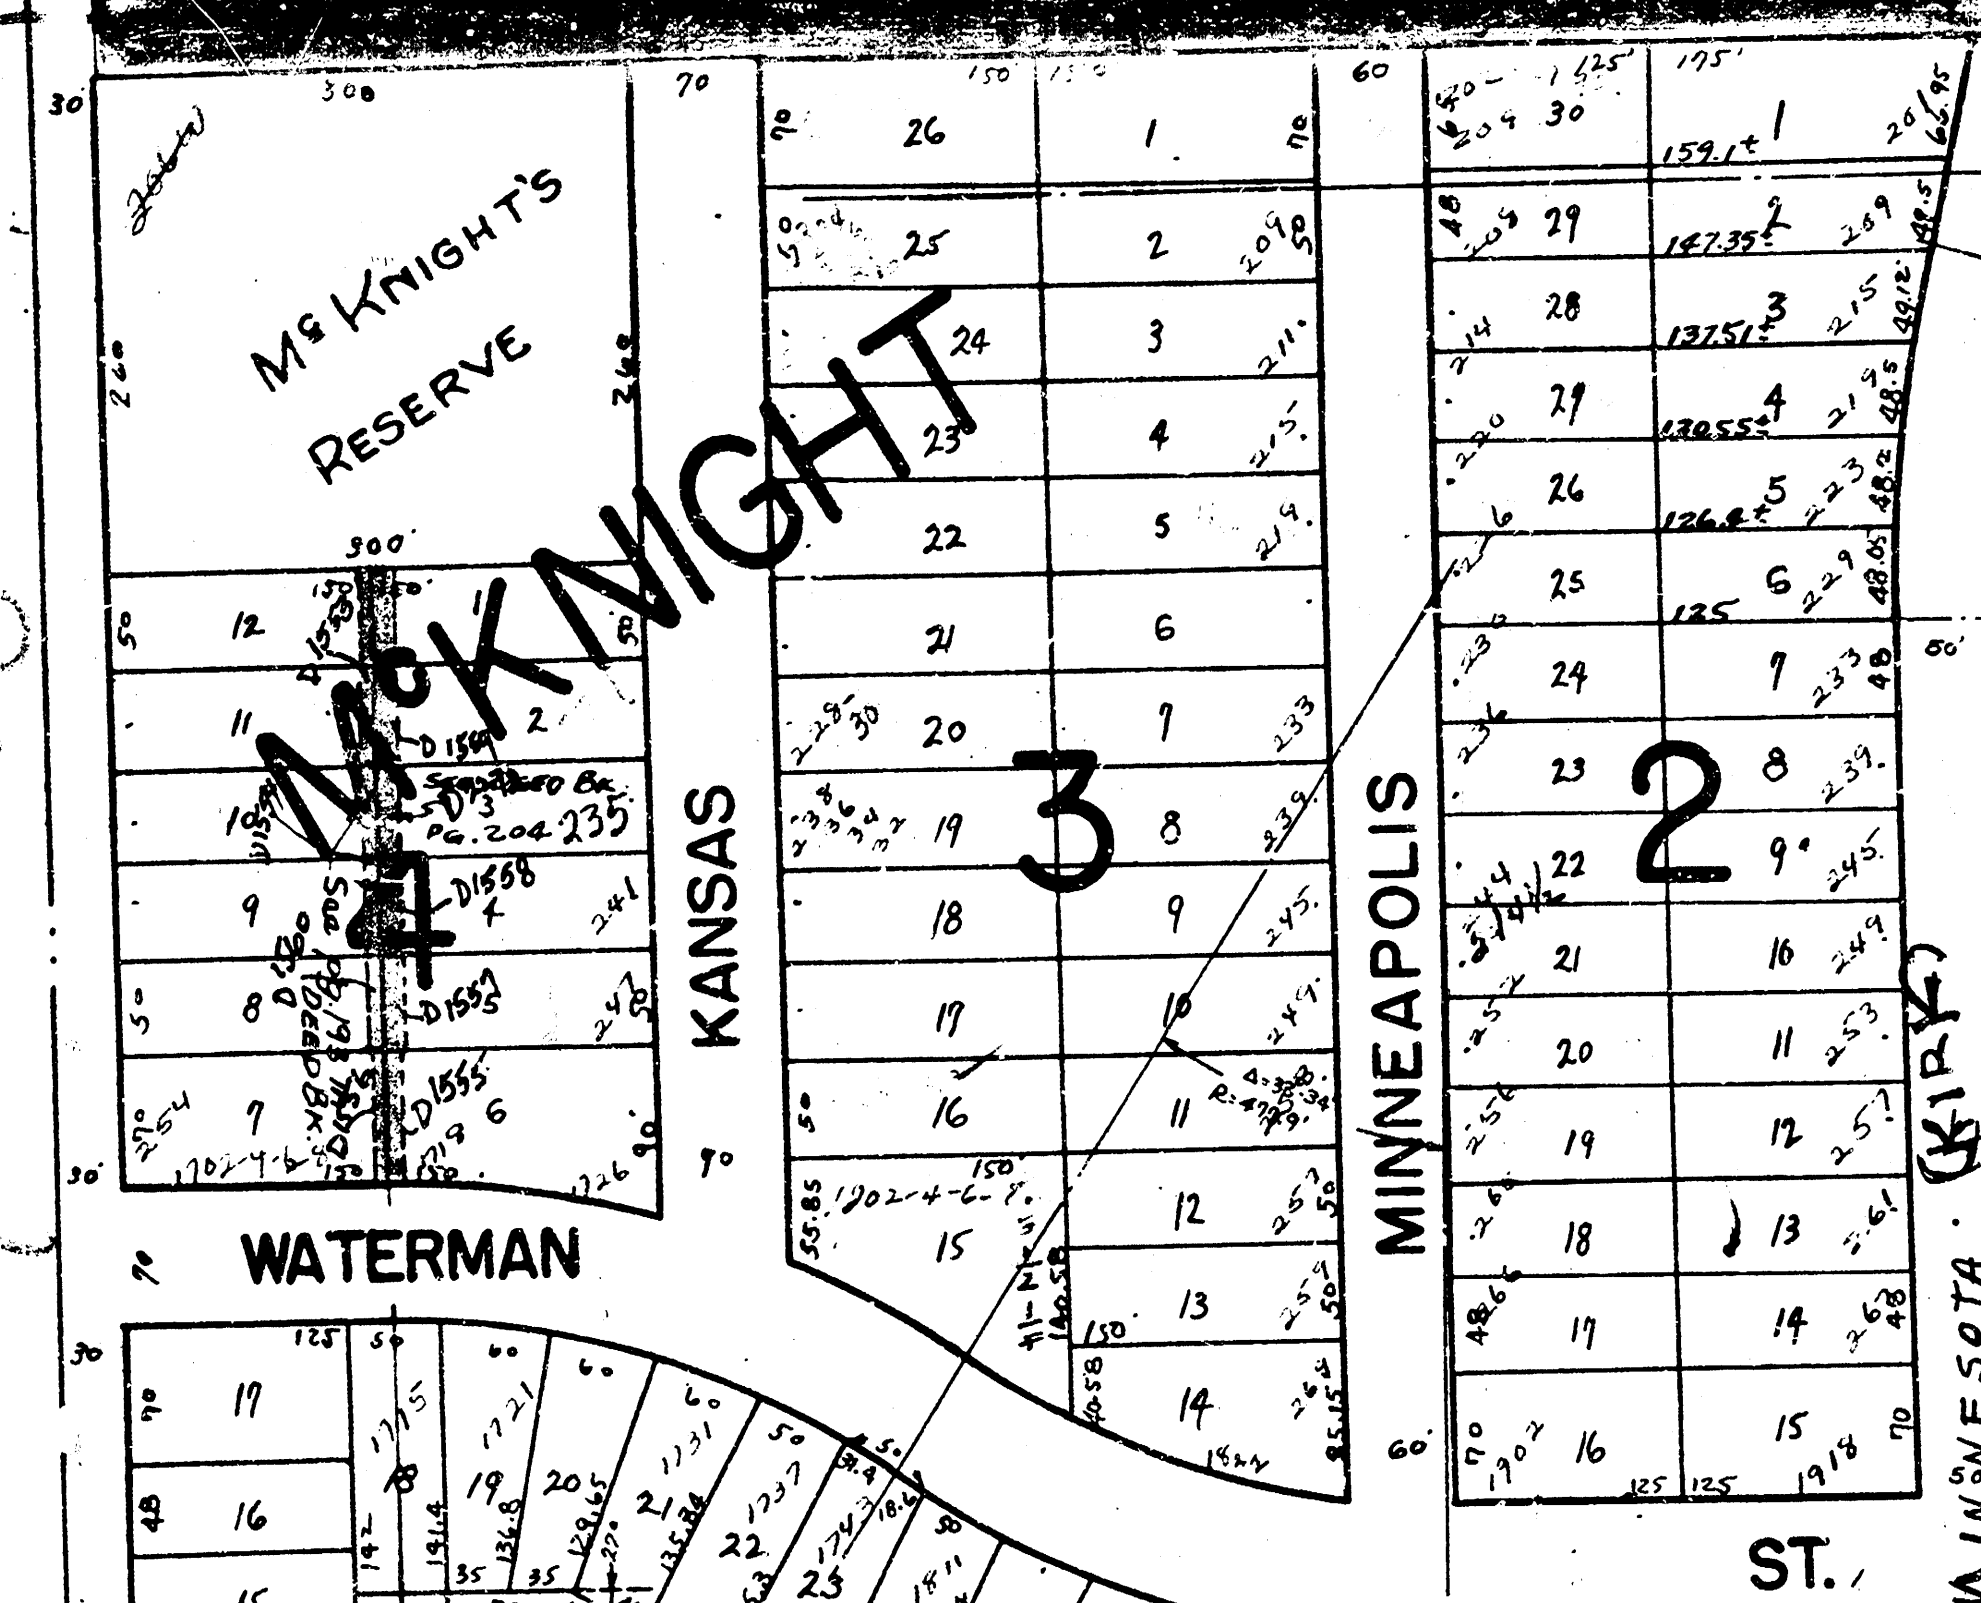

EAST HIGH SCHOOL

ORD. 14-183
ORD. A-21784
BK M 252 Pg 225

ORD. 14-190
ORD. A-21791
BK M 222 Pg 292

ORD. 14-190
ORD. A-21791
BK M 222 Pg 297

ORD. 14-190
ORD. A-21791
BK M 222 Pg 297