


NW. 1/4 OF SEC. 34 TWP. 27 S. R.1.E.

10-61

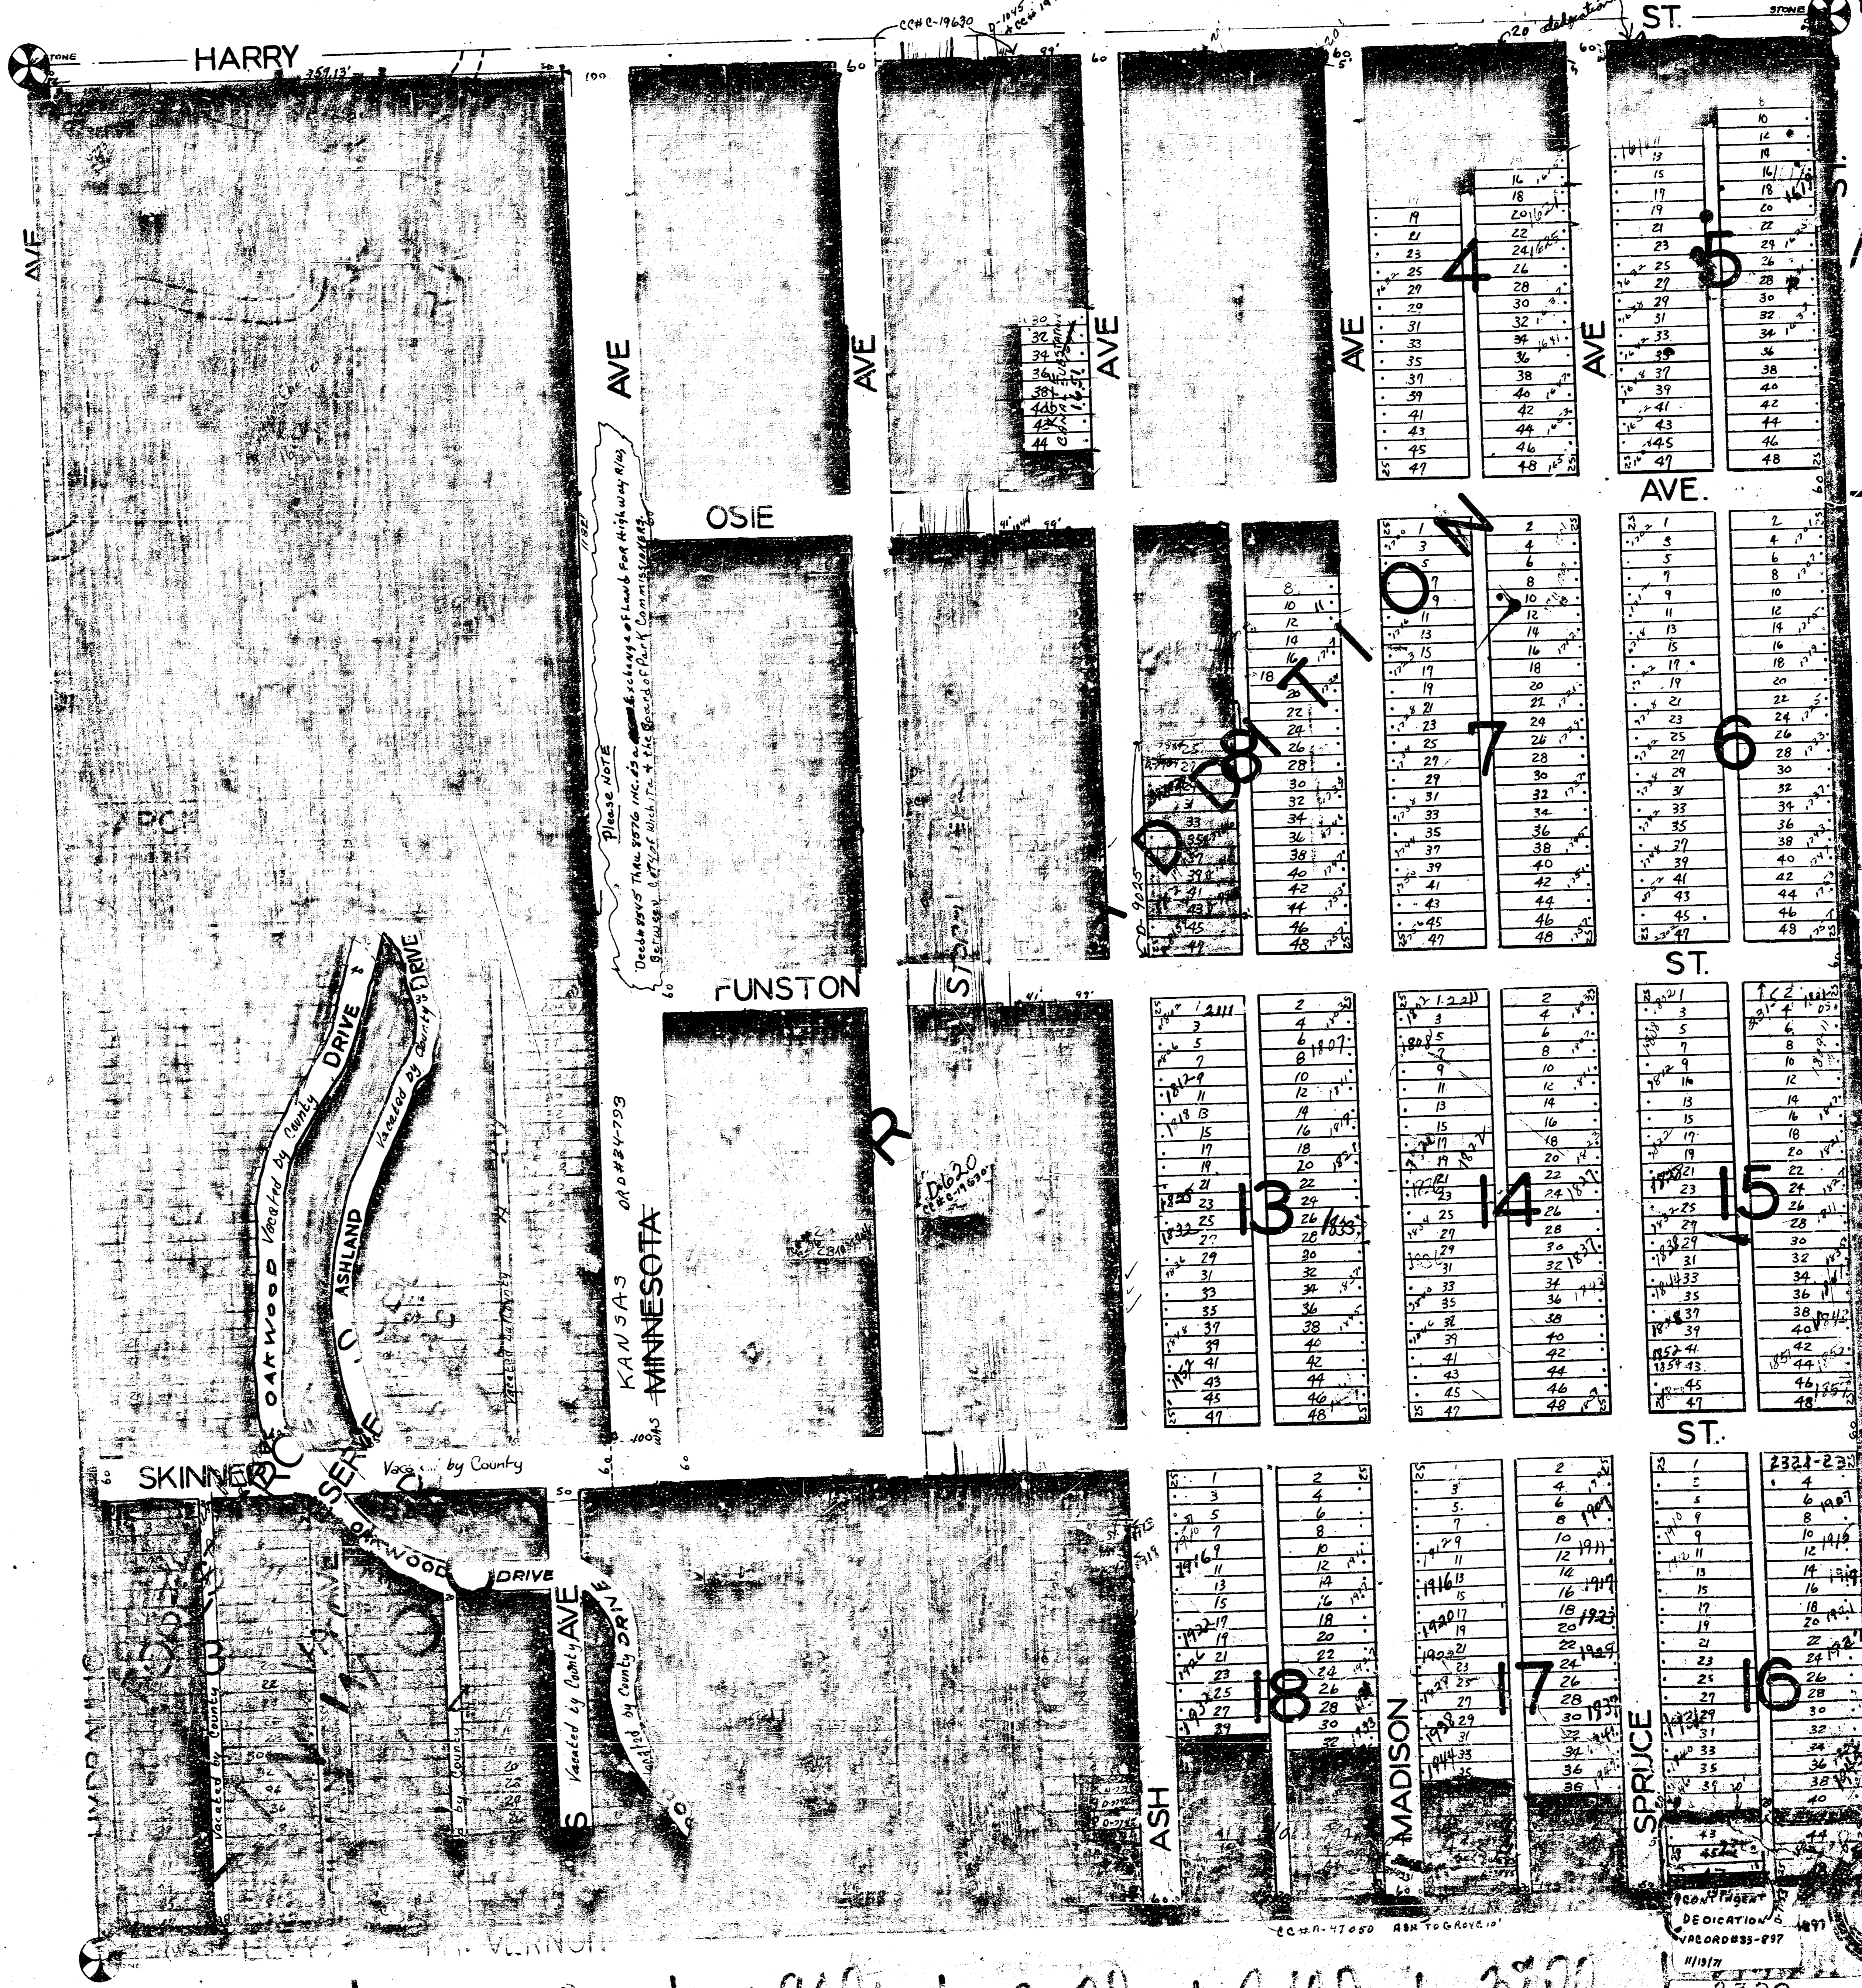

1700 1800 1900 2000 2100 2200 2300