


S.W. 1/4 SEC. 32, TWP. 27 S., R. 1 E.

2-42
8-66

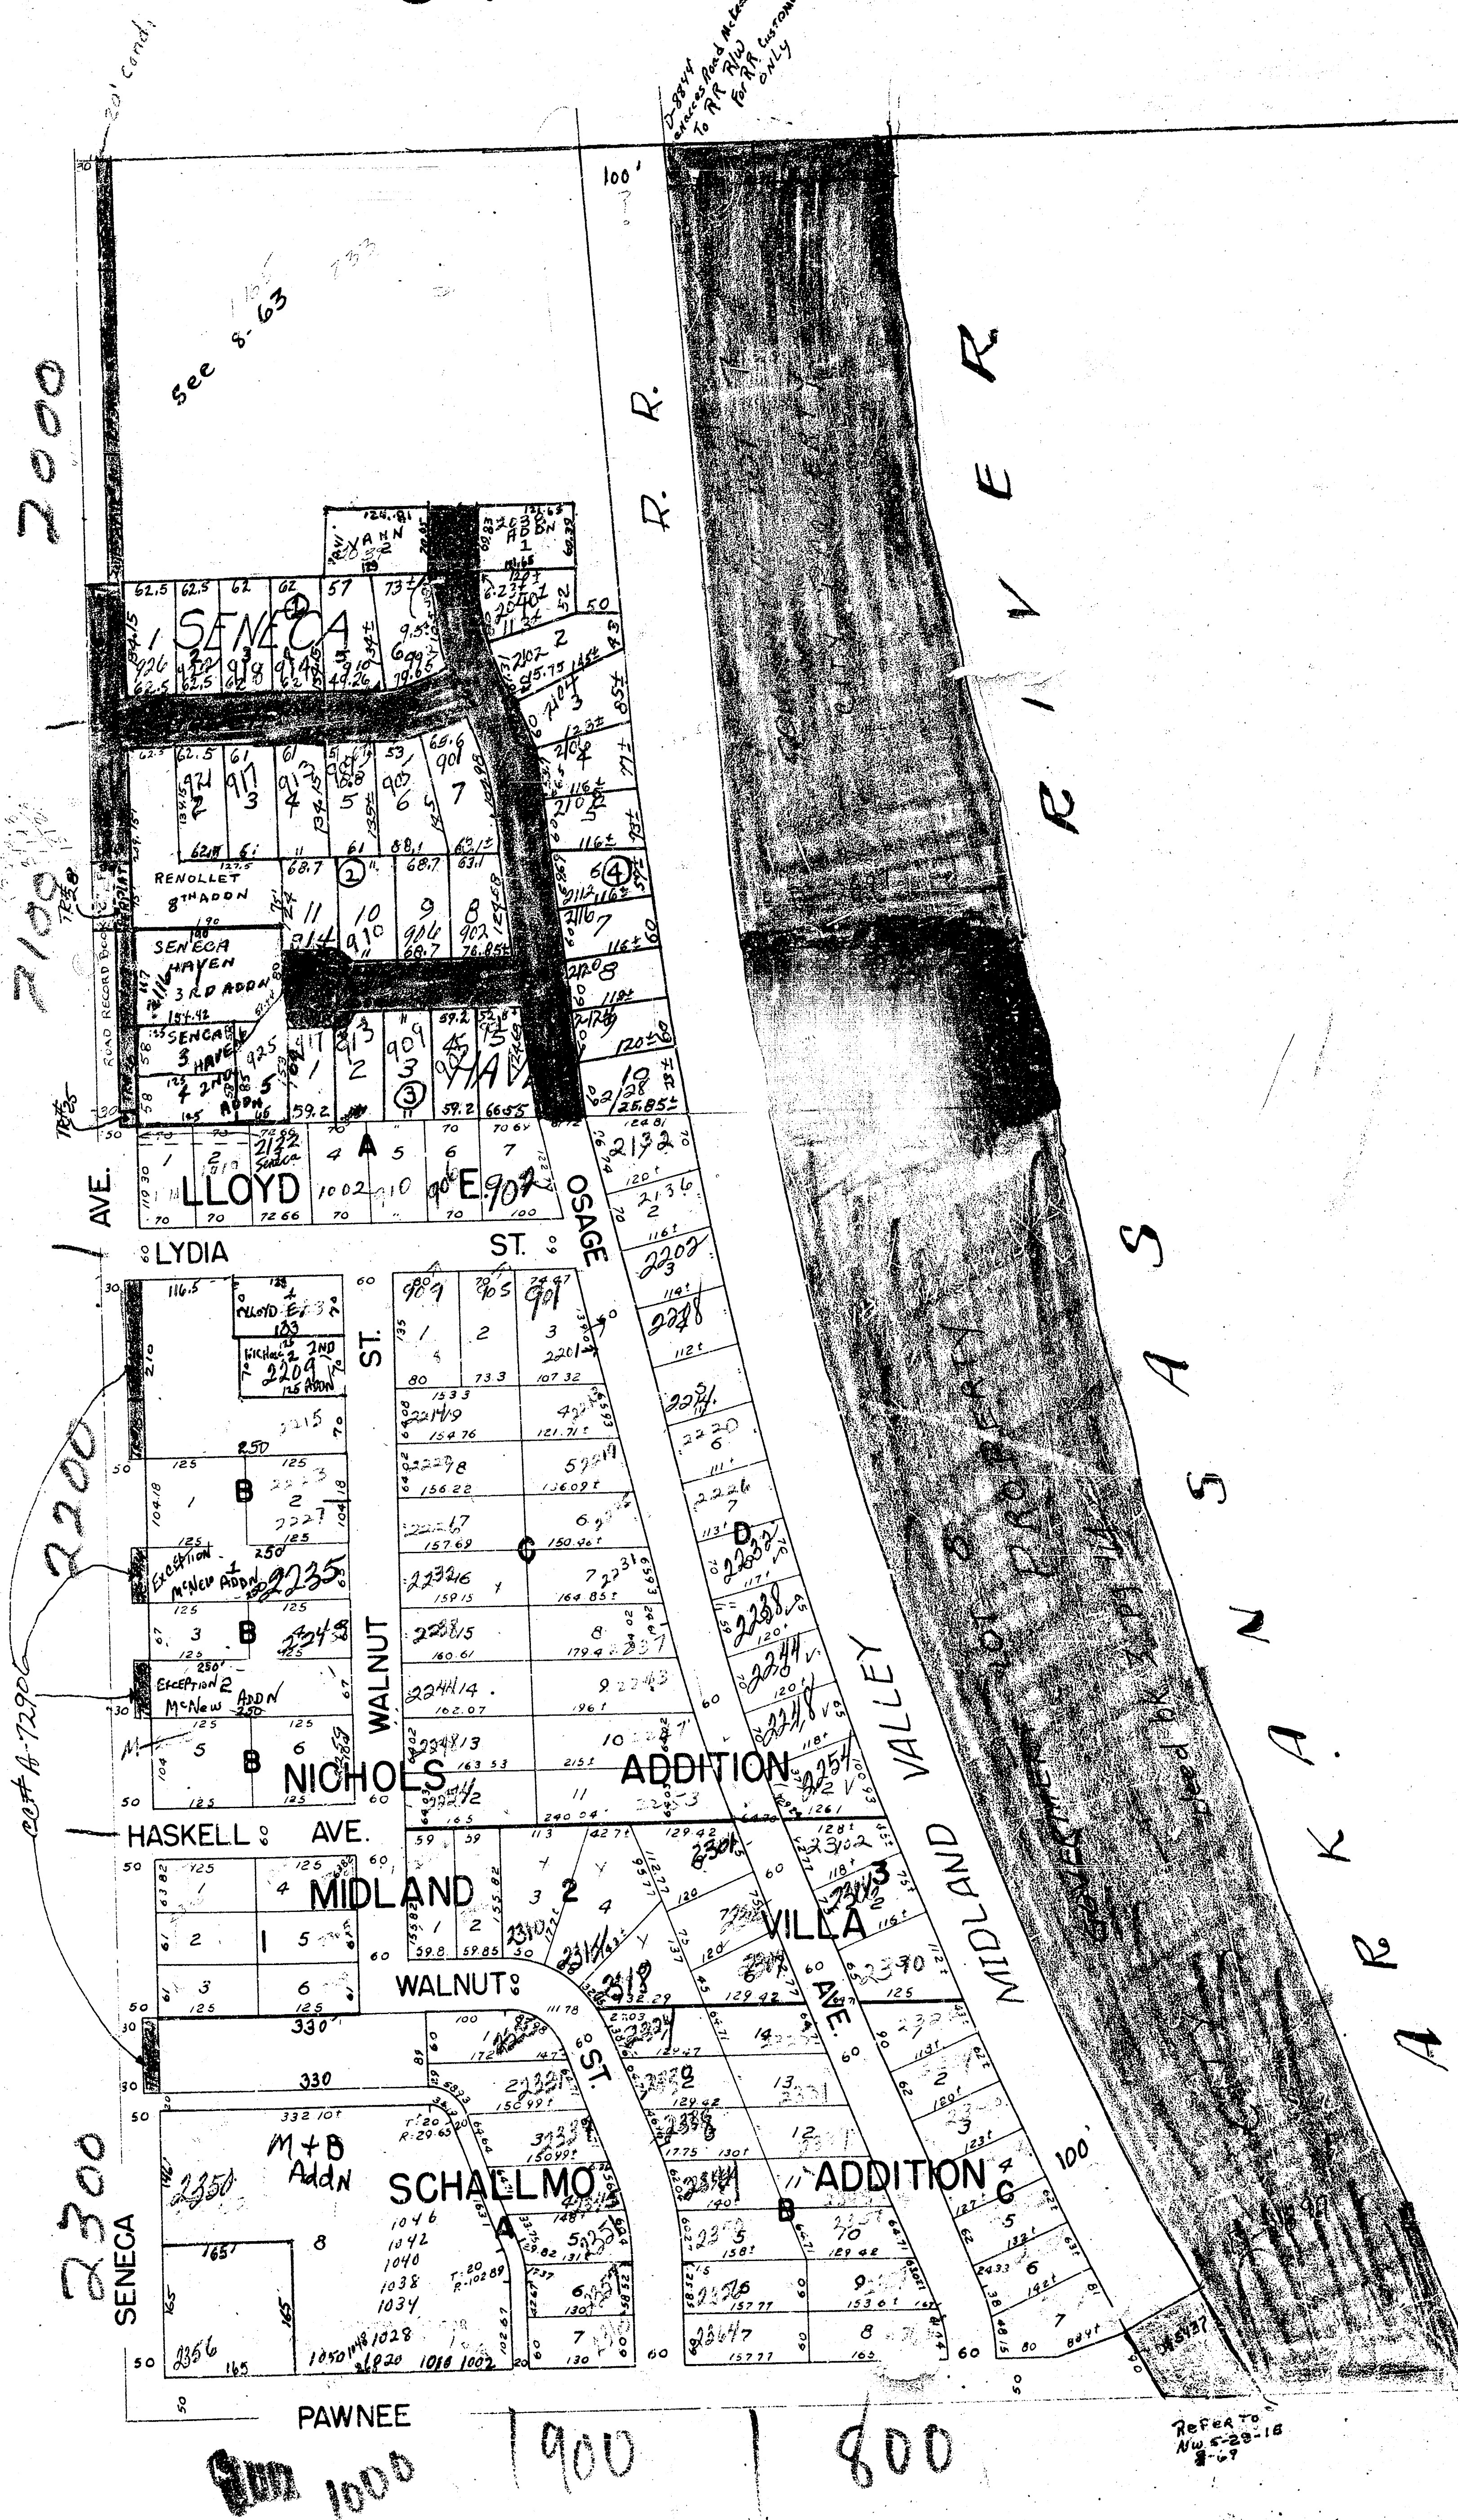

SEE PLAT BOOK 9-64