

8-75


1000 1 N.W. 1/4 900 1 SEC. 8 800 TWP. 28 S. 700 RIE. 600 1 500

3200

3300

3400

3500

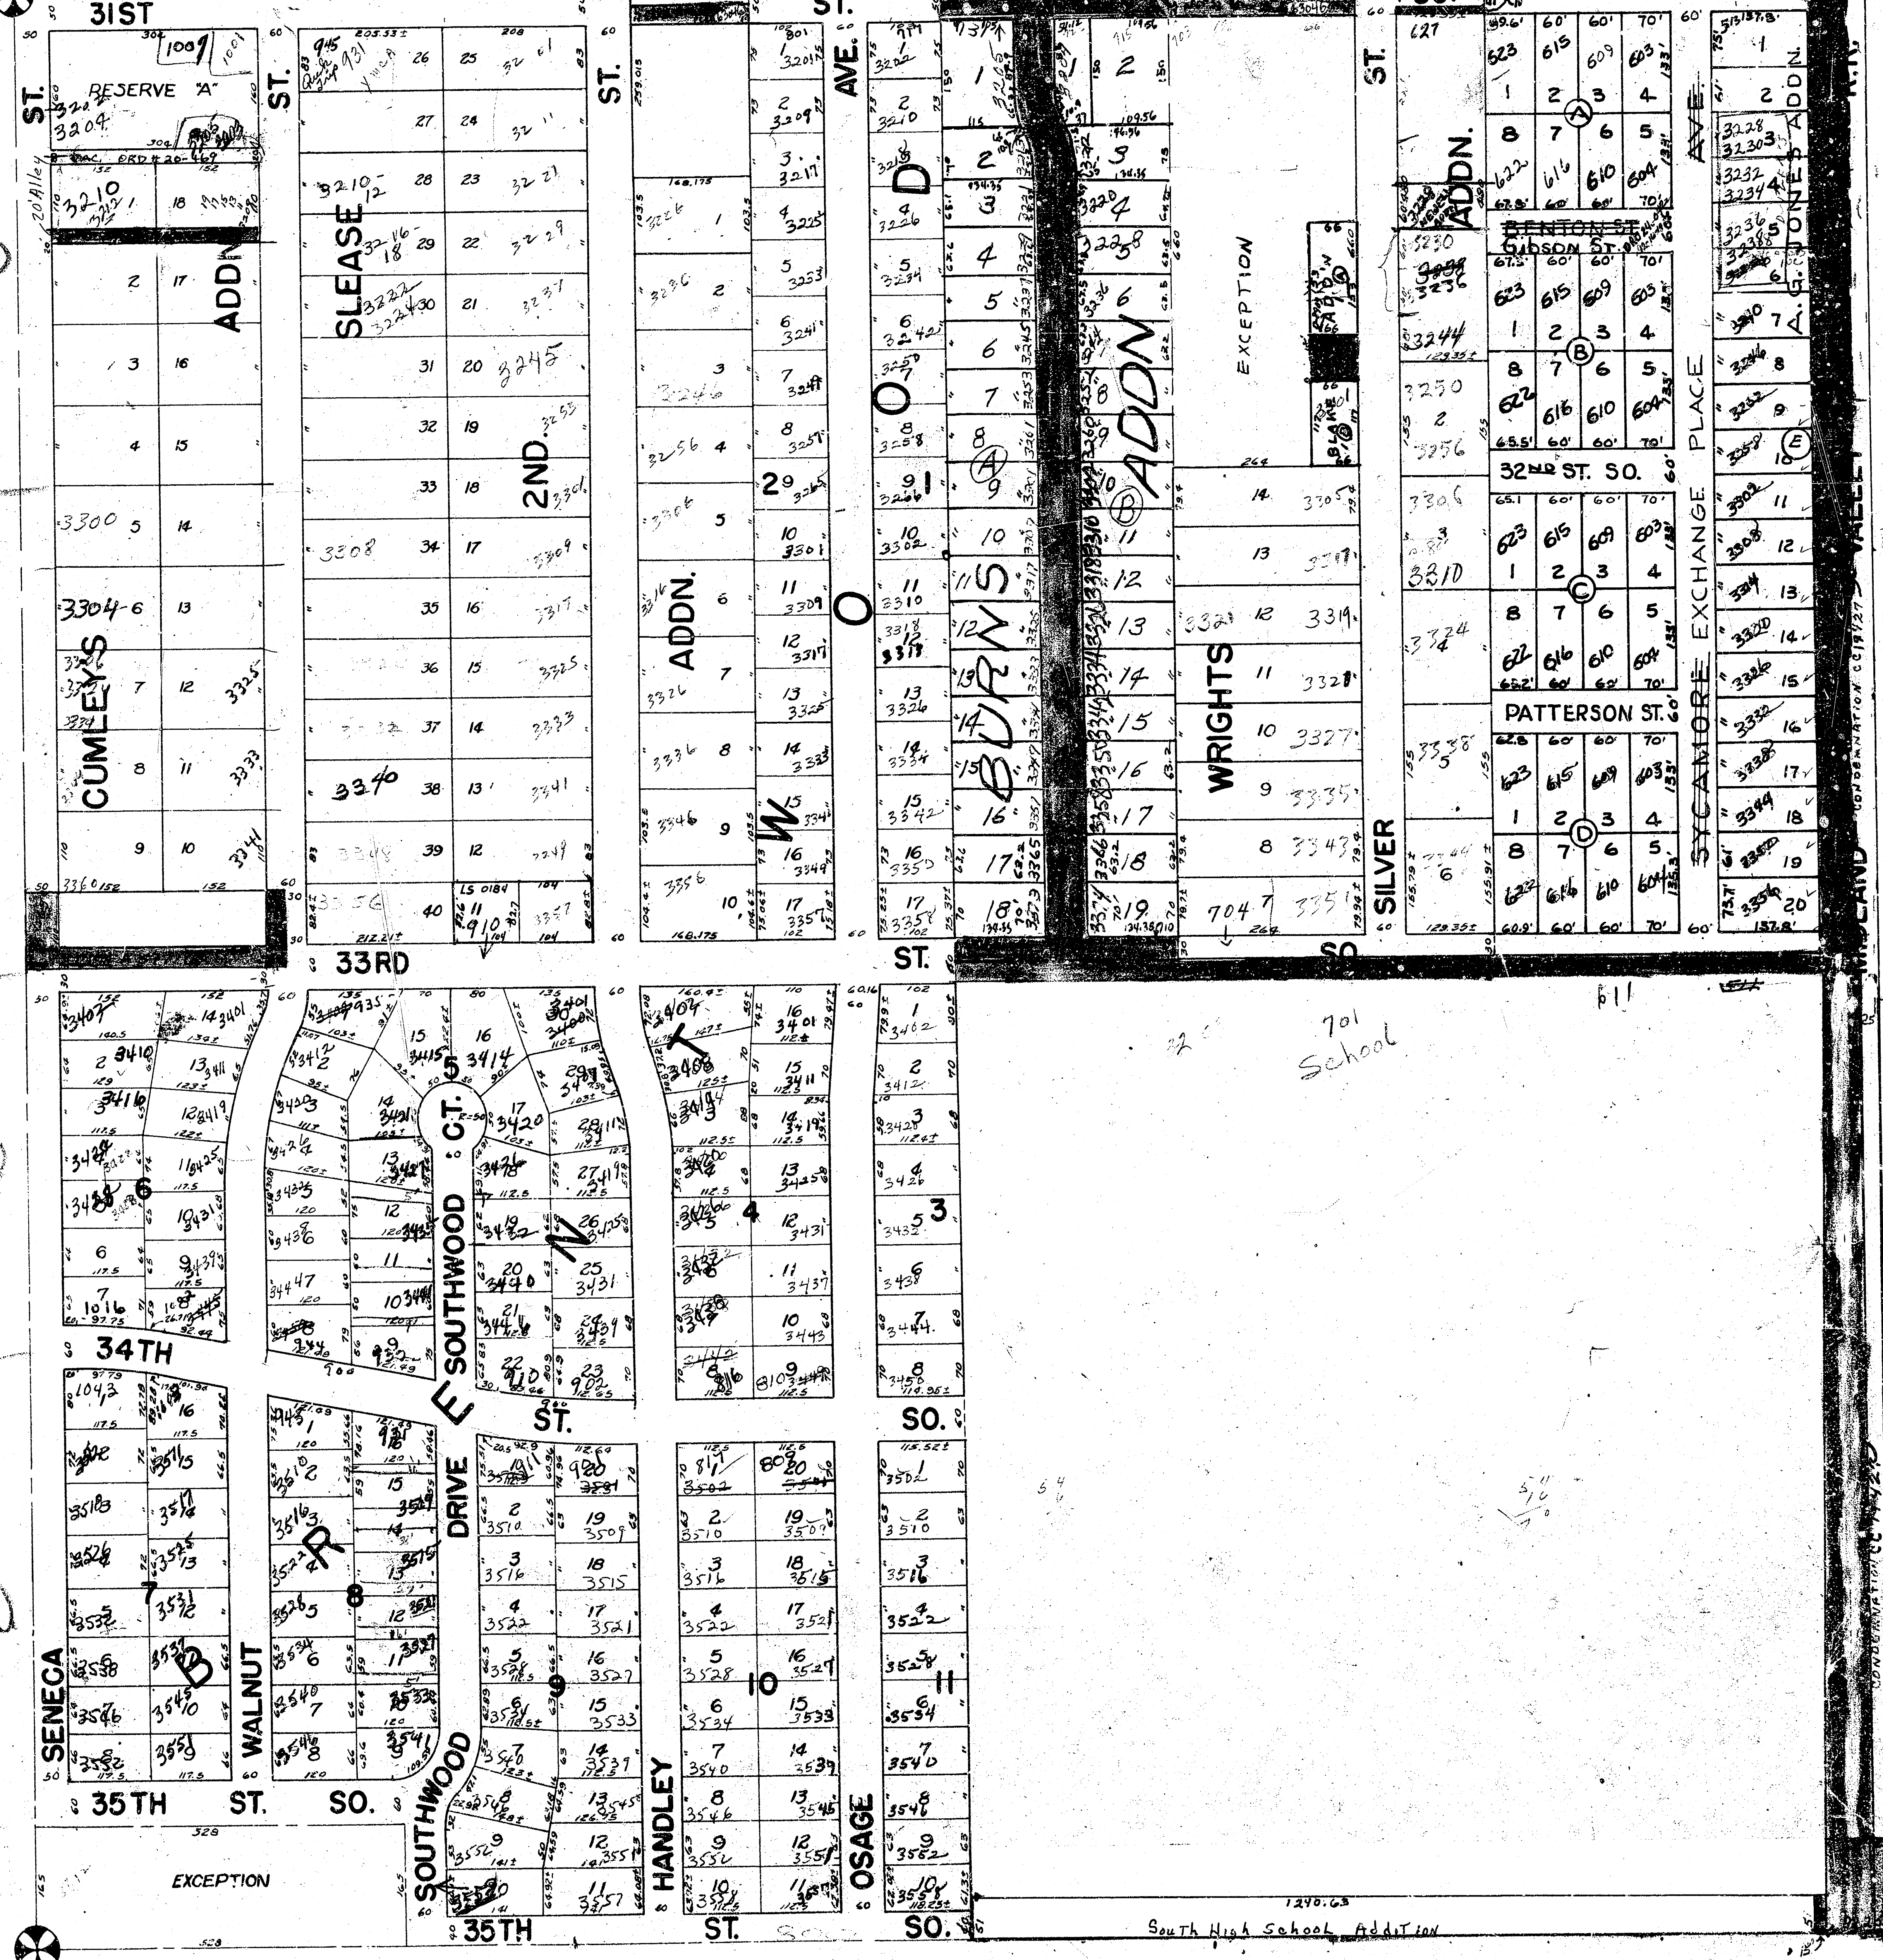


Mid-Valley R.R. crossing agreement in 1/2 sec. file

South High School Addition