9-31
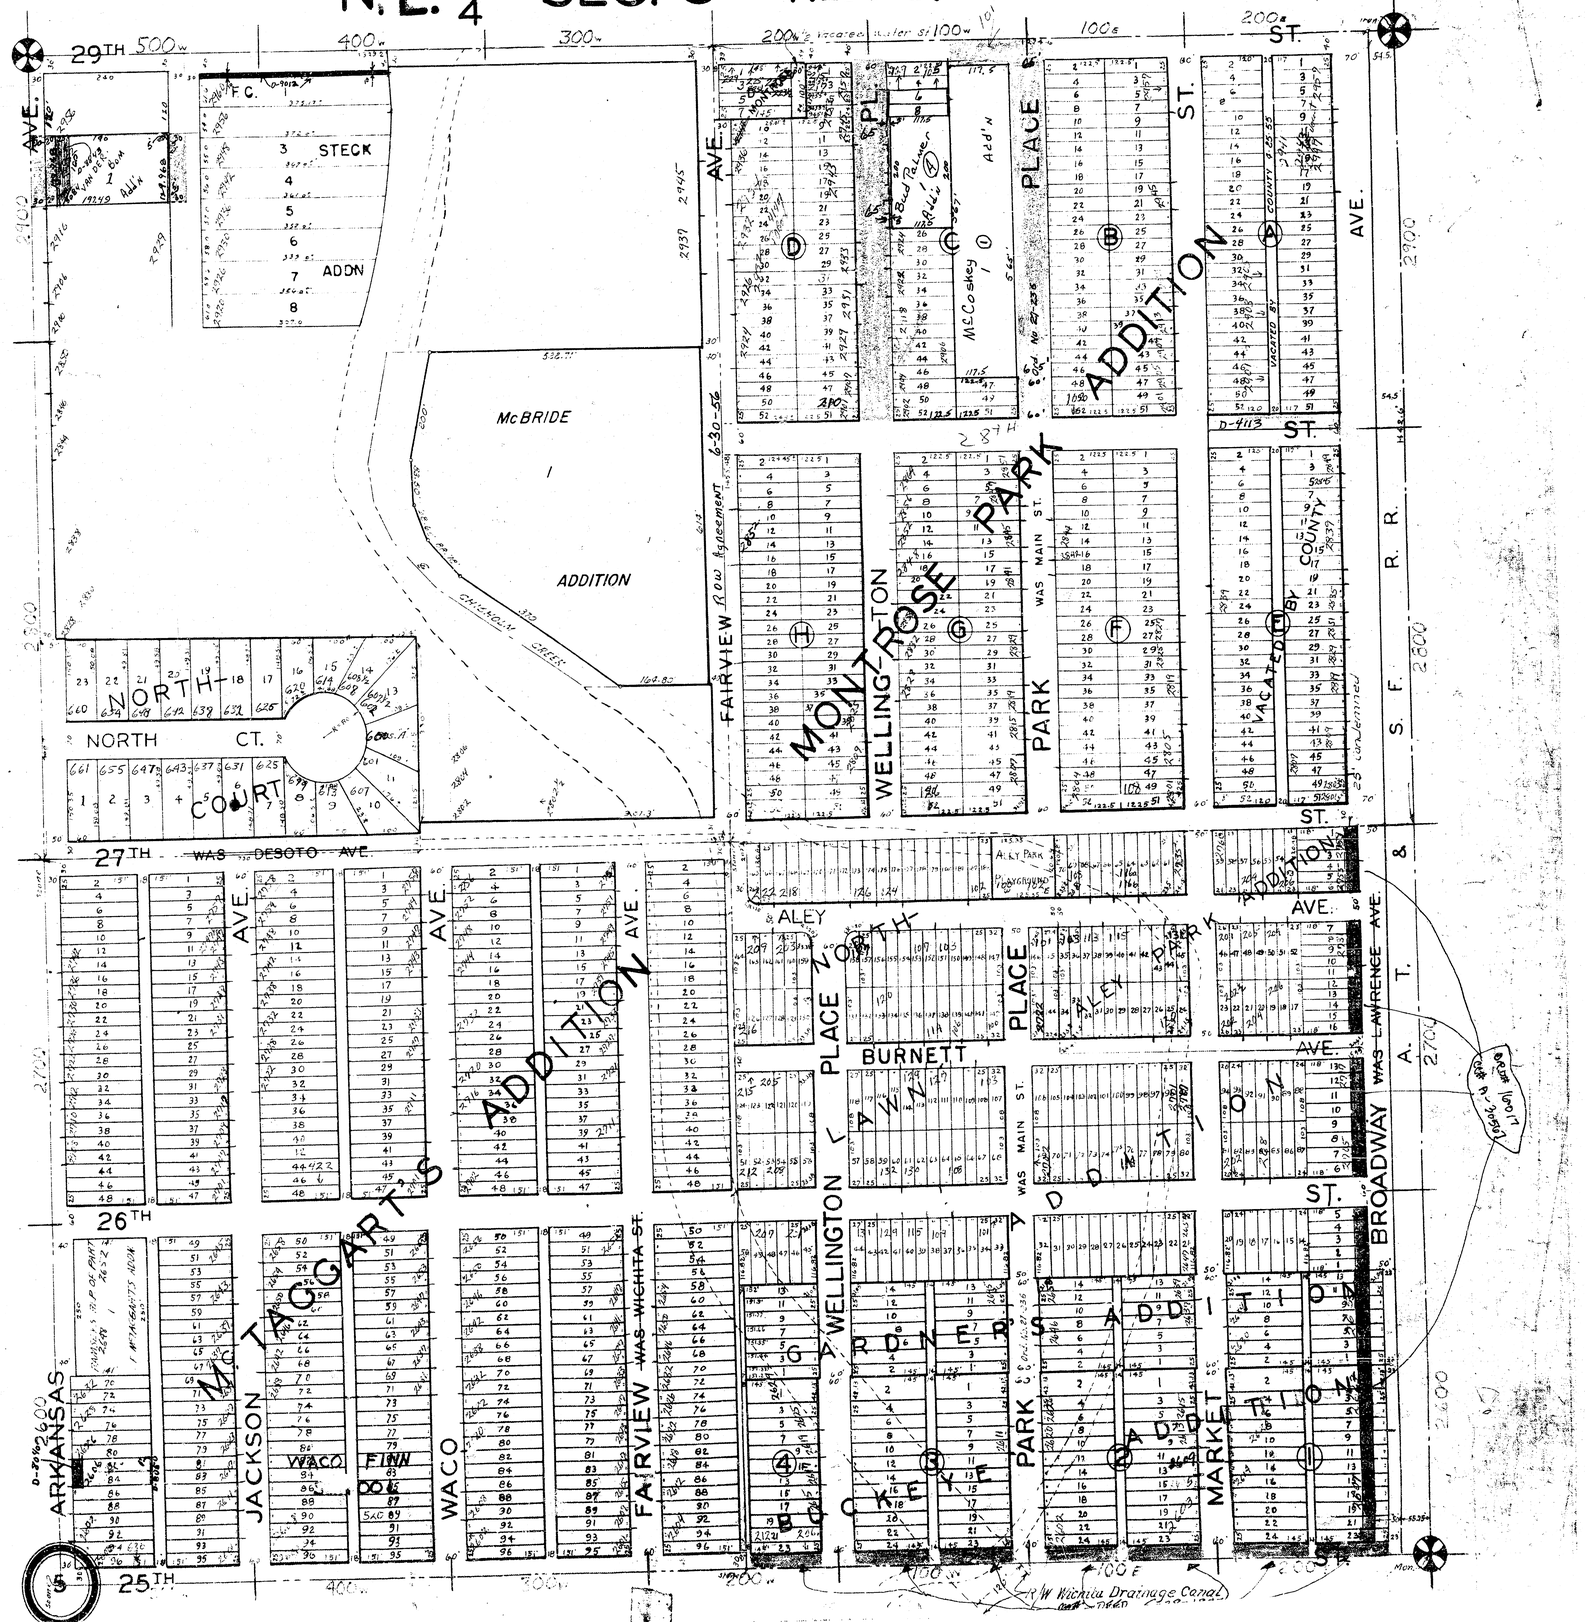
N.E. 1/4 SEC. 5 T.27S. R.1E.