


N.W. 1/4 SEC. 9 T. 27S. R. 1E.

9-38

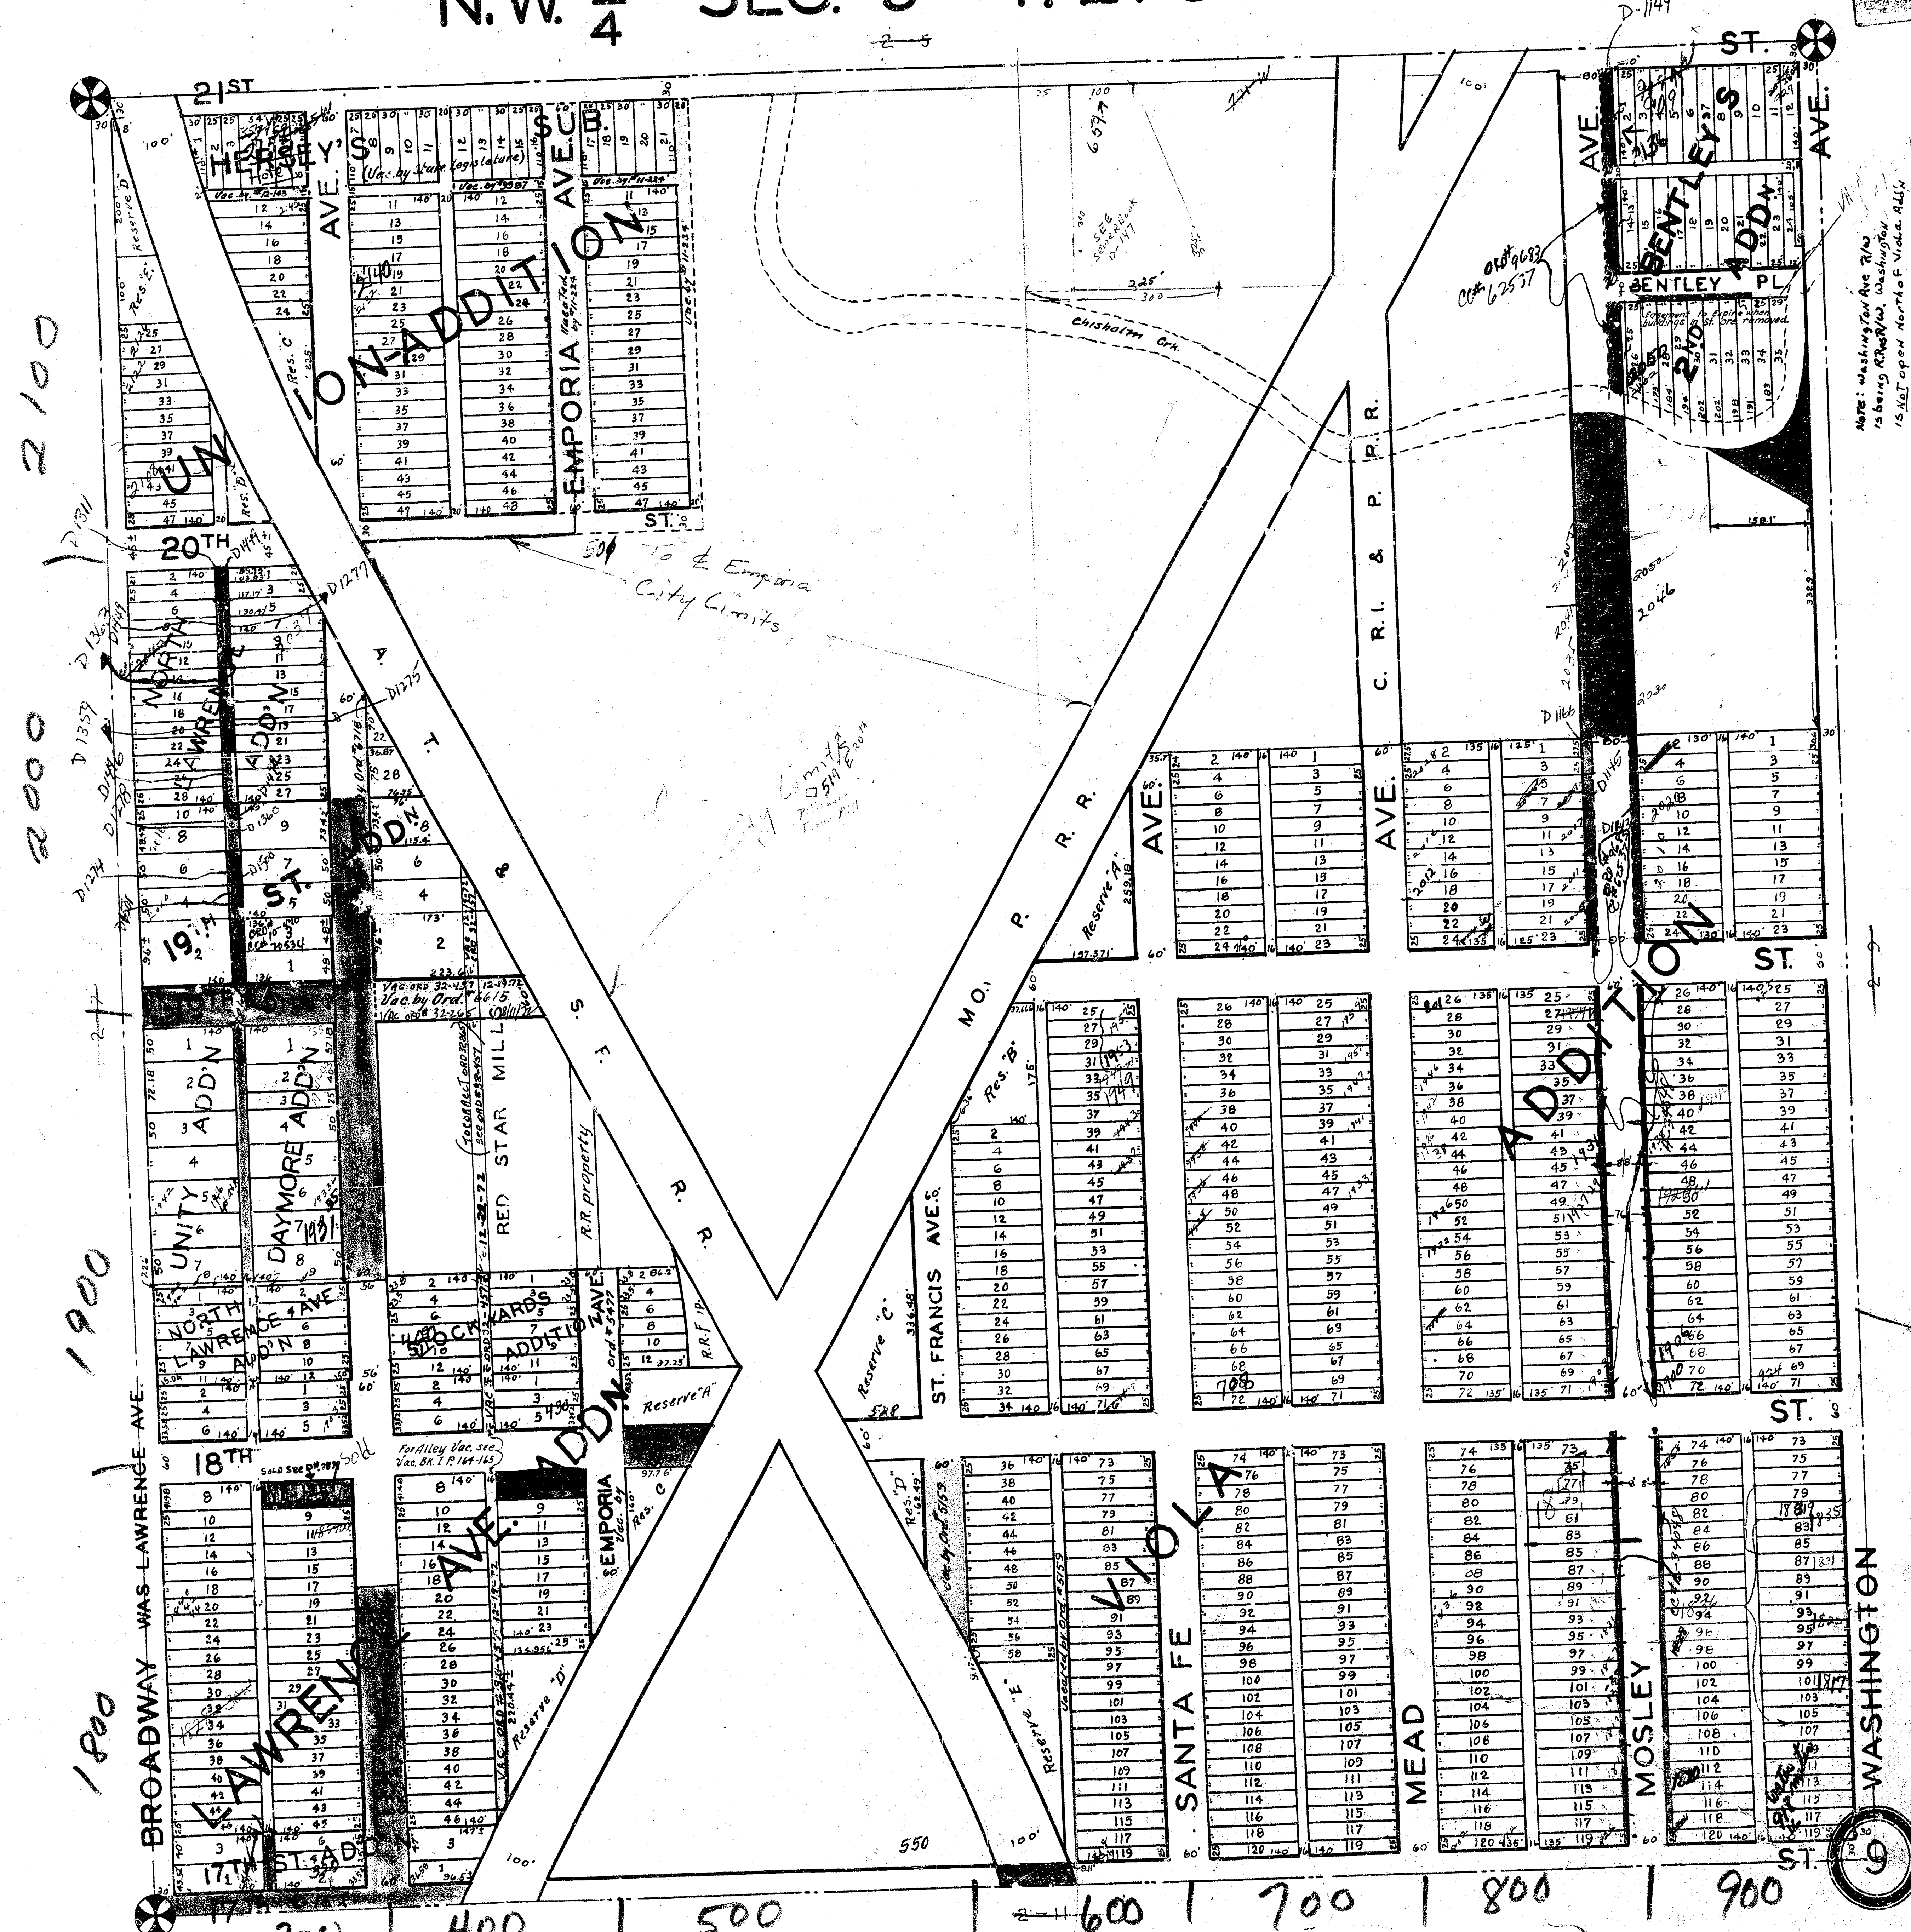

NOTE: 300 400 500 600 700 800 900 For Opp 17th St. to E.L. Bldg. to E.L. R.R. See Corrid. BK. 1 - P. 53.